
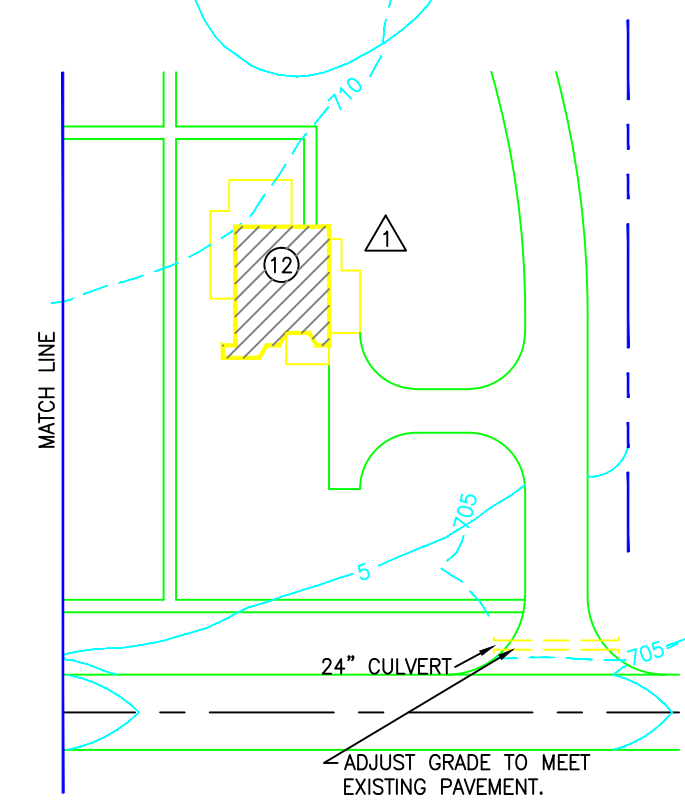


- BUILDING SCHEDULE**
- 1 ADMINISTRATION BUILDING
 - 2 G. M. AND S. BUILDING
 - 3 ADMISSIONS BUILDING
 - 4 ADMISSIONS BUILDING SPECIAL
 - 5 CENTRAL CAFETERIA & KITCHEN
 - 6 RECREATION BUILDING
 - 7 O.T. BUILDING
 - 8 CONTINUED TREATMENT BLDG (FUT.)
 - 9 CONTINUED TREATMENT BLDG (FUT.)
 - 10 DISTURBED BUILDING
 - 11 INFIRM BUILDING
 - 12 MANAGER'S RESIDENCE
 - 13 APARTMENT BUILDING
 - 14 DUPLEX QUARTERS
 - 15 ATTENDANTS BUILDING
 - 16 LAUNDRY
 - 17 WAREHOUSE-GARAGE
 - 18 BOILER HOUSE
 - 19 CHAPEL
 - 20 0.25 M.G. ELEVATED STEEL TANK
 - 21 T.B.-N.P. BUILDING (FUTURE)

- LEGEND**
- MANHOLE AND NUMBER
 - ROOF LEADER CONNECTIONS
 - CATCH BASIN-CURB INLET
 - CATCH BASIN-DROP INLET
 - CULVERT AND HEADWALL

NOTE:
ALL CATCH BASINS TO BE CURB INLET OR TYPE: UNLESS NOTED IN PLANE SEE SHEET 10
CONTRACTOR TO VERIFY EXISTING CONDITIONS DUE TO DURATION OF TIME SINCE LAST AS-BUILT WAS DONE AND SEVERAL WORKS OVER YEARS HAVE BEEN DONE SO INFORMATION MIGHT NOT BE CORRECT.

GRAPHIC SCALE

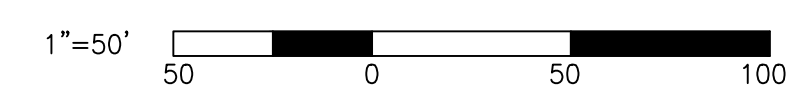

DESIGNED BY WALTER HOOK & ASSOCIATES, INC. W. H. HOOK & ASSOCIATES, INC. 1601 BRENNER AVE. SALISBURY, NC 28144	DATE 5/24/2012	AS BUILT RELOCATION OF BLDG. 12, 14C, & 14E BY VET. ADM. CO. DESCRIPTION	BY JL
PROJECT NO. 659-12-248	SCALE 1"=50'	DATE DEC. 9, 1949	BY JL

Revision	Date	RECOMMEND APPROVAL				Drawing Title AS-BUILT-GRADING AND DRAINAGE PLAN	Project Title ASPHALT PAVING & REPAIR	Date 28 MAR 2012	Project No. 659-12-248	DRAWING NO. AS-S-101	DWG. 7 OF 8
		REQUESTER	Date	CHIEF OF SERVICE	Date						
		ASSOC. DIR. PATIENT CARE SVC.	Date	ASSOC. DIR. for OPERATIONS	Date						
		APPROVAL BY:	Date	MEDICAL CENTER DIRECTOR							
Approved: Safety Manager/M&O Supervisor						Building Number CAMPUS	Checked BLF	Location W.G.(BUI) Hefner Medical Center 1601 Brenner Ave Salisbury NC 28144			



Department of
Veterans Affairs