


- BUILDING SCHEDULE**
- 1 ADMINISTRATION BUILDING
  - 2 G. M. AND S. BUILDING
  - 3 ADMISSIONS BUILDING
  - 4 ADMISSIONS BUILDING SPECIAL
  - 5 CENTRAL CAFETERIA & KITCHEN
  - 6 RECREATION BUILDING
  - 7 O.T. BUILDING
  - 8 CONTINUED TREATMENT BLDG (FUT.)
  - 9 CONTINUED TREATMENT BLDG (FUT.)
  - 10 DISTURBED BUILDING
  - 11 INFIRM BUILDING
  - 12 MANAGER'S RESIDENCE
  - 13 APARTMENT BUILDING
  - 14 DUPLEX QUARTERS
  - 15 ATTENDANTS' BUILDING
  - 16 LAUNDRY
  - 17 WAREHOUSE-GARAGE
  - 18 BOILER HOUSE
  - 19 CHAPEL
  - 20 0.25 M.G. ELEVATED STEEL TANK.
  - 21 T.B.-N.P. BUILDING (FUTURE)

- LEGEND**
- MANHOLE AND NUMBER
  - ROOF LEADER CONNECTIONS
  - CATCH BASIN-CURB INLET
  - CATCH BASIN-DROP INLET
  - CULVERT AND HEADWALL

**NOTE:**  
ALL CATCH BASINS TO BE CURB INLET OR TYPE, UNLESS NOTED IN PLANE SEE SHEET 10.  
CONTRACTOR TO VERIFY EXISTING CONDITIONS DUE TO DURATION OF TIME SINCE LAST AS-BUILT WAS DONE, AND SEVERAL WORKS OVER YEARS HAVE BEEN DONE SO, INFORMATION MIGHT NOT BE CORRECT.

**GRAPHIC SCALE**

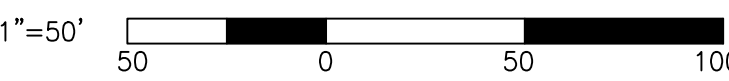

PROJECT	NO. 659-12-248	DATE	2/2/1999	AS BUILT	RELOCATION OF BLDG. 12, 14C & 14E BY VET. ADM. CO.
DESIGNED BY	WALTER BROS. & ASSOCIATES, INC.	DATE	5/4/1993	DESCRIPTION	
DRAWN BY	W. BROS. & ASSOCIATES, INC.	DATE	5/4/1993	DESCRIPTION	
CHECKED BY	W. BROS. & ASSOCIATES, INC.	DATE	5/4/1993	DESCRIPTION	
APPROVED BY	W. BROS. & ASSOCIATES, INC.	DATE	5/4/1993	DESCRIPTION	
PROJECT	NO. 659-12-248	DATE	2/2/1999	AS BUILT	RELOCATION OF BLDG. 12, 14C & 14E BY VET. ADM. CO.
DESIGNED BY	WALTER BROS. & ASSOCIATES, INC.	DATE	5/4/1993	DESCRIPTION	
DRAWN BY	W. BROS. & ASSOCIATES, INC.	DATE	5/4/1993	DESCRIPTION	
CHECKED BY	W. BROS. & ASSOCIATES, INC.	DATE	5/4/1993	DESCRIPTION	
APPROVED BY	W. BROS. & ASSOCIATES, INC.	DATE	5/4/1993	DESCRIPTION	

Revision		Date																																	
<div>RECOMMEND APPROVAL</div> <table><tr><td>REQUESTER</td><td>Date</td><td>CHIEF OF SERVICE</td><td>Date</td><td>CHIEF OF STAFF</td><td>Date</td></tr><tr><td>ASSOC. DIR. PATIENT CARE SVC.</td><td>Date</td><td>ASSOC. DIR. for OPERATIONS</td><td>Date</td><td></td><td>Date</td></tr><tr><td colspan="3">APPROVAL BY:</td><td colspan="3">Date</td></tr><tr><td colspan="3">MEDICAL CENTER DIRECTOR</td><td colspan="3"></td></tr></table>				REQUESTER	Date	CHIEF OF SERVICE	Date	CHIEF OF STAFF	Date	ASSOC. DIR. PATIENT CARE SVC.	Date	ASSOC. DIR. for OPERATIONS	Date		Date	APPROVAL BY:			Date			MEDICAL CENTER DIRECTOR						<div>Drawing Title</div> <div>AS-BUILT-GRADING AND DRAINAGE PLAN</div> <div>Approved: Safety Manager/M&amp;O Supervisor</div> <div>Approved: Chief of Facilities Management Svr.</div>		<div>Project Title</div> <div>ASPHALT PAVING &amp; REPAIR</div> <div>Building Number</div> <div>CAMPUS</div> <div>Checked</div> <div>Drawn</div> <div>BUF</div> <div>Location</div> <div>W.G.(BU) Hefner Medical Center 1601 Brenner Ave. Salisbury NC 28144</div>		<div>Date</div> <div>28 MAR 2012</div> <div>Project No.</div> <div>659-12-248</div> <div>DRAWING NO.</div> <div>AS-5-101</div> <div>DWG. 7 OF 8</div>		<div>Department of Veterans Affairs</div>	
REQUESTER	Date	CHIEF OF SERVICE	Date	CHIEF OF STAFF	Date																														
ASSOC. DIR. PATIENT CARE SVC.	Date	ASSOC. DIR. for OPERATIONS	Date		Date																														
APPROVAL BY:			Date																																
MEDICAL CENTER DIRECTOR																																			