


GRAPHIC SCALES

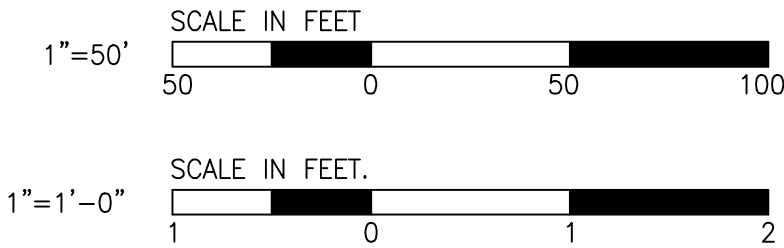

NOTE:
AS BUILT DATA RECEIVED WITH
STATION LETTER DATED-7-20-55
CONTRACTOR TO VERIFY EXISTING CONDITIONS DUE TO
DURATION OF TIME SINCE LAST AS-BUILT WAS DONE
AND SEVERAL WORKS OVER YEARS HAVE BE DONE SO,
INFORMATION MIGHT NOT BE CORRECT.

CATCH BASIN DATA.					
NO.	TOP ELEV.	INV. ELEV.	NO.	TOP ELEV.	INV. ELEV.
1	719.73	715.02	61	707.54	702.71
2	720.18	706.04	62	699.81	687.11
3	716.02	711.50	63	699.74	695.24
4	716.02	706.25	64	699.74	694.79
5	718.38	705.45	65	708.38	704.08
6	718.28	705.74	66	709.73	699.80
7	717.30	713.00	67	715.04	710.50
8	717.30	712.71	68	715.54	710.23
9	713.58	712.00	69	709.00	704.75
10	711.53	707.20	70	708.75	704.50
11	714.25	710.00	71	708.75	704.23
12	708.30	704.29	72	703.87	699.24
13	716.06	711.23	73	703.87	699.37
14	716.06	711.50	74	695.25	690.00
15	717.67	705.23	75	692.50	687.40
16	717.67	705.50	76	692.50	688.50
17	717.47	713.00	77	706.25	696.94
18	709.14	704.70	78	715.50	711.00
19	709.14	704.41	79	715.50	711.00
20	703.00	698.50	80	709.00	705.00
21	703.00	698.21	81	709.00	704.50
22	698.93	694.40	82	720.00	707.00
23	698.93	694.11	83	720.00	707.00
24	695.44	677.81	84	711.34	708.10
25	695.44	677.23	85	711.34	708.25
26	703.26	690.90	86	711.65	708.50
27	703.26	691.50	87	711.65	708.65
28	702.25	697.34	50A	704.25	700.18
29	702.25	698.00			
30	696.28	691.75			
31	701.91	697.40			
32	701.91	697.10			
33	NONE				
34	NONE				
35	NONE				
36	707.04	695.95			
37	707.04	695.69			
38	704.88	695.67			
39	704.98	696.18			
40	704.60	699.87			
41	704.50	698.43			
42	704.05	699.55			
43	703.93	698.35			
44	698.96	694.46			
45	698.96	693.88			
46	694.00	687.00			
47	694.00	685.30-684.05			
48	704.55	699.55			
49	704.55	699.30			
50	704.25	700.46			
51	713.66	715.00			
52	718.70	706.04			
53	717.33	713.00			
54	717.33	712.42			
55	715.50	704.00			
56	716.50	704.15			
57	715.50	703.30			
58	714.43	703.34			
59	714.43	703.92			
60	707.54	703.00			

MANHOLE DATA.			
NO.	TOP ELEV.	ELEV. IN	ELEV. OUT.
1	719.0	713.52	706.90
2	719.0	704.90	704.39
3	718.5	713.59	702.59
4	717.8	701.75	701.58
5	676.0	672.85	672.85
6	712.5	700.00-701.47	698.70
7	713.5	704.11	704.11
8	713.8	703.15-703.45	702.75
9	717.5	705.00	703.88
10	711.5	697.50	697.50
11	709.8	695.38	694.73
12	706.8	691.99	691.99
13	705.0	683.95	689.95
14	701.3	685.75	685.75
14A	NONE		
15	698.5	682.29	682.24
16	696.5	678.86	678.31
17	703.5	696.52	696.42
18	695.5	677.01-684.12	675.12
19	696.8	686.80	686.80
20	702.0	691.36	690.70
21	709.0	694.24	693.73
22	707.0	695.28	695.03
23	719.0	713.50	706.77
24	718.3	704.67	704.11
25	717.5	702.46	701.66
26	718.2	700.01	700.01
27	NONE		
28	714.5	697.77	696.84
29	710.3	695.89-696.19	694.19
30	NONE		
31	711.3	698.15-698.71	697.72
32	711.0	698.89	698.47
33	715.0	700.16	699.70
34	720.0	704.27	701.15
35	NONE		
36	697.0	685.71	685.71
37	692.0	682.49	677.14
38	708.5	696.24	696.24
39	702.5	685.03	685.03
40	673.50	664.20	664.20
41	704.64	700.08	699.98
42	700.5	693.88	691.88
43	707.00	701.20	701.00
8-A	713.6	702.56	702.16

"AS BUILT"			
NO.	DATE	AS BUILT	BY
1	8/20/04	AS BUILT	BY
REVISION		DATE	DESCRIPTION
1		8/20/04	AS BUILT
2		8/20/04	AS BUILT
3		8/20/04	AS BUILT
Revision		Date		RECOMMEND APPROVAL				Drawing Title		Project Title		Date				Department of Veterans Affairs	
				REQUESTER		Date		AS-BUILT-GRADING AND DRAINAGE PLAN		ASPHALT PAVING & REPAIR		28 MAR 2012					
				CHIEF OF SERVICE		Date		CHIEF OF STAFF		Date		Project No. 659-12-248					
				ASSOC. DIR. PATIENT CARE SVC.		Date		ASSOC. DIR. for OPERATIONS		Date		DRAWING NO. AS-5-102					
APPROVAL BY:				Date				Approved: Safety Manager/M&O Supervisor		Building Number		Checked		Drawn		DWG. 8 OF 8	
MEDICAL CENTER DIRECTOR								Approved:Chief of Facilities Management Svr.		CAMPUS		BLF					
										Location		W.G.(BII) Hefner Medical Center					
										1601 Brenner Ave.							
										Salisbury NC 28144							