


SEE SHEET C-312

SEE SHEET C-314

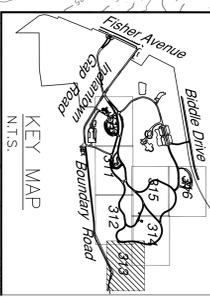


GENERAL NOTES

1. EXISTING CONDITIONS BASED UPON SURVEY BY L. ROBERT KIMBALL & ASSOCIATES, DATED MAY 9, 2011.
2. DATE OF AERIAL PHOTOGRAPHY: MARCH 17, 2010. CONTRACTOR SHALL INSPECT AND VERIFY ALL FIELD DIMENSIONS AND SITE CONDITIONS SHOWN HEREIN BEFORE PROCEEDING WITH THE WORK. DISCREPANCIES BETWEEN FIELD CONDITIONS AND THESE PLANS SHALL BE BROUGHT TO THE DEPARTMENT OF VETERANS AFFAIRS RESIDENT ENGINEER'S ATTENTION PRIOR TO ANY COMMENCEMENT OF THE WORK. ONCE CONSTRUCTION HAS BEGUN CONTRACTOR SHALL NOT USE FIELD INFORMATION DISCREPANCIES AS THE BASIS FOR CHANGE THE LOCATIONS OF EXISTING UNDERGROUND UTILITIES ARE SHOWN IN AN APPROXIMATE WAY ONLY AND HAVE NOT BEEN INDEPENDENTLY VERIFIED. THE CONTRACTOR SHALL DETERMINE THE EXACT LOCATION OF ALL EXISTING UTILITIES BEFORE COMMENCING WORK, AND AGREES TO BE FULLY RESPONSIBLE FOR ANY AND ALL DAMAGES WHICH MIGHT BE OCCASIONED BY THE CONTRACTOR'S FAILURE TO EXACTLY LOCATE AND PRESERVE ANY AND ALL UNDERGROUND UTILITIES. CONTRACTOR SHALL COMPLY WITH "PENNSYLVANIA ONE CALL" REQUIREMENTS.
3. THE LOCATIONS OF EXISTING UNDERGROUND UTILITIES ARE SHOWN IN AN APPROXIMATE WAY ONLY AND HAVE NOT BEEN INDEPENDENTLY VERIFIED. THE CONTRACTOR SHALL DETERMINE THE EXACT LOCATION OF ALL EXISTING UTILITIES BEFORE COMMENCING WORK, AND AGREES TO BE FULLY RESPONSIBLE FOR ANY AND ALL DAMAGES WHICH MIGHT BE OCCASIONED BY THE CONTRACTOR'S FAILURE TO EXACTLY LOCATE AND PRESERVE ANY AND ALL UNDERGROUND UTILITIES. CONTRACTOR SHALL COMPLY WITH "PENNSYLVANIA ONE CALL" REQUIREMENTS.

LEGEND

---	LIMIT OF ADD ALTERNATIVE EARTH DISTURBANCE
---	LIMIT OF BASE BID EARTH DISTURBANCE
---	PROPERTY LINE
---	STREAM CENTERLINE
---	TREE LINE
---	BRUSH LINE
---	EDGE OF ROAD
---	DITCH LINE
---	OVERHEAD LINE
---	NEW BRUSH/TREE LINE
---	CONTOUR LINE
---	NEW CONTOUR LINE
---	NEW MOUNTABLE CONCRETE CURB & GUTTER
---	TREE OR BUSH
---	HEADSTONE
---	FLAAS
---	POST
---	SIGN
---	ELECTRIC, SANITARY OR STORM UTILITY POLE
---	NEW CLEAN OUT
---	NEW INLET
---	NEW MANHOLE
---	NEW FLARED END SECTION
---	SPOT ELEVATION
---	NEW SPOT ELEVATION
---	LOW POINT
---	HIGH POINT
---	FINISHED FLOOR ELEVATION
---	WETLANDS
---	NEW ASPHALT PAVEMENT
---	NEW ASPHALT PAVEMENT OVERLAY

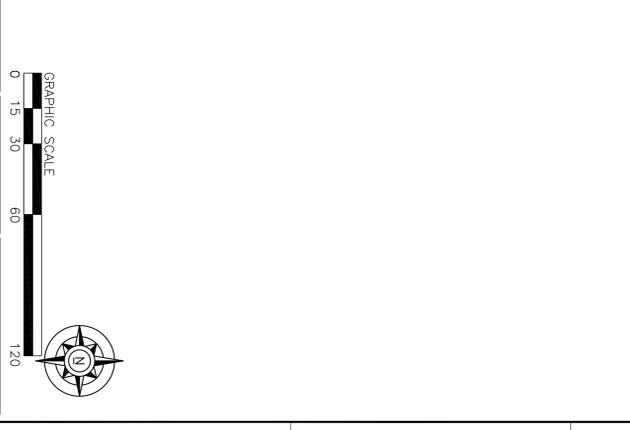

THIS RECORD DRAWING HAS BEEN PREPARED, IN PART, BASED UPON INFORMATION BELIEVED TO BE RELIABLE. THE ENGINEER HAS CONDUCTED VISUAL GENERAL VERIFICATION OF THE INFORMATION THAT MAY HAVE BEEN INCORPORATED INTO IT AS A RESULT OF THE REVISIONS TO THIS RECORD DOCUMENT AND ADVISED TO OBTAIN REVISIONS VERIFICATION OF THIS ACCORDANCE.

RECORD DRAWING

Revisions: 04-14-14

CONSULTANTS:

The LA group
 4010 JERRY RAY
 AND ENGINEERING, INC.
 1000 WEST BROADWAY
 NEWTON, NJ 07860

LR Kimball
 TWO COMMERCE SQUARE
 PHILADELPHIA, PA 19103

Aqua Engineering, Inc.
 4000 WEST BROADWAY
 NEWTON, NJ 07860

A. D. MARBLE & COMPANY
 200 WEST BROADWAY
 PHILADELPHIA, PA 19103

PRIME CONSULTANT:

CLAYTON KATZ INC
 LABORATORY ADMINISTRATION
 PHILADELPHIA, PA 19103
 215 591 3000

NATIONAL CEMETERY ADMINISTRATION

GRADING PLAN
BID ALTERNATE #3

Approved: Project Director

VPD sig.tif

Project Title: PHASE 4 - GRAVESITE DEVELOPMENT & CEMETERY IMPROVEMENTS

Location: LEBANON COUNTY, PENNSYLVANIA

Project Number: 813CM2024

Drawing Reference: 075

Drawing Number: C-313

Office of Construction & Facilities Management

Department of Veterans Affairs