

Drawing Title

Building 60
First Floor— TCU

Project Title

"As Built" Drawing

Date

5/5/99

Project No.

SI-59

Building Number

60

Checked

L.D.G.

Drawing No.

SI-59

Location

4500 S. Lancaster Rd.
Dallas, Texas 75216

Dwg. of

1


19 NORTH TEXAS
HEALTH CARE
SYSTEM

VANTHCS
Dallas, Texas

Approved Area Project Manager

Location	Dallas, Texas 75216
----------	---------------------

Dwg. of	1
---------	---

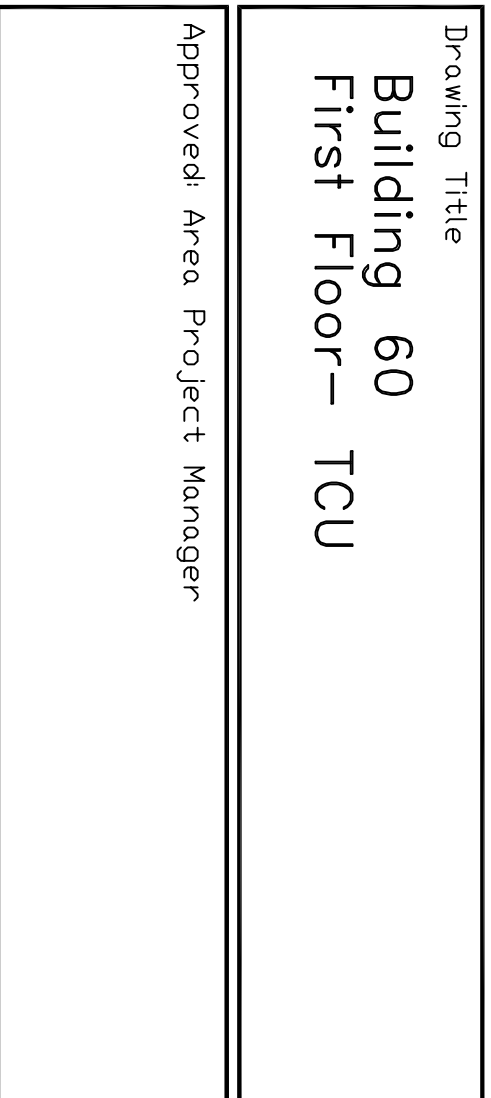

VANTHCS
Dallas, Texas

SI-59

Approved Area Project Manager

Building 60
First Floor— TCU

Drawing Title

Project Title

Date

Project No.

Building Number

Checked

Drawing No.

Location

Dwg. of

Approved Area Project Manager

Building 60
First Floor— TCU

Drawing Title

Project Title

Date

Project No.

Building Number

Checked

Drawing No.

Location

Dwg. of

Approved Area Project Manager

Building 60
First Floor— TCU

Drawing Title

Project Title

Date

Project No.

Building Number

Checked

Drawing No.

Location

Dwg. of

Approved Area Project Manager

Building 60
First Floor— TCU

Drawing Title