

## GENERAL INTERIOR FINISH PLAN NOTES

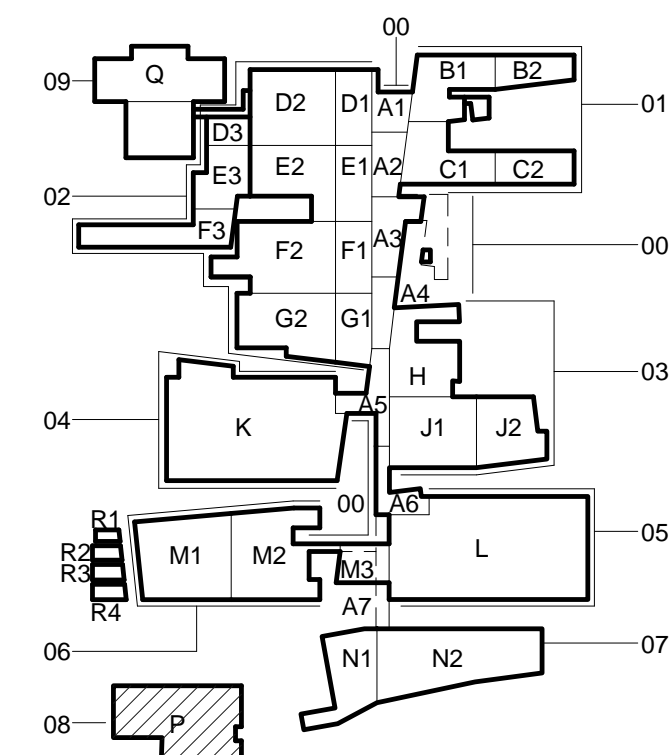
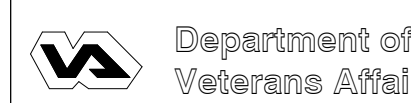
- NO T-SEAMS OR PARTIAL PIECES ACCEPTED FOR SEAMLESS FLOORING
- SEE SPECIFICATIONS IN CONJUNCTION WITH FINISH LEGEND FOR FINISH INFORMATION
- ALL WALLS TO BE PAINTED P-2 UN
- METAL DOOR FRAMES AND DOOR TO MATCH COLOR OF THE ADJACENT WALL
- SEAMS FOR CARPET AND SEAMLESS FLOORING TO NOT BE LOCATED AT DOORWAYS
- REFER TO WALL PROTECTION TYPICAL SHEET FOR FINISH APPLICATION
- TYPICAL FLOOR TRANSITION OCCUR UNDER OR AT CENTER LINE OF DOORS UN
- WALL PROTECTION LOCATION AS SHOWN ON AF SERIES DRAWINGS AND EXTENT AS INDICATED ON ELEVATIONS
- FOR ALL COUNTERTOPS, REFER TO SHEET 041532 FOR COUNTERTOP FINISH APPLICATION DETAIL UN
- CPT TO BE LAID MONOLITHIC ASHLAR WITH GRAIN RUNNING PERPENDICULAR TO CORRIDORS
- PAINT TO BE SEMI-GLOSS IN ALL TOILET ROOMS
- CARPET TO BE FLUSH WITH ADJACENT FLOOR MATERIAL
- GROUT JOINTS TO ALIGN WITH FINISHED BASE OF WALL
- DRAWINGS PROVIDE FINISH CODE FOR ACCENTS IN FLOORING AND WALL AND TYPICAL FINISH ROOM APPLICATIONS
- REFER TO SCHEDULE AND LEGEND IN CONJUNCTION WITH FINISH PLANS
- ALL FULL HEIGHT CORNER GUARDS SHOULD BE COORDINATED WITH ELEVATIONS AND REFLECTED CEILING PLANS
- CRASH RAILS AND HANDRAILS TO TERMINATE 2" FROM METAL DOOR FRAMES AND CORNER GUARDS UN
- ALL TOILET PARTITIONS TO MATCH P-1 UN
- REFER TO REFLECTED CEILING PLANS FOR ACCENT CEILING PAINT LOCATIONS
- INTERIOR OF OPEN CABINETS TO BE FINISHED WITH SAME MATERIAL LISTED UNDER VERTICAL WOODCASEWORK
- REFER TO SHEETS 8A1515 & 8A1516 FOR INTERIOR FINISH DETAILS
- CONCRETE COLUMNS NOT PAINTED UN. SEAL PER SPECIFICATION
- ALL EXISTING EXPOSED BRICK NOT TO BE PAINTED UN.
- REFER TO SHEET 8A1515 FOR INTERIOR FLOORING TRANSITION AND BASE DETAILS
- CEILING AREAS EXPOSED TO ABOVE IN FINISHED SPACES WITHIN THE DIXIE FOOTPRINT SHALL BE PAINTED P-8, INCLUDING STRUCTURE, FIREPROOFING, AND ALL UTILITIES AND THEIR ASSOCIATED SUPPORTS
- RFI 7129 BLACK MATERIAL ON EXISTING BRICK WALLS IS TO BE REMOVED WHERE EXPOSED TO VIEW. TYPICAL AT ALL LOCATIONS.

## INTERIOR FINISH PLAN CODED NOTES

- REFER TO A1500 SERIES SHEETS FOR MILLWORK FINISH DESIGNATIONS
- ALIGN FLOOR TRANSITIONS WITH WALL / ADJACENT FINISHED FACE
- ALL SHOWERS TO HAVE FULL-HEIGHT CERAMIC TILE ON ALL WALLS
- SSB-1 USED AT BASE OF COLUMN
- WALL GRAPHIC TO BE APPLIED - WILL COVER ENTIRE WALL. REFER TO EGD PACKAGE FOR DETAILS.
- ALIGN TO FRAME OF DOOR

## SYMBOLS LEGEND

- FLOOR FINISH - SEE 8AF602
- WALL FINISH - SEE 8AF603
- ROOM NAME NUMBER (KEY)
- TYPICAL ROOM/TYPICAL ROOM FINISH CODE
- WALL PROTECTION - SEE 8AF605
- CORNERGUARD - SEE 8AF603

CONSTRUCTION DOCUMENTS 1  
FULLY SPRINKLEREDOFFICE OF  
CONSTRUCTION  
AND FACILITIES  
MANAGEMENTPROJECT NUMBER  
100342.00BUILDING NUMBER  
08DOCUMENT SET PACKAGE  
WP\_09B

DRAWING NUMBER

8AF101

PROJECT TITLE  
SLVHCS REPLACEMENT MEDICAL  
CENTER PROJECTLOCATION  
NEW ORLEANS, LOUISIANADATE  
July 16, 2012CHECKED  
JRDRAWN  
ANDRAWING TITLE  
BLDG 8 LEVEL 1 FINISH FLOOR PLAN

APPROVED: PROJECT DIRECTOR

## ARCHITECT/ENGINEERS:

studio NOVA

SCHRENK & PETERSON CONSULTING ENGINEERS / CIVIL  
KORDA/NEMETH ENGINEERING / STRUCTURAL  
BR+A CONSULTING ENGINEERS / MECH. ELECT, PLUMBING, LOW VOLTAGE  
ARCHITECTURAL ENGINEERING / PLUMBING  
SCALES ASSOCIATES / FIRE PROTECTION

## CONSULTANTS:

DESMAN ASSOCIATES / PARKING  
CODE CONSULTANTS, INC. / CODE CONSULTANT  
THE SEXTANT GROUP / AV & ACOUSTICAL  
HAMMER DESIGN ASSOCIATES / FOOD SERVICE  
PYBURN & ODOM / ABATEMENT  
TATA & HOWARD / TANK CONSULTANT  
I.S.C. GROUP, INC. / IRRIGATION  
DAN EUSER WATER ARCHITECTURE, INC. / WATER FEATURE

CHANGES INDICATED IN RED FONT - BULL 048 - 10/13/2015

3 Addendum #3 - Post-Bid 7/3/2013  
1 Addendum 01 9/21/12

REVISIONS: DATE

VA FORM 08-6231