




three inches = one foot
one and one half inches = one foot
one inch = one foot
three quarters inch = one foot
one half inch = one foot
three eighths inch = one foot
one quarter inch = one foot
one eighth inch = one foot

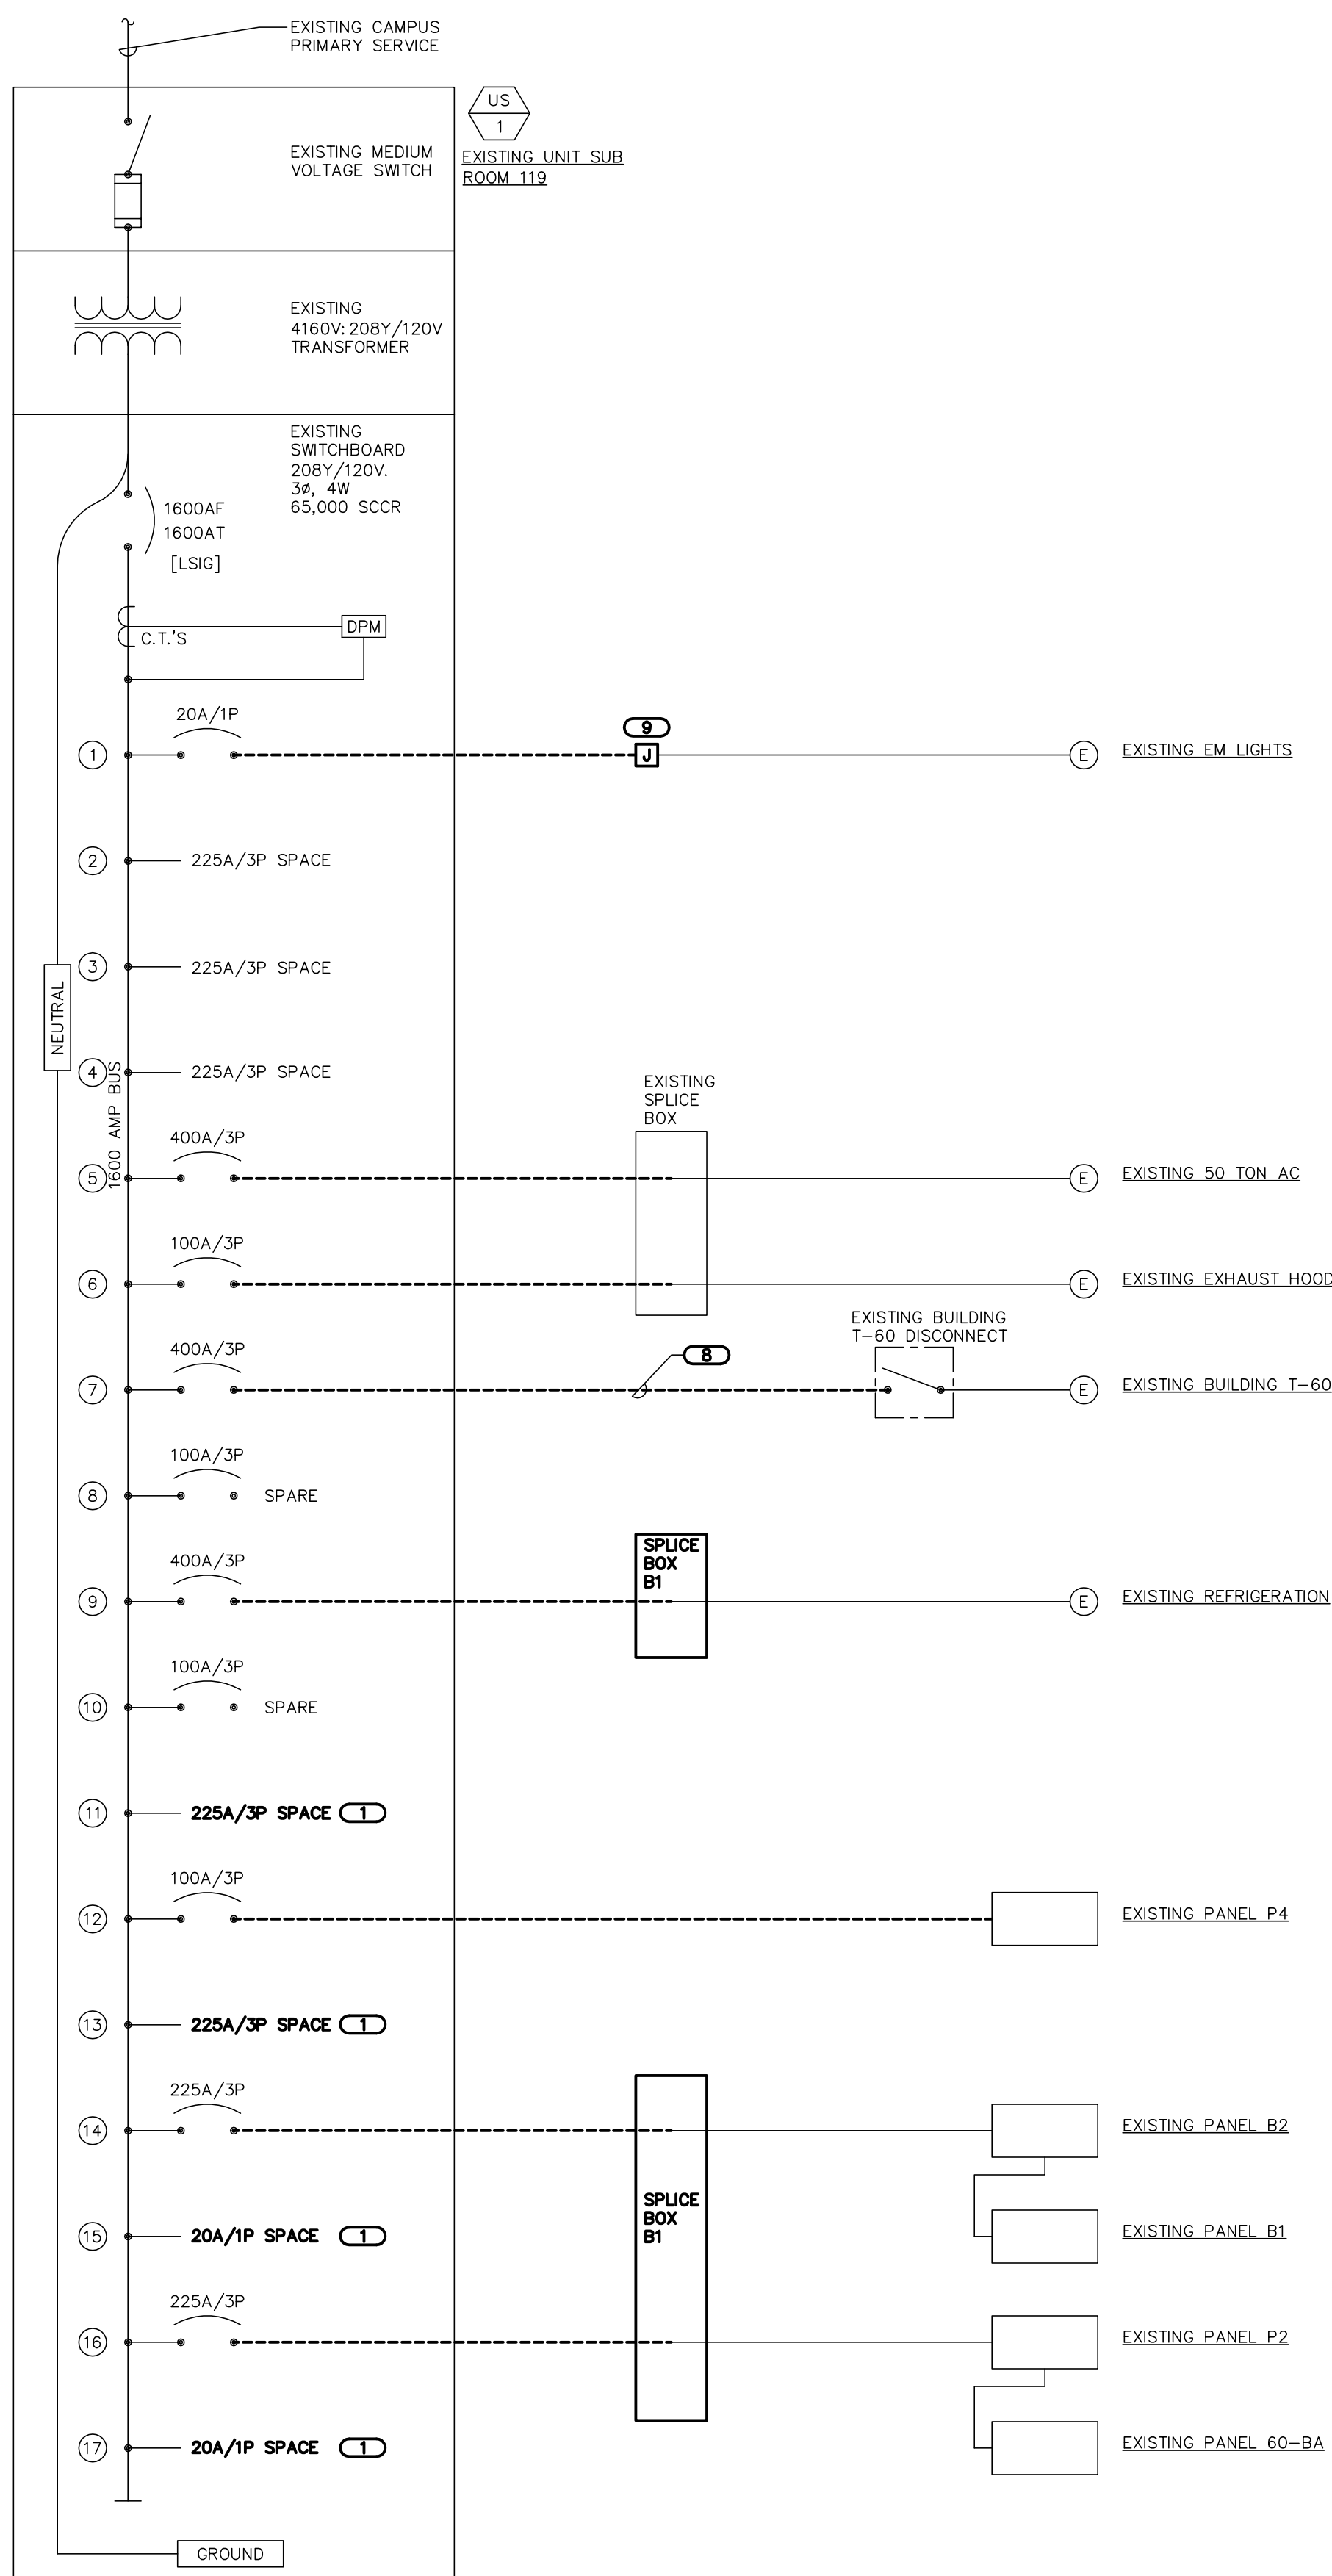


1 ONLINE DIAGRAM - DEMOLITION
NO SCALE

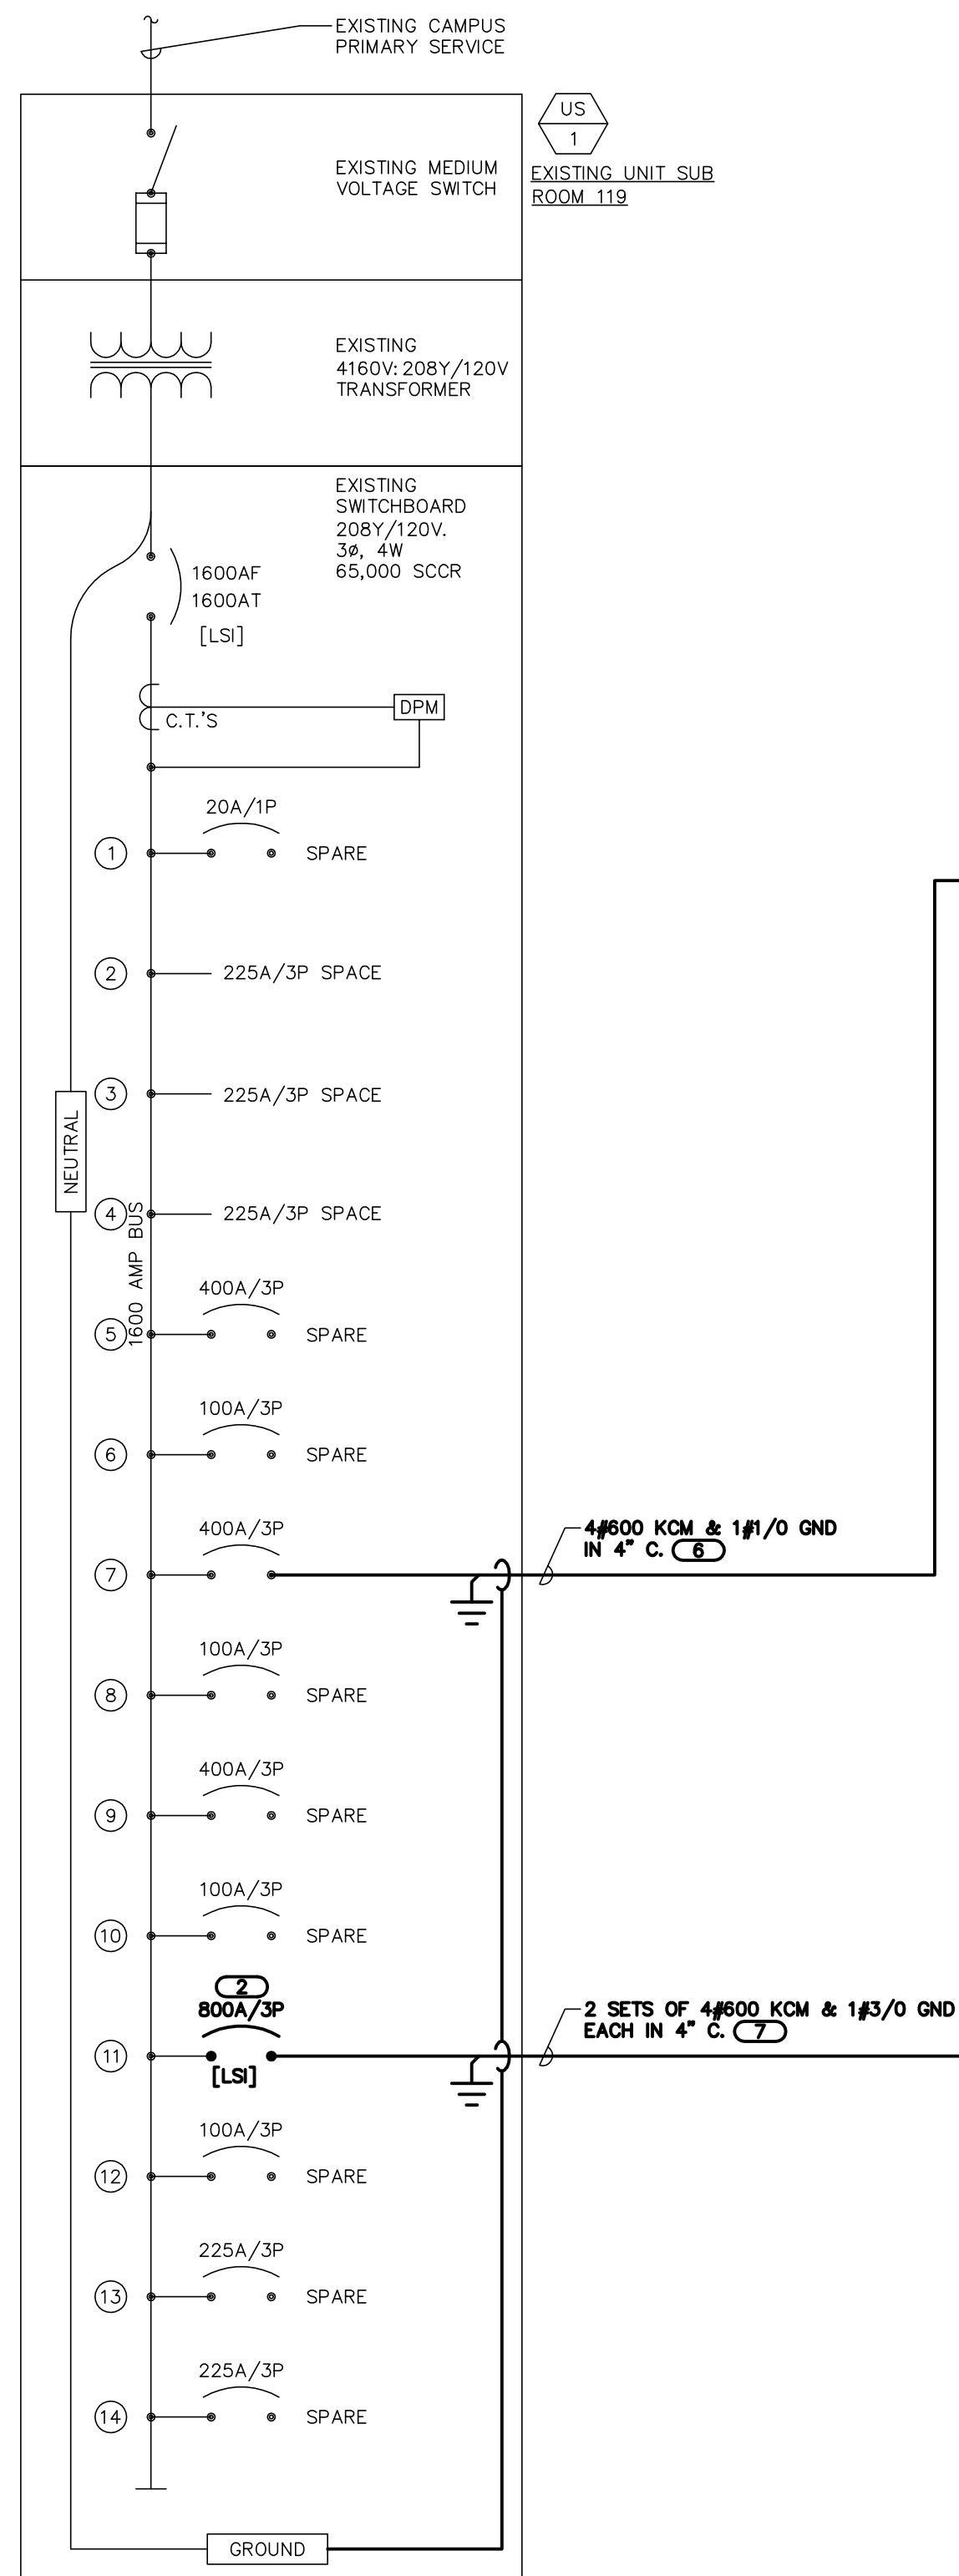

2 ONLINE DIAGRAM - NEW WORK
NO SCALE

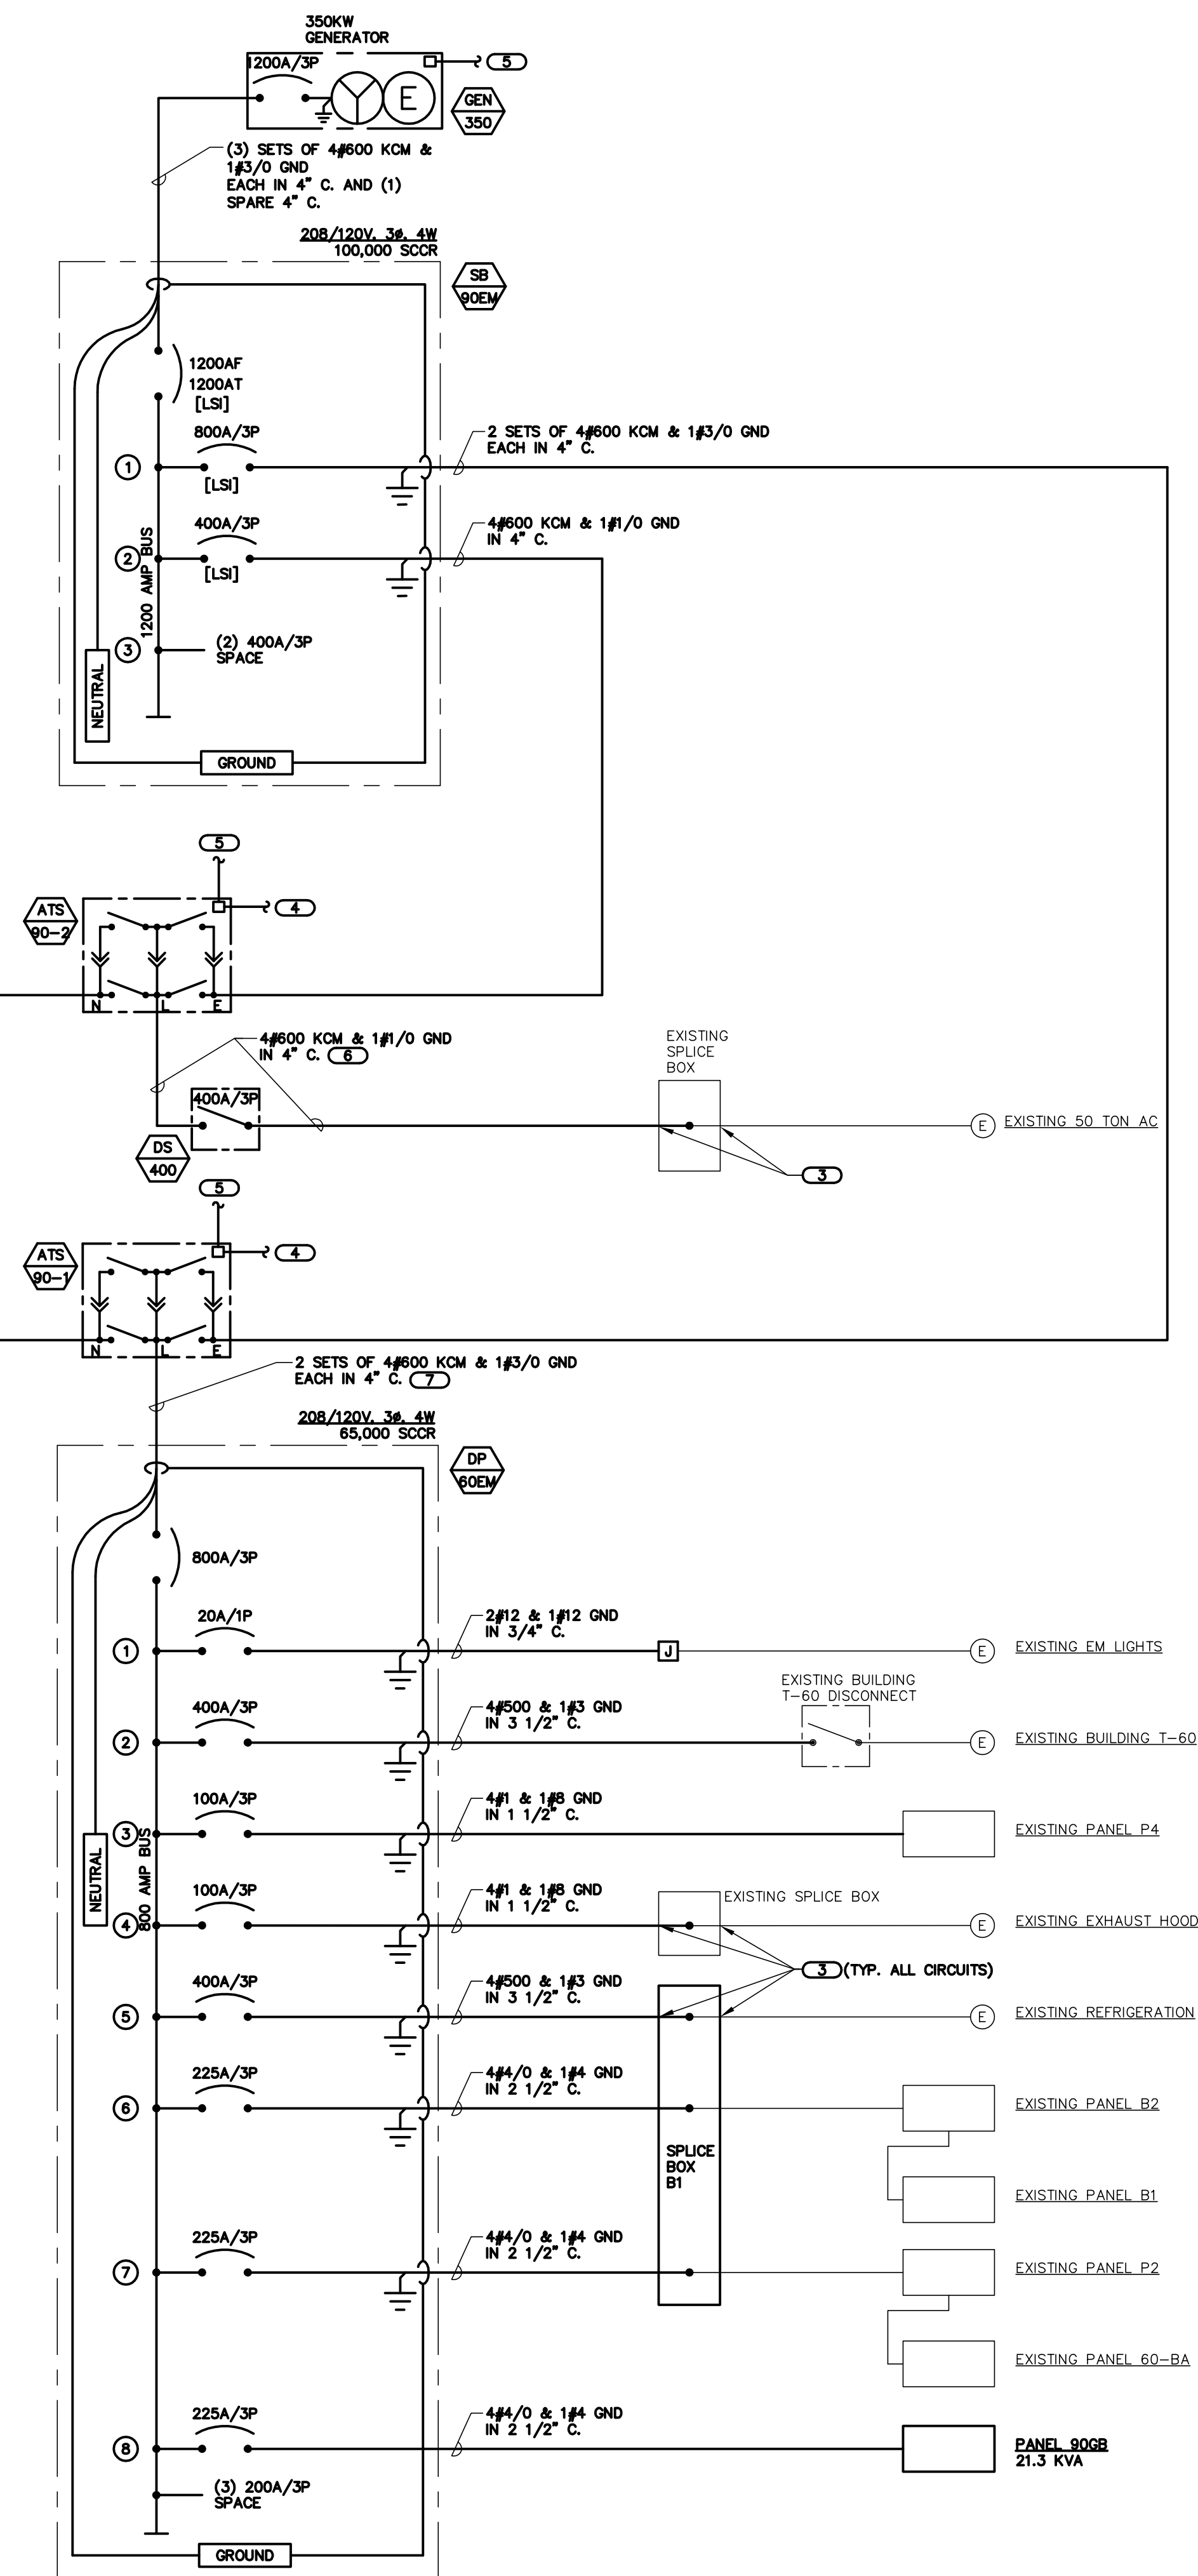

3 (US/1) SWITCHBOARD ELEVATION - DEMOLITION
NO SCALE

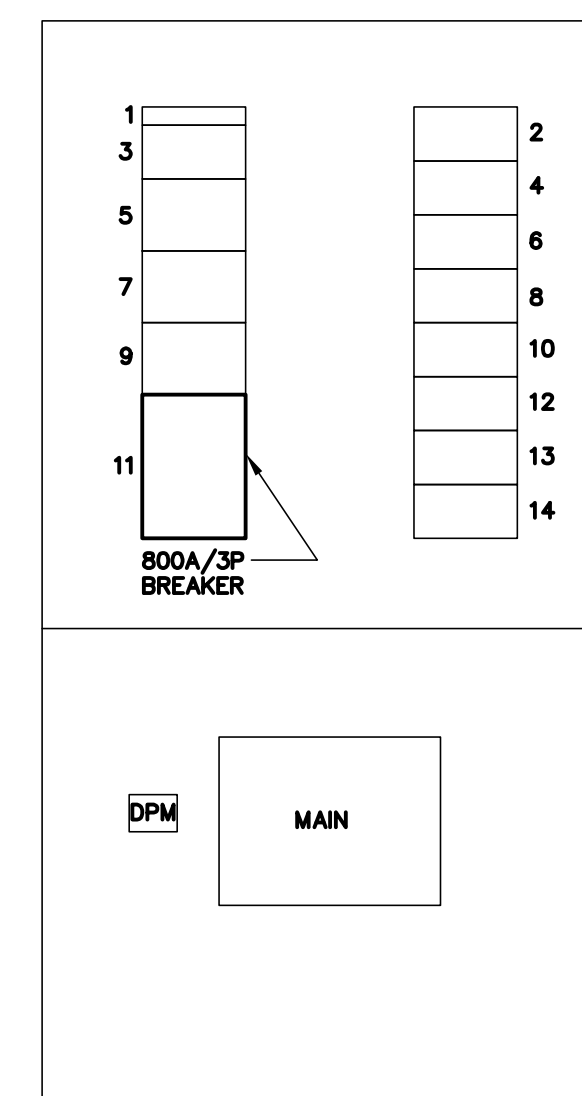

4 (US/1) SWITCHBOARD ELEVATION - NEW WORK
NO SCALE

AS-BUILT DOCUMENTS

--	--	