




1 FIRE SPRINKLER RISER (CFA)
110-FP5 NOT TO SCALE

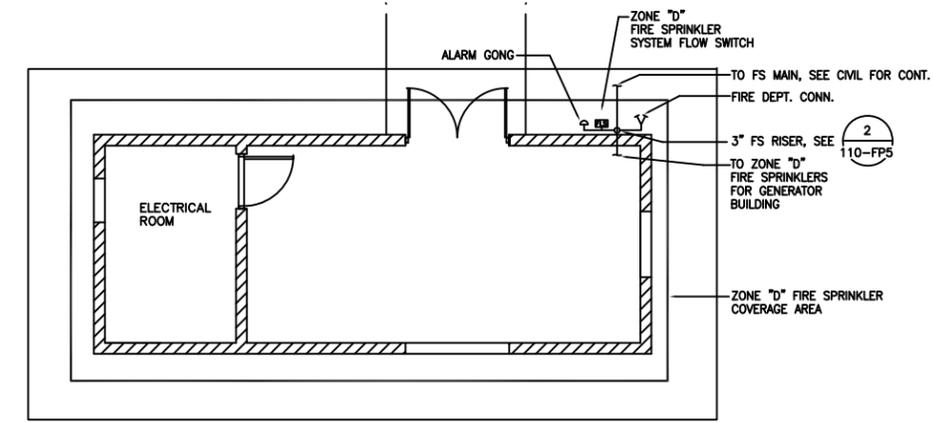


EMERGENCY GENERATOR FIRE SPRINKLER FLOOR PLAN
SCALE: 1' = 4'-0"

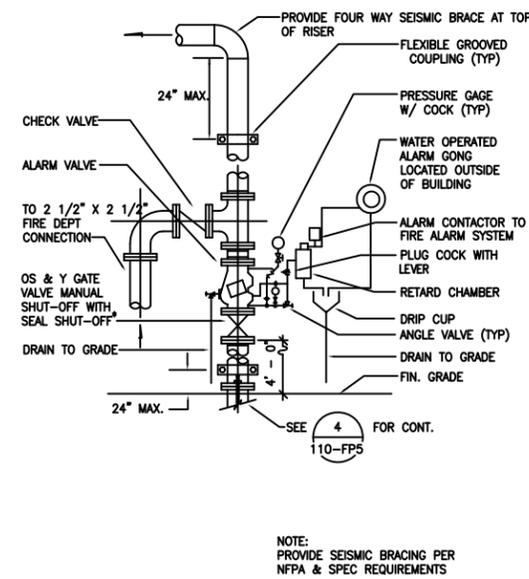

2 FIRE SPRINKLER RISER (GENERATOR BLDG.)
110-FP5 NOT TO SCALE

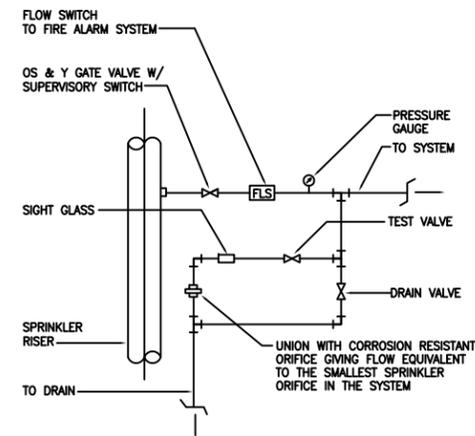

3 FIRE SPRINKLER ZONE VALVE
110-FP5 NOT TO SCALE

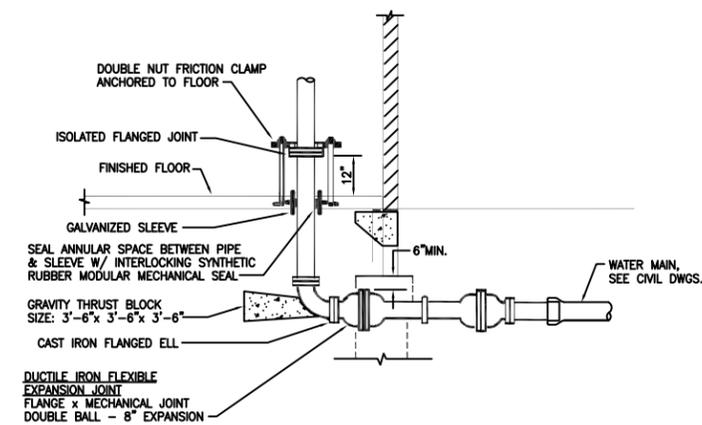

GENERAL NOTE: ALL UNDERGROUND BOLTS & NUTS ON FLANGED JOINTS SHALL BE STAINLESS STEEL. PROVIDE ISOLATING GASKETS BETWEEN DISSIMILAR METALS.

4 FIRE SPRINKLER SERVICE ENTRANCE DETAIL
110-FP5 NOT TO SCALE

RECORD DRAWINGS

6/29/08

ARCHITECTS HAWAII LIMITED
Pacific Tower, Suite 300
1001 Bishop Street
Honolulu, Hawaii 96813
Telephone: (808) 523-9656
FAX: (808) 521-5280

This work was prepared by me or under my supervision and construction of this project will be under my supervision.
Signature: _____
NOTE: Contractor to check and verify all dimensions at job before proceeding with work.

Drawing Title: **DETAILS, GENERATOR FLOOR FIRE SPRINKLER PLAN**

Approved Area Project Manager

Project Title: **NEW MEDICAL AND REGIONAL OFFICE CENTER, PHASE 1, CENTER FOR THE AGING**

Building Number: _____
ID: _____
Location: **YAMROG, HONOLULU, HAWAII**

Date: **MAY 3, 1905**

Project No.: **450-001C**

Drawing No.: **10-FP5**
Page: _____ of _____



Department of Waterworks

091684