


Project LOUIS A. JOHNSON VA MEDICAL CENTER BUILDING AUTOMATION SYSTEM UPGRADE Project No. 540-11-108
 Title MECHANICAL TEMPERATURE CONTROLS Phase _____
 Date 2012-06-08
 Des By ODM Dept MECHANICAL Rev Date _____
 Ckd By SOL Sketch SK-002 Sheet No. 1 Of 1

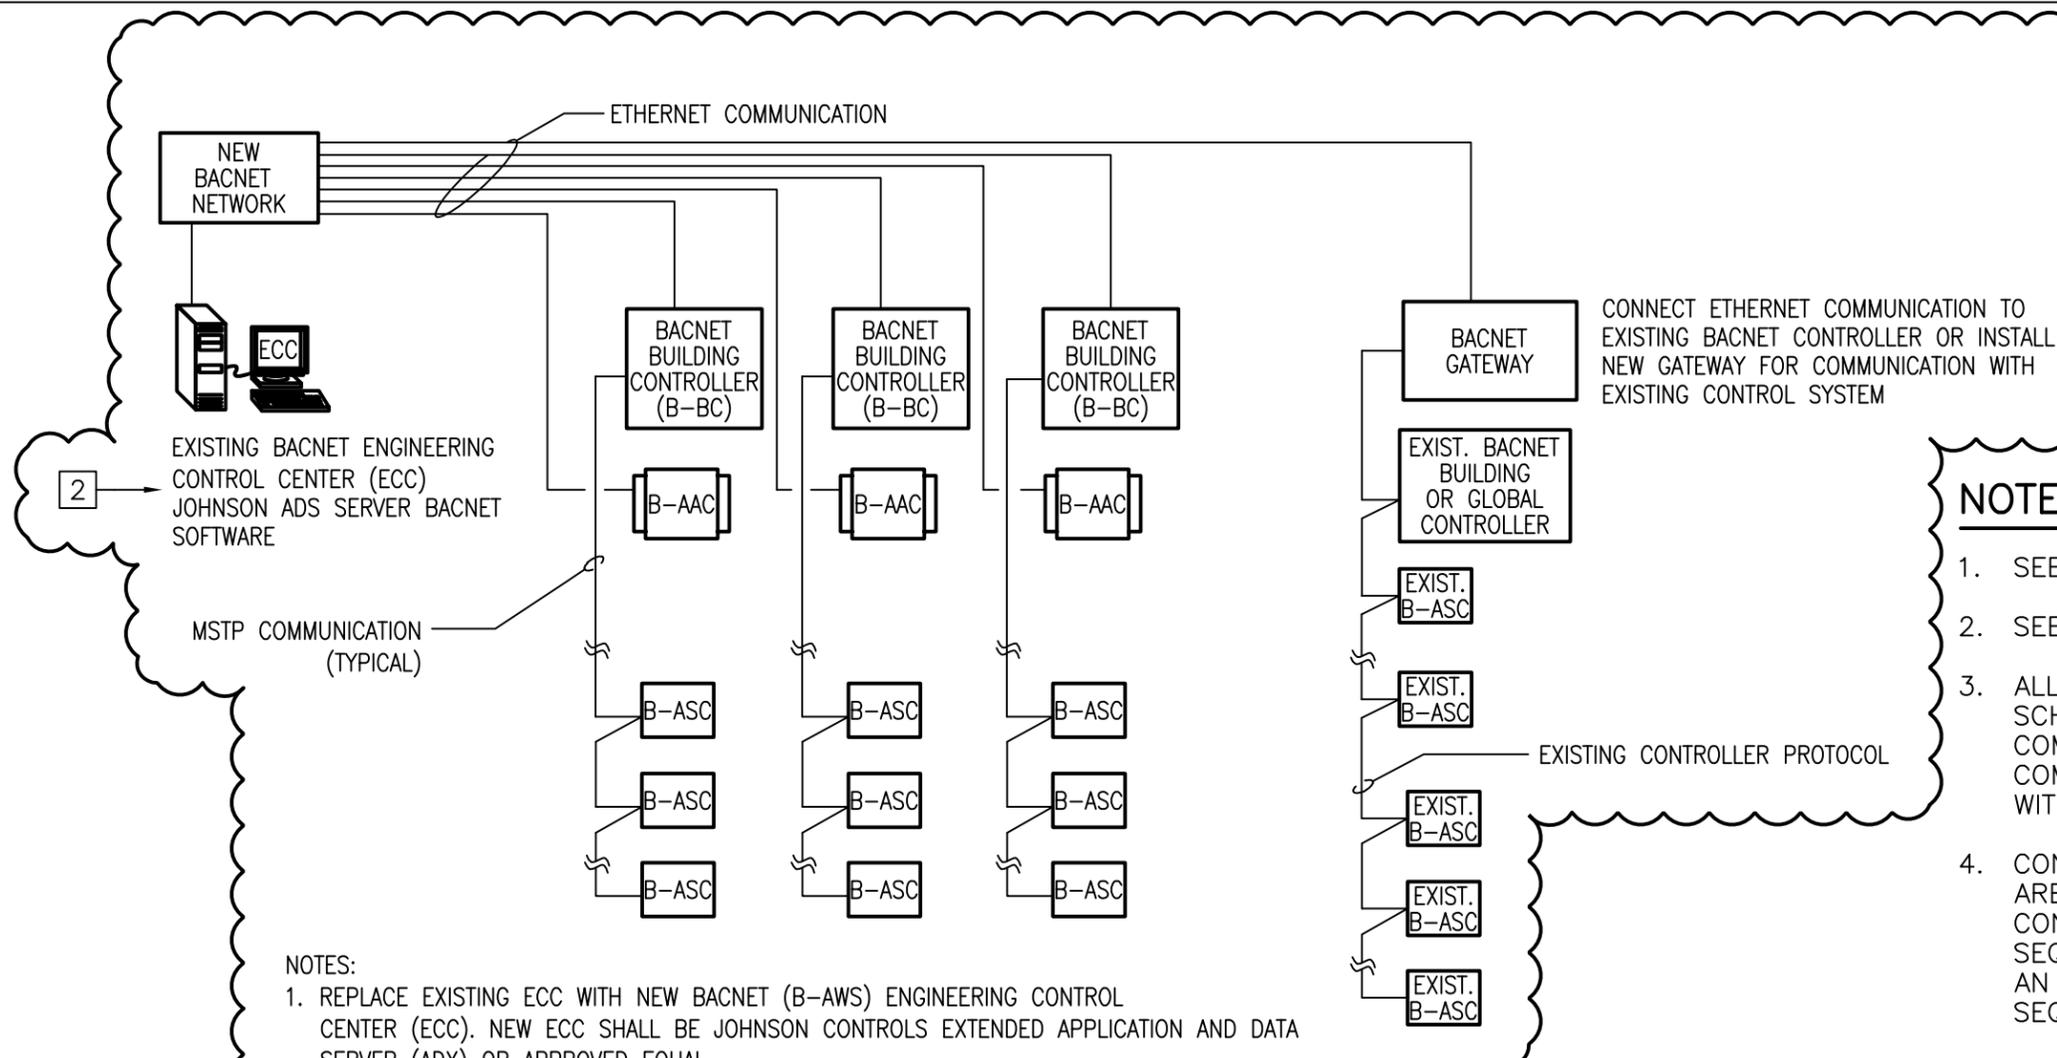

CONTROL SYSTEM CONFIGURATION
 NEW BACNET ECC, INSTALL NEW BACNET SOFTWARE CONTROLS ON ECC, PROVIDE ETHERNET CONNECTION OR BACNET GATEWAY FOR EXISTING CONTROL SYSTEM. INSTALL NEW BACNET COMMUNICATION NETWORK. INTERFACING OF CONTROLS SHALL ALLOW FOR COMPLETE REPORTING AND CONTROL OF EXISTING SYSTEMS.

CONNECT ETHERNET COMMUNICATION TO EXISTING BACNET CONTROLLER OR INSTALL NEW GATEWAY FOR COMMUNICATION WITH EXISTING CONTROL SYSTEM

NOTES THIS SHEET:

1. SEE SHEET MI001 FOR LEGEND AND GENERAL NOTES.
2. SEE SHEET GI002 FOR ABBREVIATIONS.
3. ALL CONTROL COMPONENTS SHOWN IN CONTROL SCHEMATICS SHALL BE REPLACED WITH NEW CONTROL COMPONENTS UNDER THIS CONTRACT U.O.N. COMPONENTS SHALL BE CONTROLLED IN ACCORDANCE WITH SYSTEM CONTROL SEQUENCE.
4. CONTROL SCHEMATICS AND SEQUENCE OF OPERATIONS ARE FROM THE ORIGINAL RECORD DRAWINGS. CONTRACTOR SHALL REVIEW AND COORDINATE THE SEQUENCE OF OPERATIONS FOR SYSTEMS MODIFIED WITH AN OWNER REPRESENTATIVE TO CONFIRM FINAL SEQUENCE OF OPERATIONS FOR REVISED SYSTEMS.
5. PROVIDE NEW STAND ALONE APPLICATION SPECIFIC CONTROLLERS FOR EACH SYSTEM CONTROLLED.

NOTES:

1. REPLACE EXISTING ECC WITH NEW BACNET (B-AWS) ENGINEERING CONTROL CENTER (ECC). NEW ECC SHALL BE JOHNSON CONTROLS EXTENDED APPLICATION AND DATA SERVER (ADX) OR APPROVED EQUAL.
2. EXISTING CONTROLLERS TO REMAIN.
3. INSTALL NEW ETHERNET COMMUNICATION OR BACNET GATEWAY WITH FULL COMMUNICATION TO EXISTING CONTROLLERS TO REMAIN.
4. INSTALL NEW BACNET COMMUNICATION NETWORK.
5. INSTALL MULTIPLE BUILDING CONTROLLERS AS REQUIRED.
6. INSTALL NEW CONTROLLERS (B-AAC/B-ASC) AS REQUIRED.
7. PROVIDE NEW ETHERNET BACKBONE FROM THE BASEMENT TO THE PENTHOUSES OF BUILDINGS 1 & 2.

SHEET KEYNOTES:

2. UPGRADE EXISTING APPLICATION DATA SERVER (ADS) TO AN EXTENDED APPLICATION AND DATA SERVER (ADX).