


REVISION	DATE	BY	DESCRIPTION
18	08-22-75	J.B.	ADDED CIRCUIT, LAF, BKR 58 (RM. A-564)
19	08-22-75	J.B.	ADDED CIRCUIT, LAF, BKR 59 (RM. A-507)

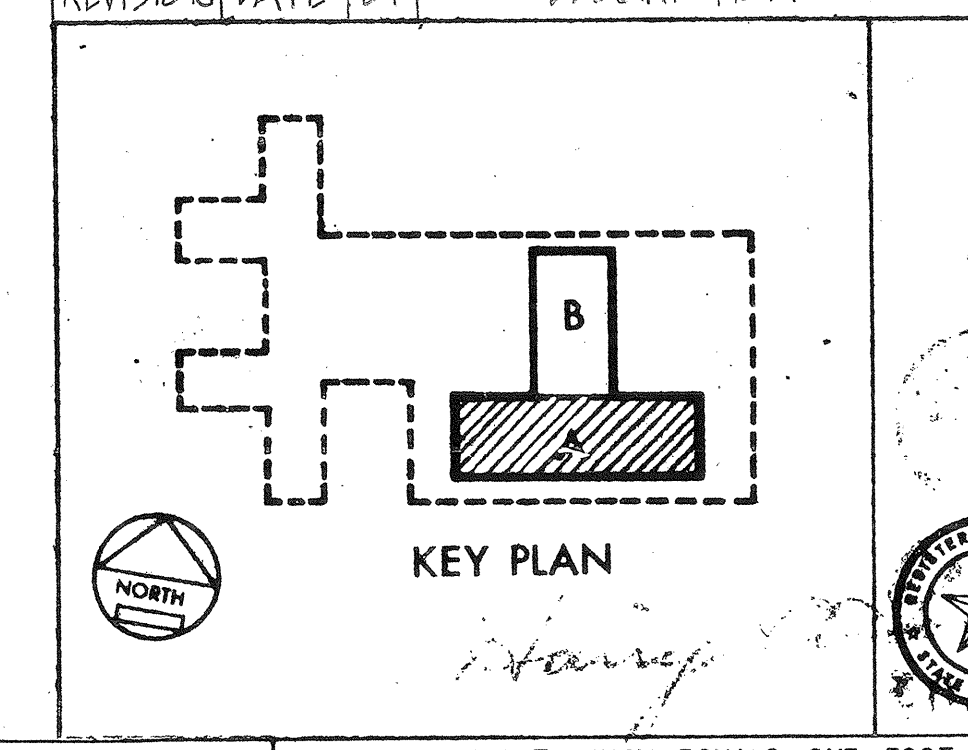

AS-BUILT DRAWING

JUL 1975

FIFTH FLOOR PLAN-AREA A
BUILDING NO. 1 - SCALE 1/8"=1'-0"
760 BED M. S. & N. AND PSYCHIATRIC HOSPITAL
VETERANS ADMINISTRATION
SAN ANTONIO, TEXAS

DESIGNED BY J.W. AA	REVISIONS
DRAWN BY AA	
CHECKED BY AA	
APPROVED BY AA	

GOLEMON & ROLFE ARCHITECTS
SAN ANTONIO ASSOCIATED ARCHITECTS
NOONAN, KROCKER & ROGERS
ARCHITECTS & ENGINEERS
EDWARD R. GONDEK, ARCHITECT
WILLIAM E. PARRISH, ARCHITECT
ADAMS & ADAMS ARCHITECTS

DRAWING NUMBER
1-E79

Sheet 1 of 161
Proj. No. 42-5363