
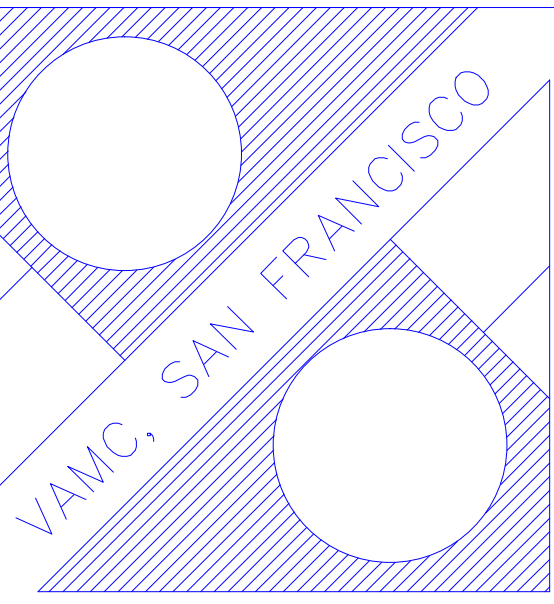


Revisions		Date		Professional Seal		 Indus Systems, Inc. 2352, Main Street, Concord MA 01742 Tel: 978-461-0555 www.indus-systems.com		Drawing Title SECOND FLOOR PLAN ARCHITECTURAL		Project Title AS-BUILT Drawings		Date 05-16-2008		 VAMC, SAN FRANCISCO		VA Department of Veterans Affairs			
						Approved:		Building Number 2		Checked		Drawn						Project No.	
						Approved:		Location VAMC, SAN FRANCISCO										Drawing No.	