


CONCRETE COLUMN STOPS AT ELEV. +25'-2 1/2" & CONTINUES AS REINFORCED MASONRY ABOVE ROOF. SEE SECTION "C" SHEET 102-16 (TYPICAL ALL COLUMNS C-1).

LEGEND
SEE DWG. 102-58.
NOTE: SEE NOTES 1 THRU 11 ON DWG. 102-58.

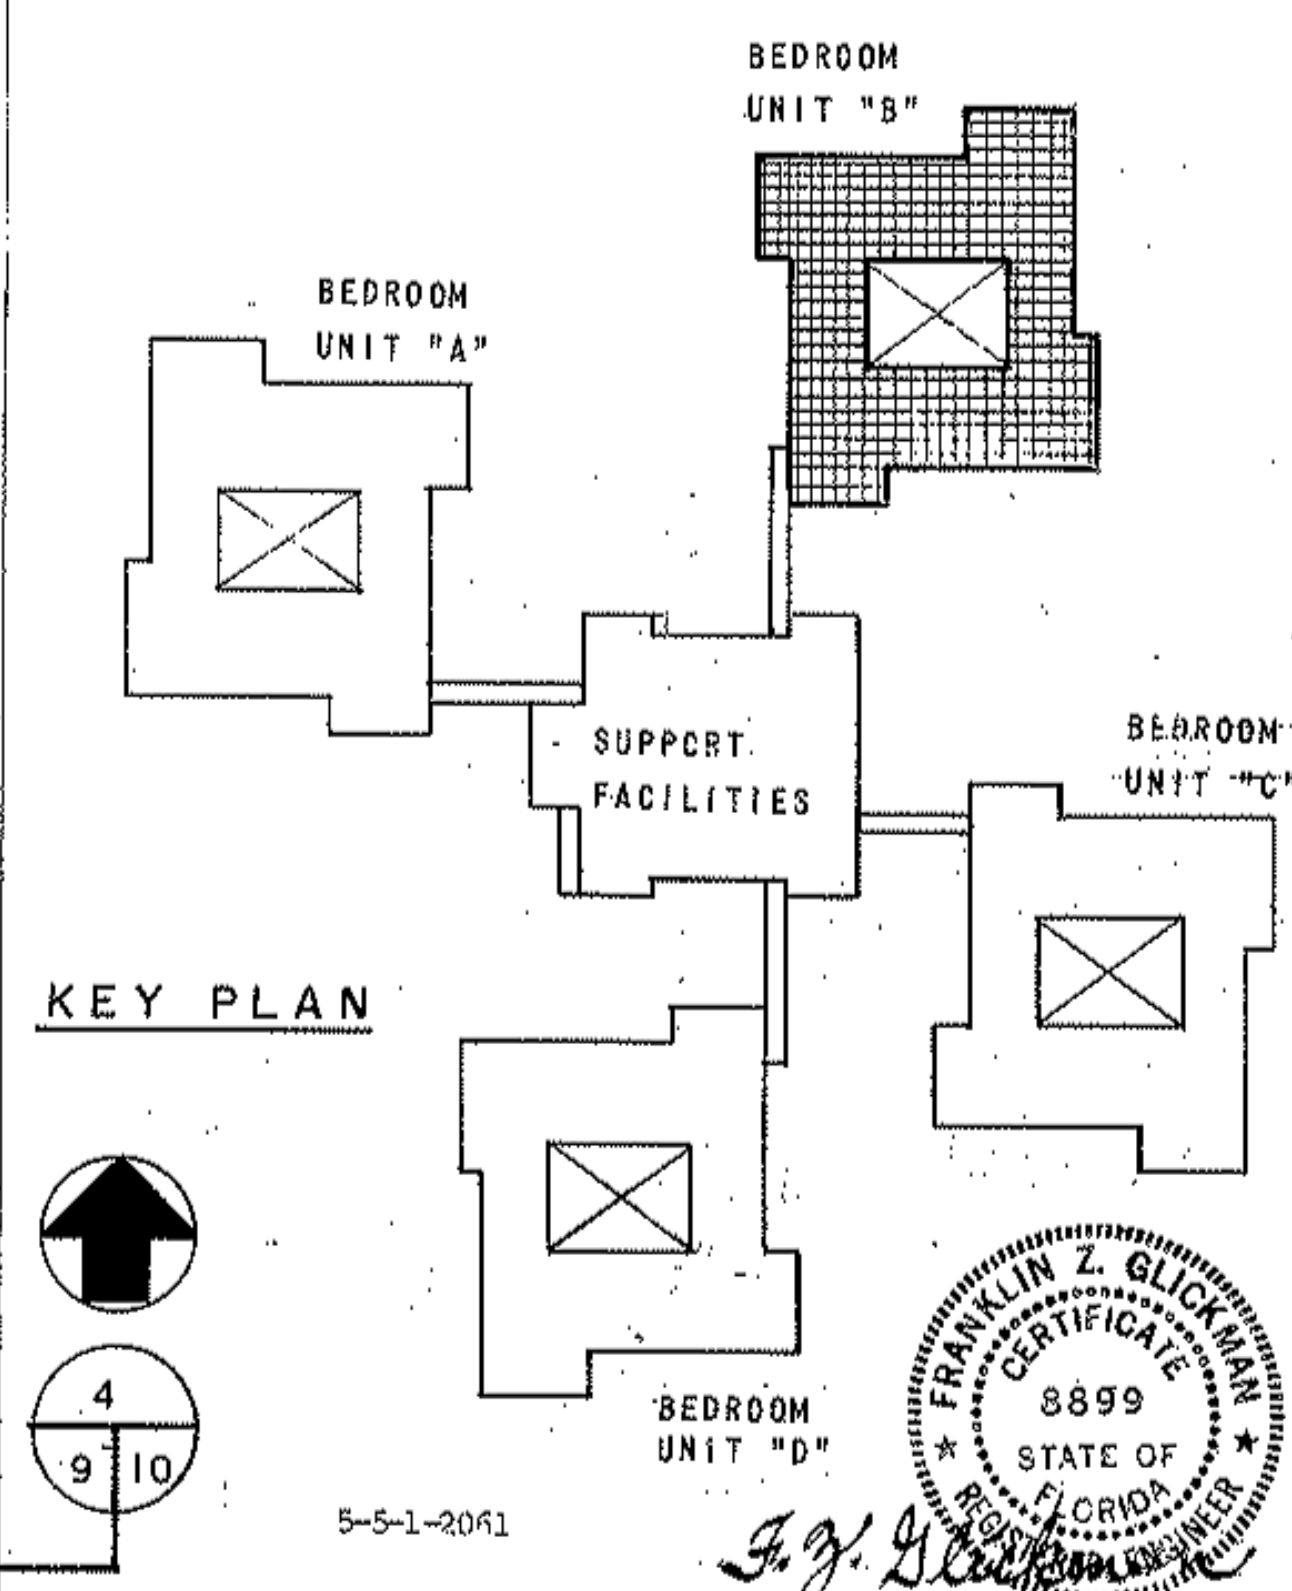

7/27/81 AS BUILT	
NO.	DATE
REVISIONS	
PROJECT TITLE	
ROOF FRAMING PLAN, BEDROOM UNITS	
"B" AND "D" (UNIT "B" AS SHOWN	
1/8" = 1'-0" (UNIT "D" SIMILAR)	
PROJECT NO.	
102 200 Bed	
Domiciliary Building	
G. DELCAMPO	
SHS Associates Inc.	
Architects, Engineers, Planners	
2600 - 9th Street North	
St. Petersburg, Florida 33704	
APPROVED PROJECT DIRECTOR	
102-S9	
516-053F	

VETERANS ADMINISTRATION
V.A.C. Bay Pines, Florida