



GENERAL NOTES:

1. INSTALL EROSION CONTROL NETTING AS SPECIFIED, ON ALL SLOPES WITH FINISH GRADE OF 3:1 OR STEEPER.
2. LOCATE ALL PLANTING BEDS IN FIELD. DEFINE PLANTING BEDS WITH WHITE FIELD-MARKING CHALK OR APPROVED EQUAL. ALL PLANTING BEDS TO BE ADJUSTED UNDER DIRECTION OF RESIDENT ENGINEER PRIOR TO LAYOUT OF PLANTS.
3. PLANT SPACING SHALL TAKE PRECEDENCE OVER VALVE BOX LOCATIONS. INSTALLED VALVE BOXES WHICH CONFLICT WITH THE ACCEPTED PLANT LAYOUT SHALL BE MOVED TO BE BETWEEN PLANTS.
4. SHRUBS AND GROUNDCOVERS TO BE PLANTED A MINIMUM OF ONE HALF THEIR ON-CENTER SPACING FROM PAVING EDGE UNLESS OTHERWISE NOTED.
5. QUANTITIES INDICATED ARE FOR THE CONVENIENCE OF THE CONTRACTOR ONLY. INSTALL NUMBER OF PLANTS AS DRAWN. CONTRACTOR RESPONSIBLE FOR INSTALLING PLANTS IN QUANTITIES AND LOCATIONS SHOWN.
6. ALL PLANT MATERIAL TO BE NURSERY GROWN UNLESS OTHERWISE NOTED.
7. REFERENCE SHEET L5.1 FOR PLANT SCHEDULE.



RESTORATION ZONE PLANTING NOTES:

1. SEED ALL AREAS WITHIN THE RESTORATION ZONE WITH "RESTORATION ZONE NATIVE GRASS MIX". REFERENCE SPECIFICATIONS.
2. WITHIN RESTORATION ZONE PLANTING AREA, LAYOUT QUERCUS GARRYANA TREES AT A SPACING OF 20' ON CENTER THROUGHOUT ZONE. (125 TREES PER ACRE)
3. LAYOUT SHRUB SPECIES IN SAME SPECIES GROUPINGS OF 10-15 SHRUBS EACH. SPACE SHRUBS FROM 3' TO 6' ON-CENTER.
4. ALL PLANT LOCATIONS TO BE ADJUSTED UNDER DIRECTION OF RESIDENT ENGINEER PRIOR TO PLANTING.
5. WITHIN RESTORATION ZONE PLANTING AREA, INSTALL SHRUBS ACROSS 25% OF AREA AT AN AVERAGE SPACING OF 5' O.C. (500 SHRUBS PER ACRE) - 1/3 ARCTOSTAPHYLOS MANZANITA, 1/3 ARCTOSTAPHYLOS VISCIDA AND 1/3 CEANOTHUS CUNEATUS.

KEYED NOTES

- 1 SEED ALL AREAS DISTURBED ADJACENT TO EXISTING GRAVE SITES WITH FINISH SEED MIX.
- 2 PROVIDE ROUGH LAWN SEED MIX FOR ALL AREAS WITH EXPOSED SOILS OUTSIDE FINISH LAWN OR RESTORATION AREAS, TYP.
- 3 LIMIT OF FINISH LAWN SEED.

KEY MAP

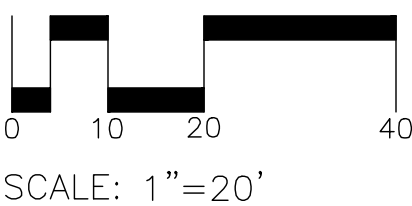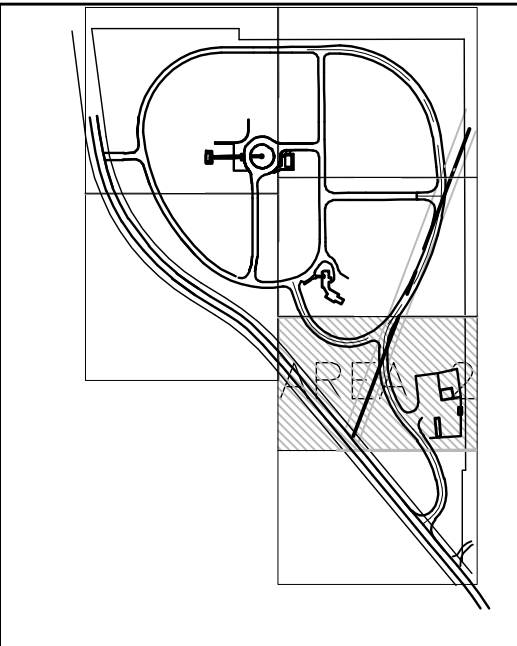

RECORD DRAWING

Revisions	Date

Mayer/Road
Landscape Architecture

319 SW Washington Street
Suite 820
Portland, Oregon 97204

T 503.223.5953
F 503.223.8076

N ATIONAL
C EMETERY
A DMINISTRATION

Drawing Title	PLANTING PLAN AREA 2
Approved: Director, Office of Construction Management	
Approved: Director, Project Management Service	

Project Title	EAGLE POINT NATIONAL CEMETERY EXPANSION
Building Number	
Checked	IB
Drawn	LT
Location	EAGLE POINT NATIONAL CEMETERY Eagle Point, Oregon

Date	11/13/06
Project No.	906-CM3007
DRAWING NO.	L5.2
Dwg.	OF