




1 PLAN - TYPICAL GROUNDCOVER SPACING
Scale: N.T.S. PLTSPAC1.DWG

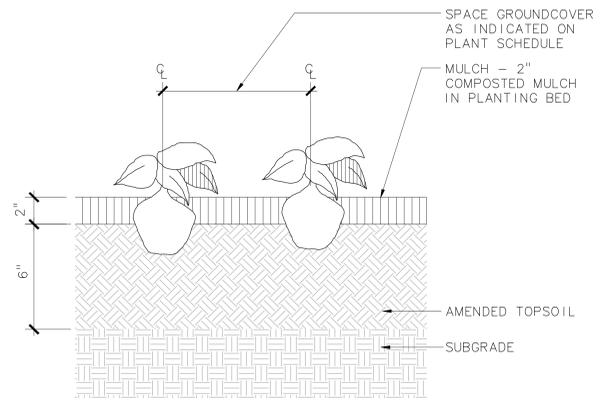

2 SECTION - GROUNDCOVER PLANTING
Scale: N.T.S. PLTGCN1.DWG

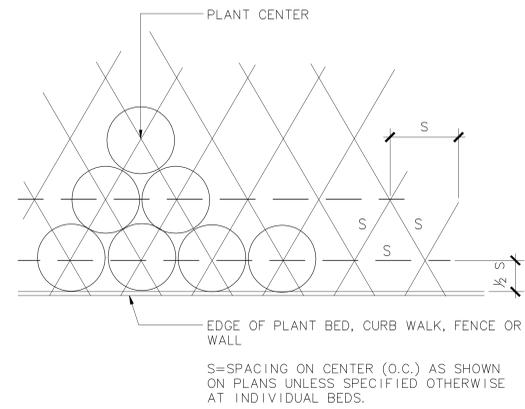


3 PLAN - TYPICAL PLANT SPACING
Scale: N.T.S. PLTSPAC2.DWG

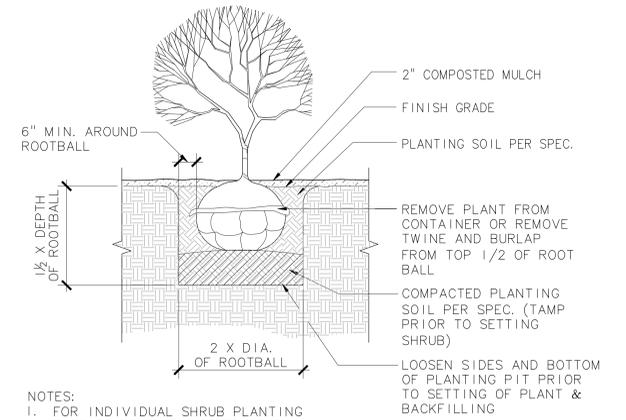


- NOTES:
- FOR INDIVIDUAL SHRUB PLANTING PITS TO BE 2X DIAMETER PLUS 1 1/2X THE DEPTH OF THE ROOTBALL.
 - ROOTBALL CROWN TO BE FLUSH WITH FINISH GRADE.


4 SECTION - TYPICAL SHRUB PLANTING
Scale: N.T.S. PLTSHRU1.DWG

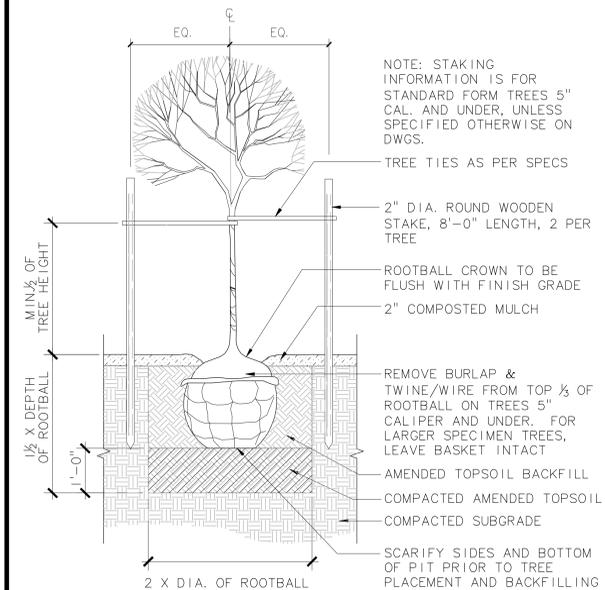

5 SECTION - TYPICAL TREE PLANTING AND STAKING
Scale: N.T.S. PLTTREE1.DWG

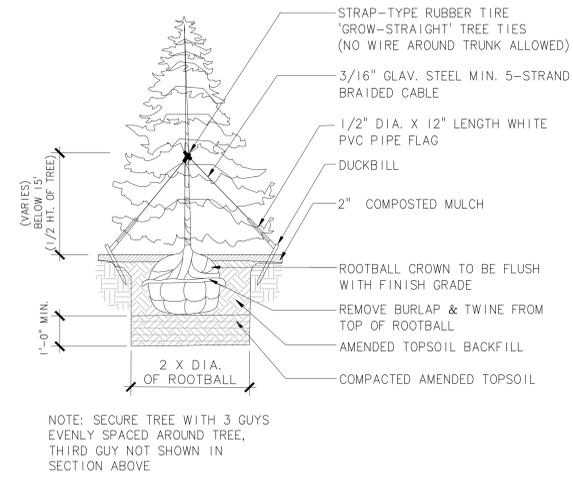

6 SECTION - TYPICAL EVERGREEN TREE PLANTING AND STAKING
Scale: N.T.S. PLTTREE2.DWG

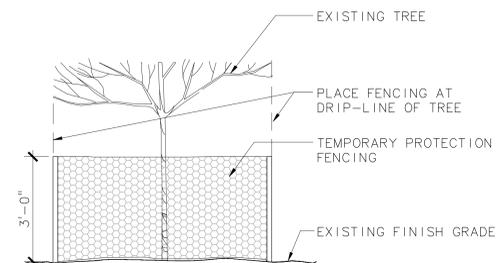

7 ELEVATION - TREE PROTECTION (AS NEEDED)
Scale: 1/2" = 1'-0" PLTPROTC.DWG

RECORD DRAWING

Revisions	Date

Mayer/Road
Landscape Architecture
319 SW Washington Street
Suite 820
Portland, Oregon 97204
T 503.223.5953
F 503.223.8076



NATIONAL
CEMETERY
ADMINISTRATION

Drawing Title PLANTING DETAILS		Project Title EAGLE POINT NATIONAL CEMETERY EXPANSION		Date 11/13/06
Approved: Director, Office of Construction Management		Building Number	Checked IB	Drawn LT
Approved: Director, Project Management Service		Location EAGLE POINT NATIONAL CEMETERY Eagle Point, Oregon		DRAWING NO. L5.7 Dwg. Of