




		Date: 11-04-2014 Project No.: Drawing No.:
Project Title: AS-BUILT Drawings		Blg. no.: Blg. name: Project location:
Drawing Title: 11-30 FLOOR PLAN ENLARGED SOUTH ARCHITECTURAL		Checked: Drawn:
Indus Systems, Inc. 2352 Main Street, Concord MA 01742 Tel: 978-461-0555 www.indus-systems.com		Approved: Approved:
Professional Seal:		Department of Building

11-30 FLOOR PLAN ENLARGED SOUTH ARCHITECTURAL



		Date: 11-04-2014 Project No.: Drawing No.:	
Project Title: AS-BUILT Drawings		Checked: <input type="checkbox"/>	Drawn: <input type="checkbox"/>
Drawing Title: THIRD FLOOR PLAN ENLARGED NORTH ARCHITECTURAL		Existing Number: No - L.A.D. 13	Location: 100 JOHN ST. 2ND FLOOR
Approver: Indus Systems, Inc. 333 Conover MA 01742 Tel: 978-461-0555 www.indus-systems.com		Approved:	
Professional Seal		Date:	



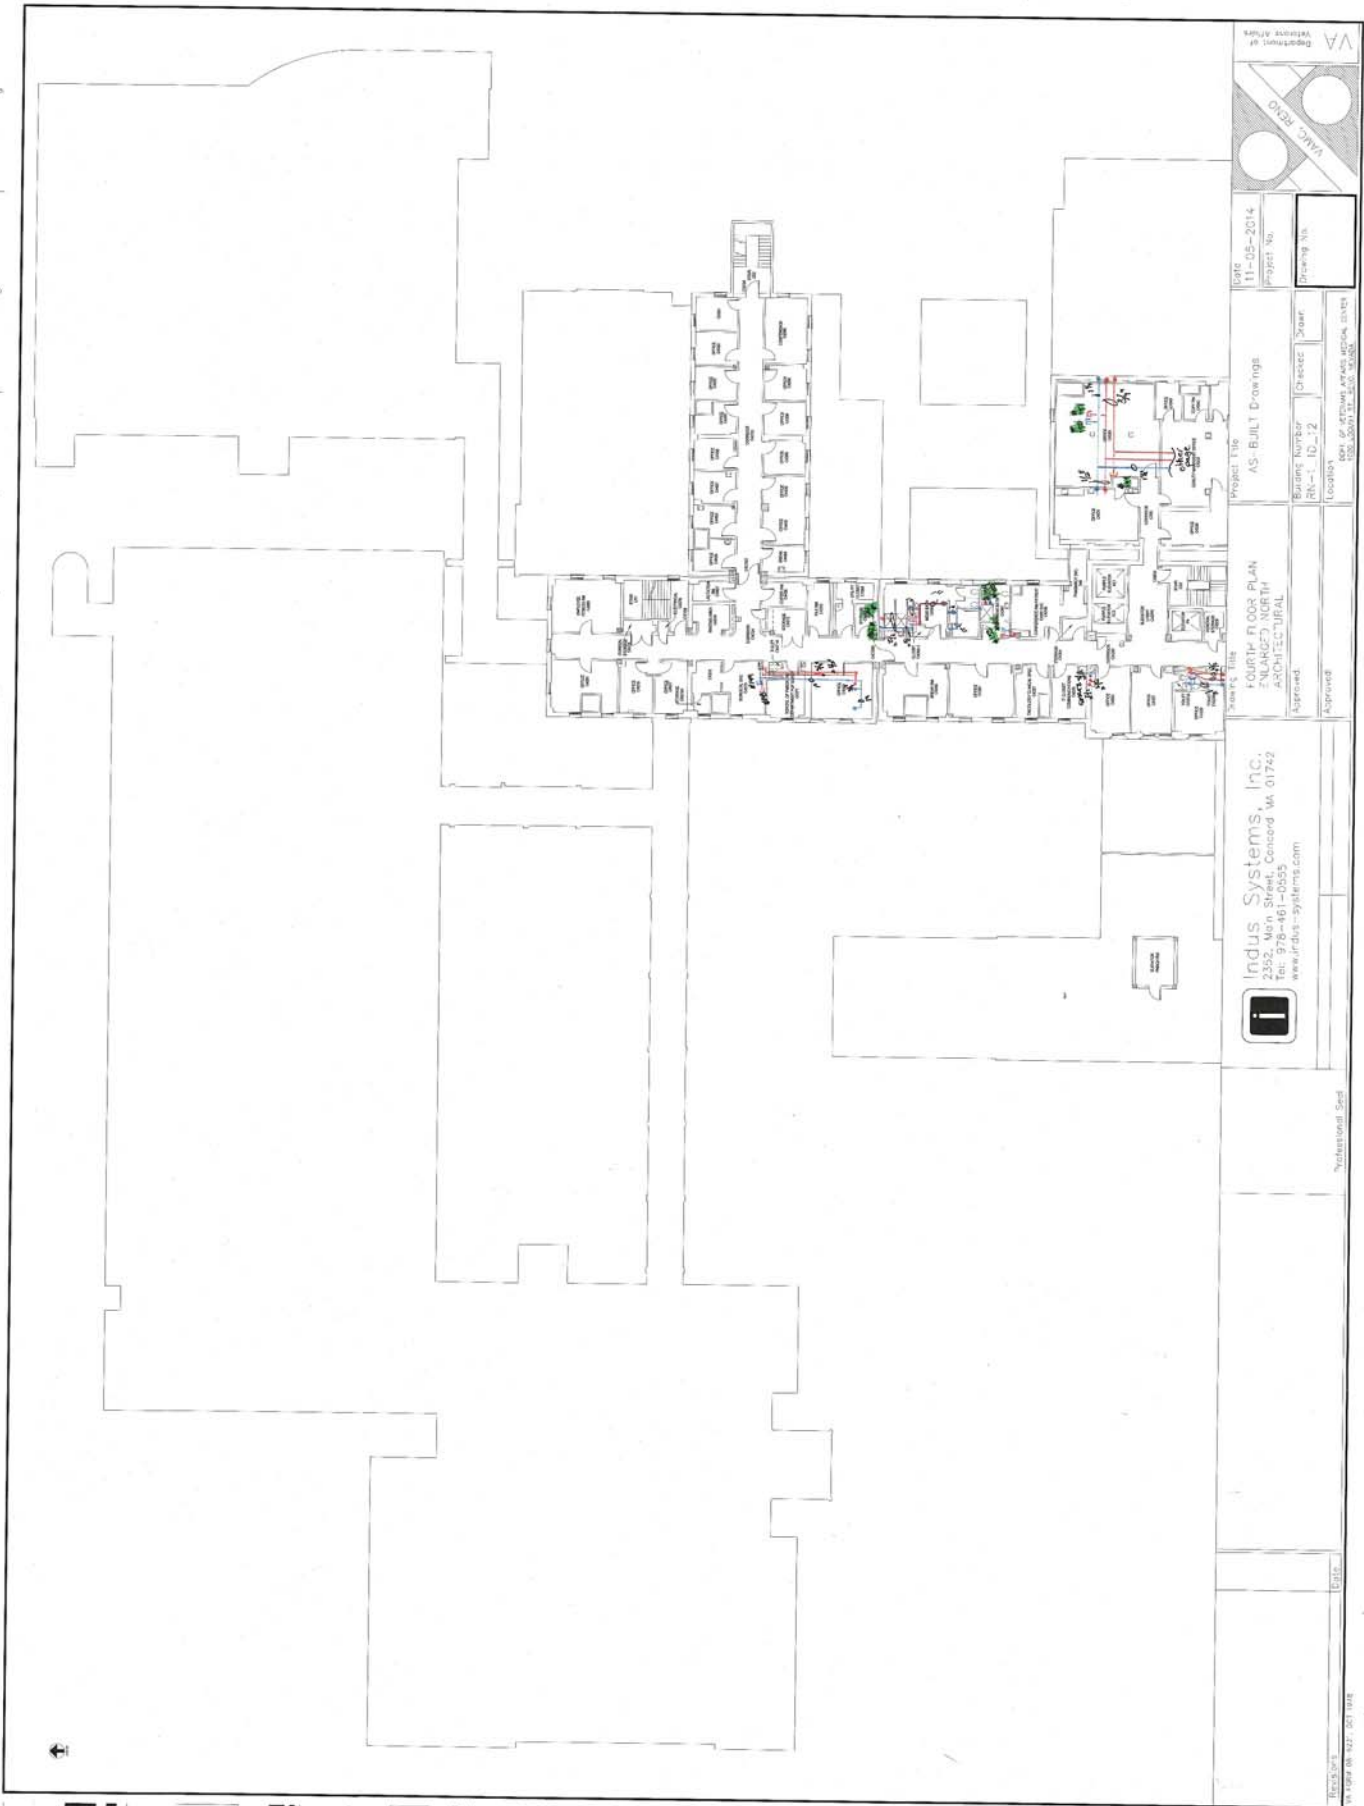

Project No. 111-05-2014
Drawing No. []


Project Title AS-Built Drawings
Building Number 111-112-12
Location []
Date of Drawing: 05/05/2014
Scale: 1/8" = 1'-0"

Sheet Title FOURTH FLOOR PLAN
ENLARGED NORTH
ARCHITECTURAL
Approved: []
Professional Seal []


Indus Systems, Inc.
2392 Main Street, Concord, MA 01742
Tel: 978-461-0555
www.indus-systems.com

Professional Seal []

DATE: []

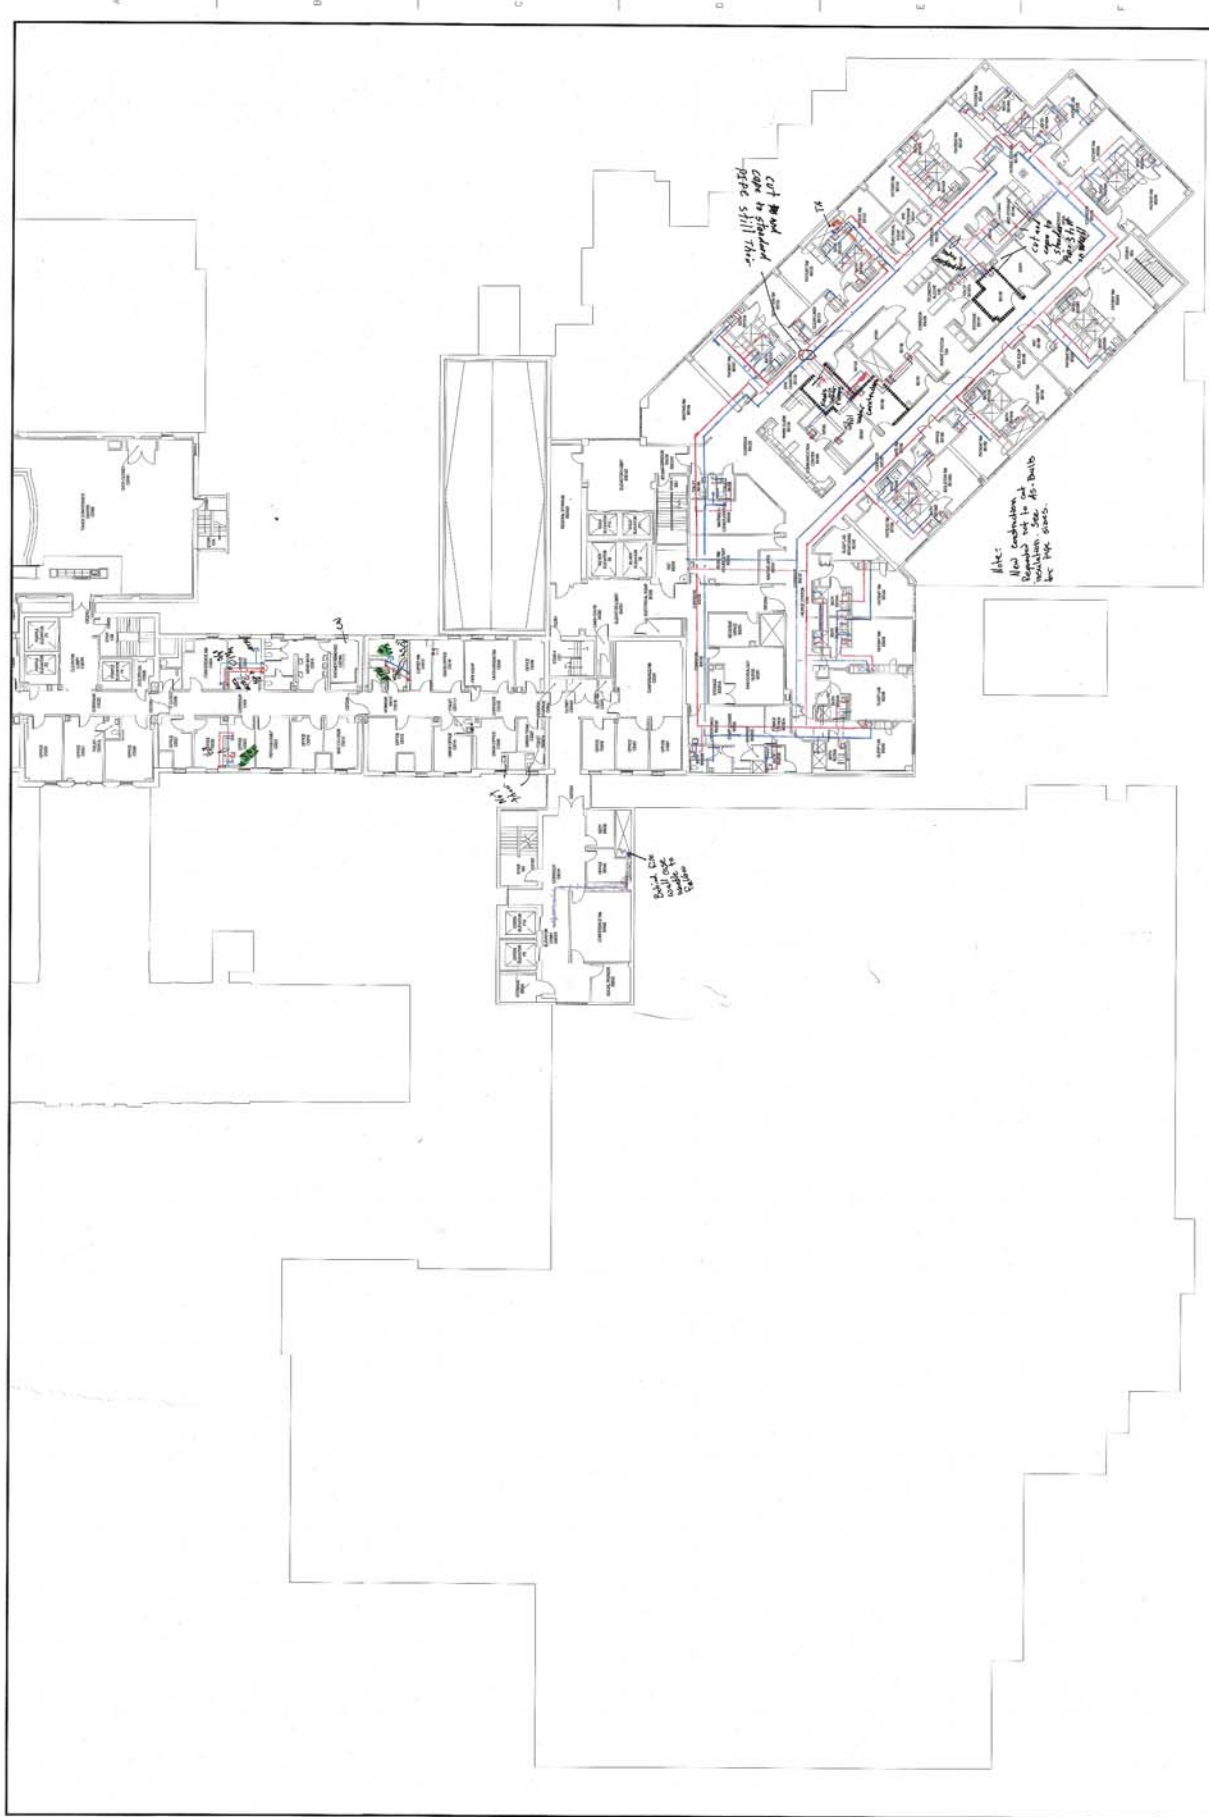

	Project No. 03-18-2015	Project Title AS-BU-T Drawings	Drawing No. 03-18-2015
	Drawing Title FTH 0006 PLAN ELEC. PLAN ARCHITECTURAL	Drawing Number 03-18-2015	Checked 03-18-2015
		Approved Approved	
Indus Systems, Inc. 2359 Main Street, Concord, MA 01742 www.indus-systems.com		Professional Seal	

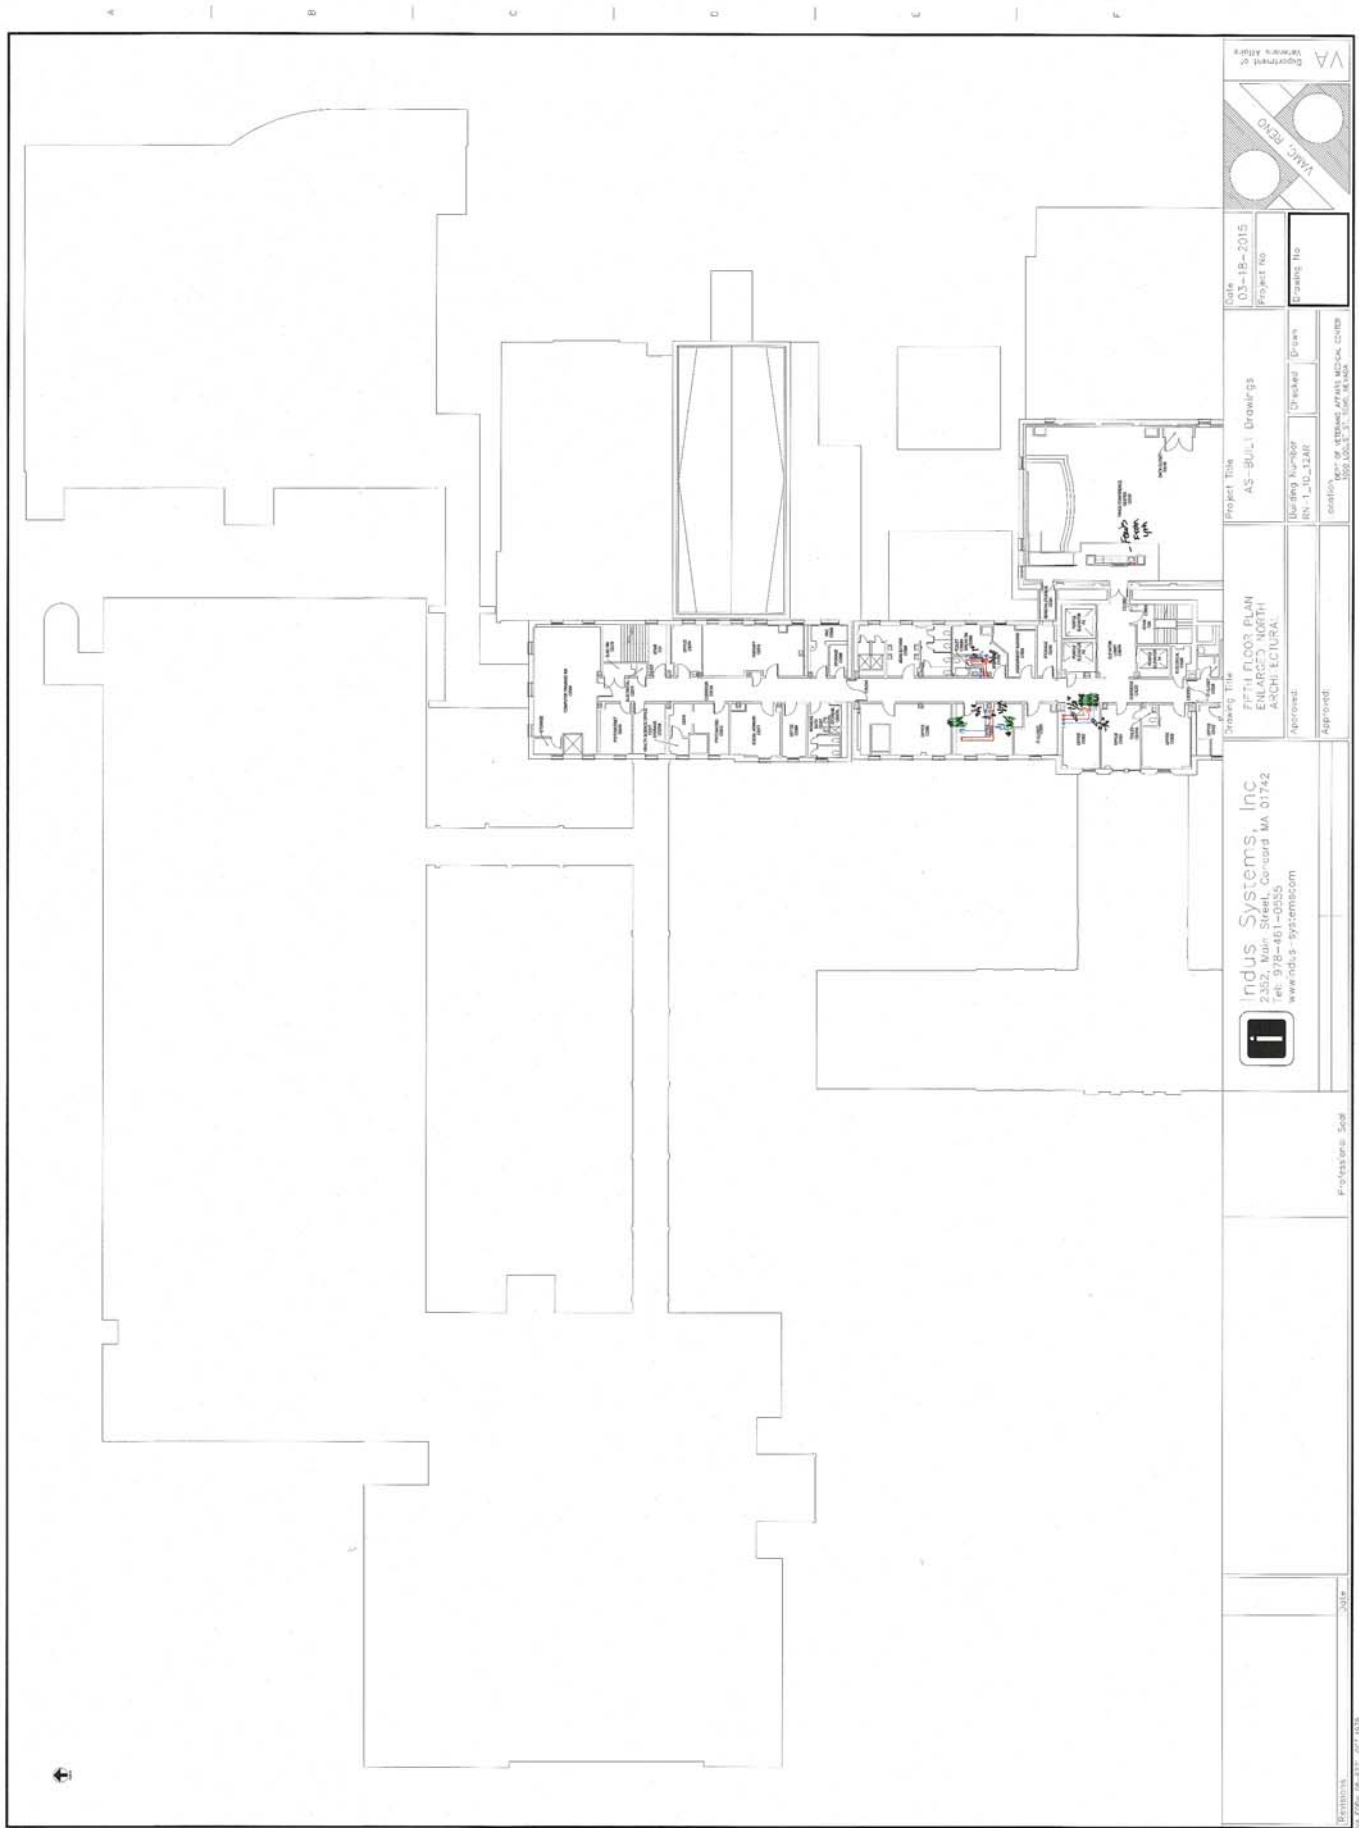

Date: 03-18-2015
 Project No:
 Drawing No:

Project Title: AS-BUL1 Drawings
 Drawing Number: 05-10-1248
 Drawing Name: 05-10-1248

Drawing Title: FIFTH FLOOR PLAN ENLARGED NORTH ARCH. LOTURA
 Approved:
 Approved:

Indus Systems, Inc.
 2352 Main Street, Concord MA 01742
 Tel: 978-461-0555
 www.indus-systems.com

Professional Seal

05-10-1248

	
Date: 03-18-2015 Project No.: Drawing No.:	Project Title: AS-BUILT Drawings
Drawing Number: RN-1-12	Drawing Date: 03-18-2015
Drawing Title: SIXTH FLOOR PLAN ENLARGED SOUTH ARCHITECTURAL	Drawing Scale: AS SHOWN
Designer: Approved:	Checked: Drawn: Date of Approval:
Indus Systems, Inc. 2353 Main Street Concord, MA 01742 Tel: 978-461-0555 www.indus-systems.com	Professional Seal:

