


NOTE
Elevators
To above



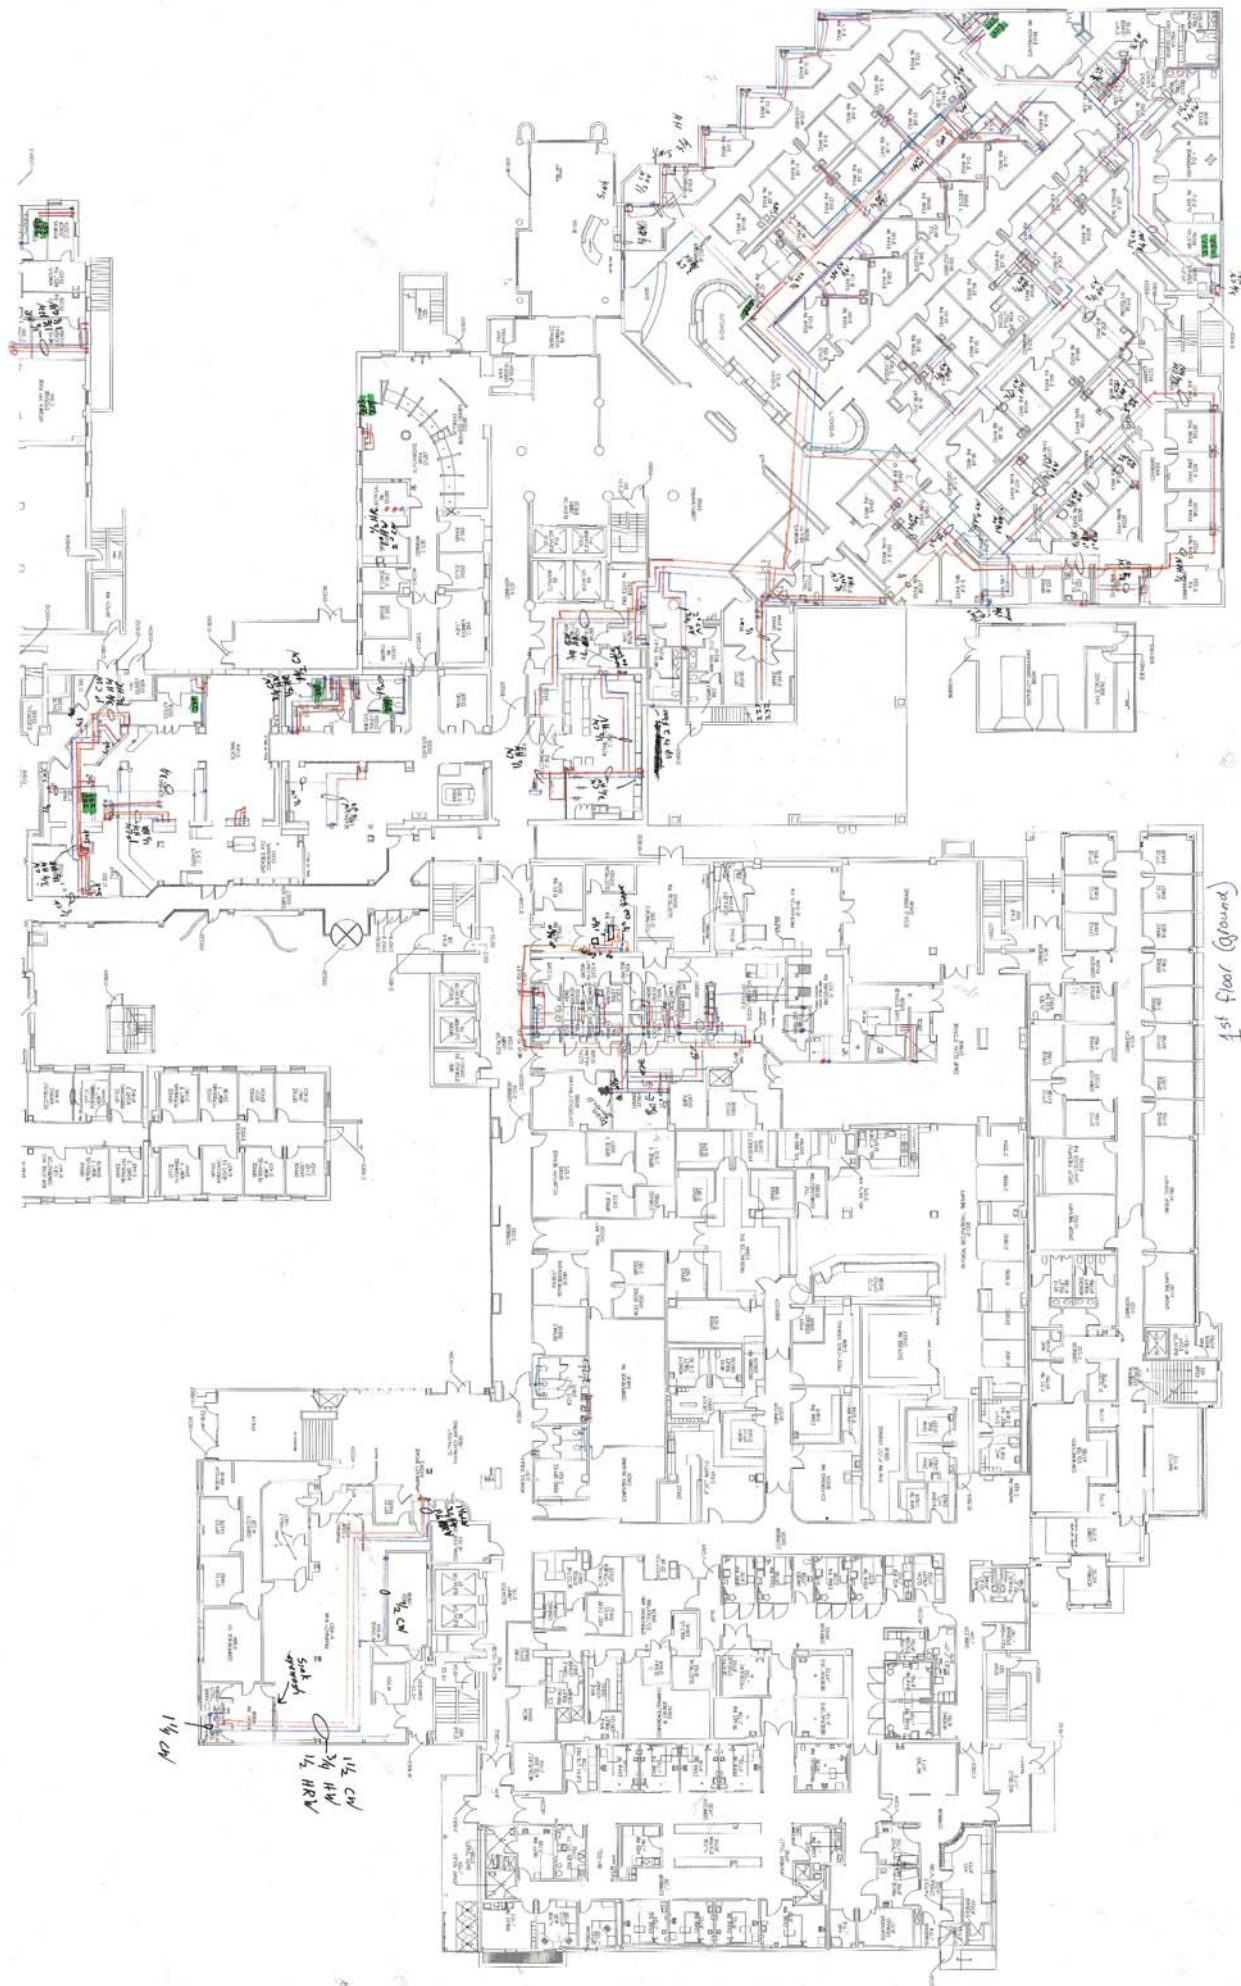


1st floor (ground)

1 1/2 AC
1/4 HRV
1/2 HW
1/2 AC
SOUTH SIDE

NOTE
F-B = Floor Below
T-A = To Above



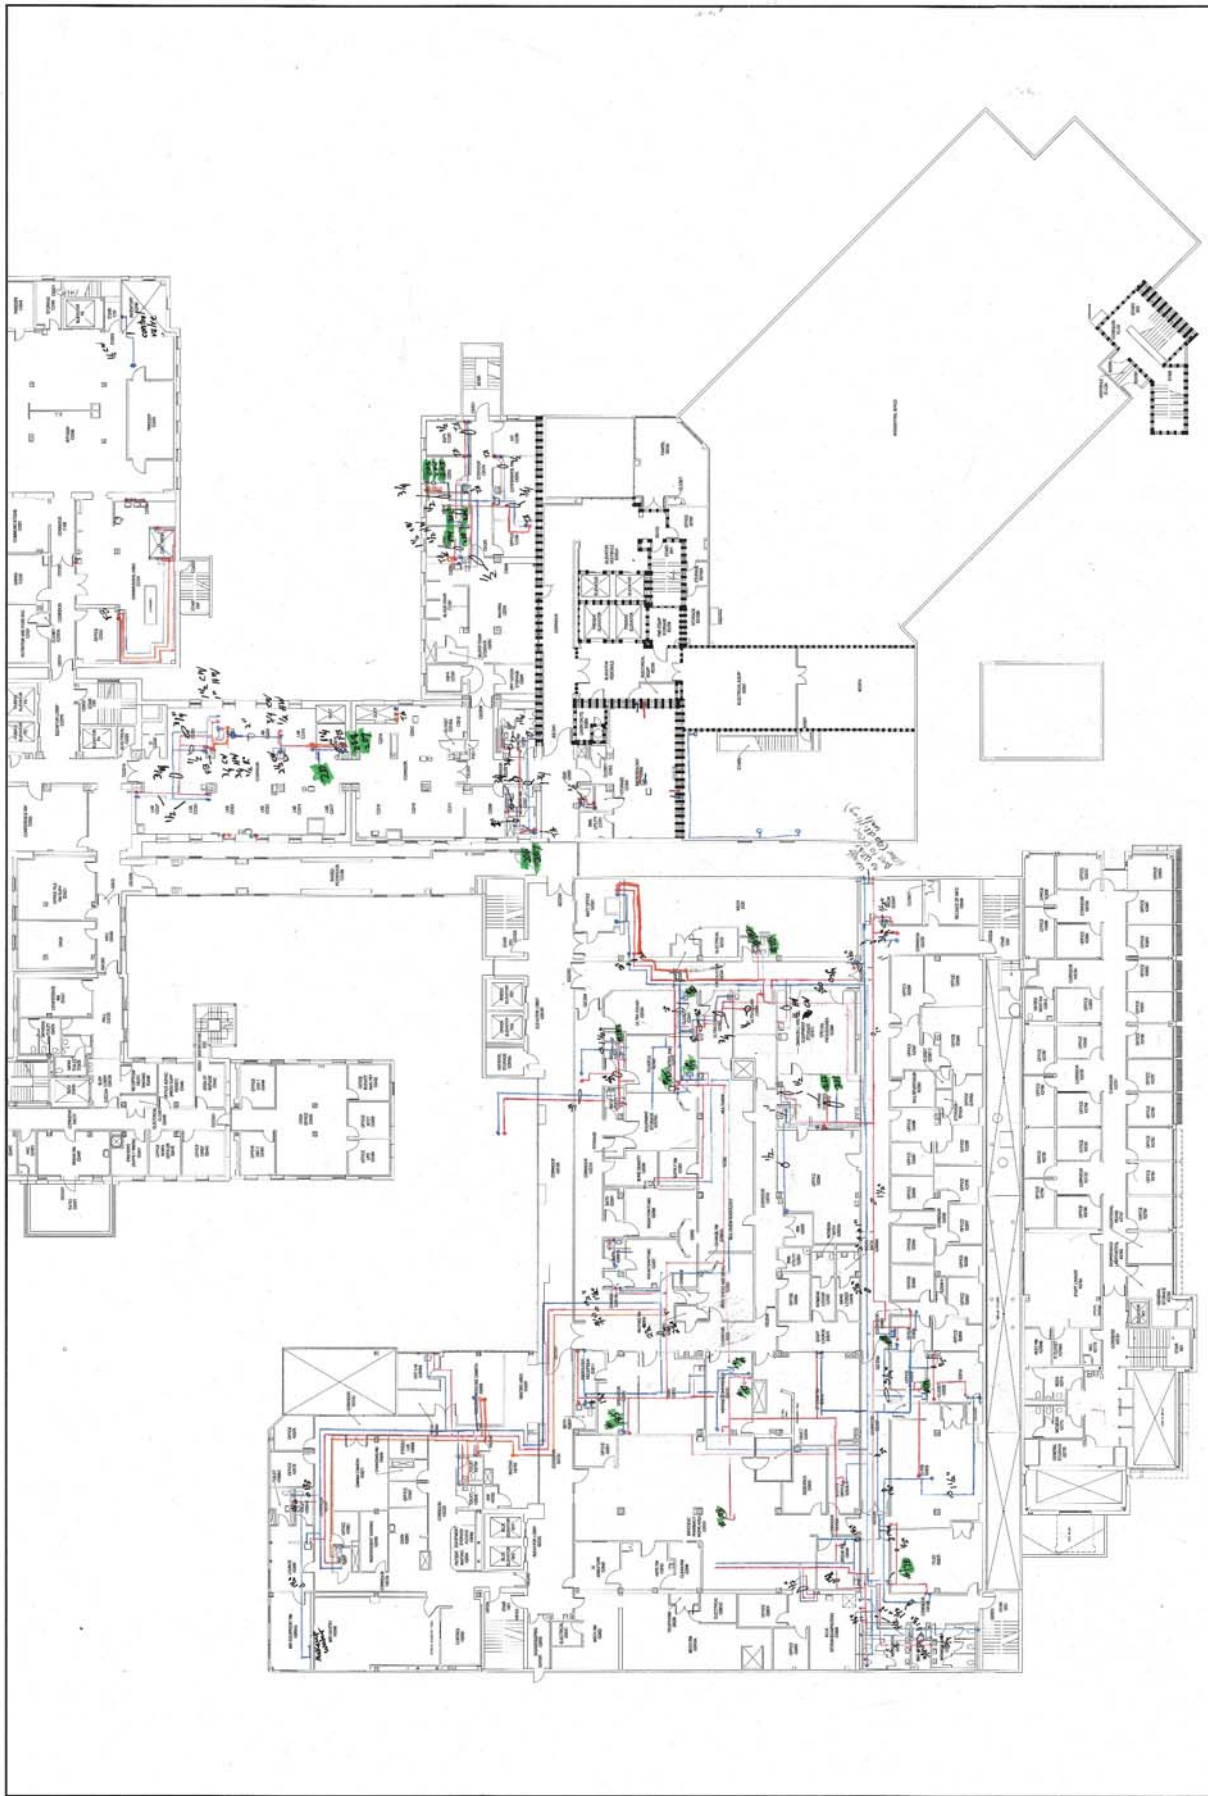

 <p>Indus Systems, Inc. 2355 Industrial Road, Concord MA 01742 Tel: 978-481-0555 www.indus-systems.com</p>	<p>Drawing Title SECOND FLOOR PLAN ENLARGED SOUTH ARCHITECTURAL</p>	<p>Project Title AS-BUILT Drawings</p>	<p>Date 11-15-2014</p>	<p>Department of VA</p>
	<p>Approved </p>	<p>Drawn </p>	<p>Project No. 11-15-2014</p>	<p>Drawing No. 11-15-2014-01</p>

Professional Seal



Title: 11-15-2014
 Project No.:
 Drawing No.:

Project No.: AS-BUILT Drawings
 Revision Number: J.A., 12, 14
 Location: 300 W. 31st St., 5th Floor, CHS

Drawing Title: SECOND FLOOR PLAN ENLARGED NORTH ARCHITECTURAL
 Approved:

Indus Systems, Inc.
 205 Main Street, Concord MA 01742
 Tel: 978-461-0555
 www.indus-systems.com

Professional Seal

Reviser's:



	Date	11-04-2014
	Project No.	
Project Title	AS-BUILT Drawings	Drawing No.
Drawing Title: 11-30 FLOOR PLAN ENLARGED SOUTH ARCHITECTURAL	B.J. org. Number Bn-A_A_10_12 0000001	Checked Drawn
Drawing Title: 11-30 FLOOR PLAN ENLARGED SOUTH ARCHITECTURAL	Indus Systems, Inc. 2352 Main Street, Concord MA 01742 Tel: 978-461-0555 www.indus-systems.com	Approved: Approved:
Professional Seal 	Professional Seal	

