


one and one half inches = one foot  
one inch = one foot  
three quarters inch = one foot  
one half inch = one foot  
three eighths inch = one foot  
one quarter inch = one foot  
one eighth inch = one foot



CONSULTANTS:

ARCHITECT/ENGINEERS:

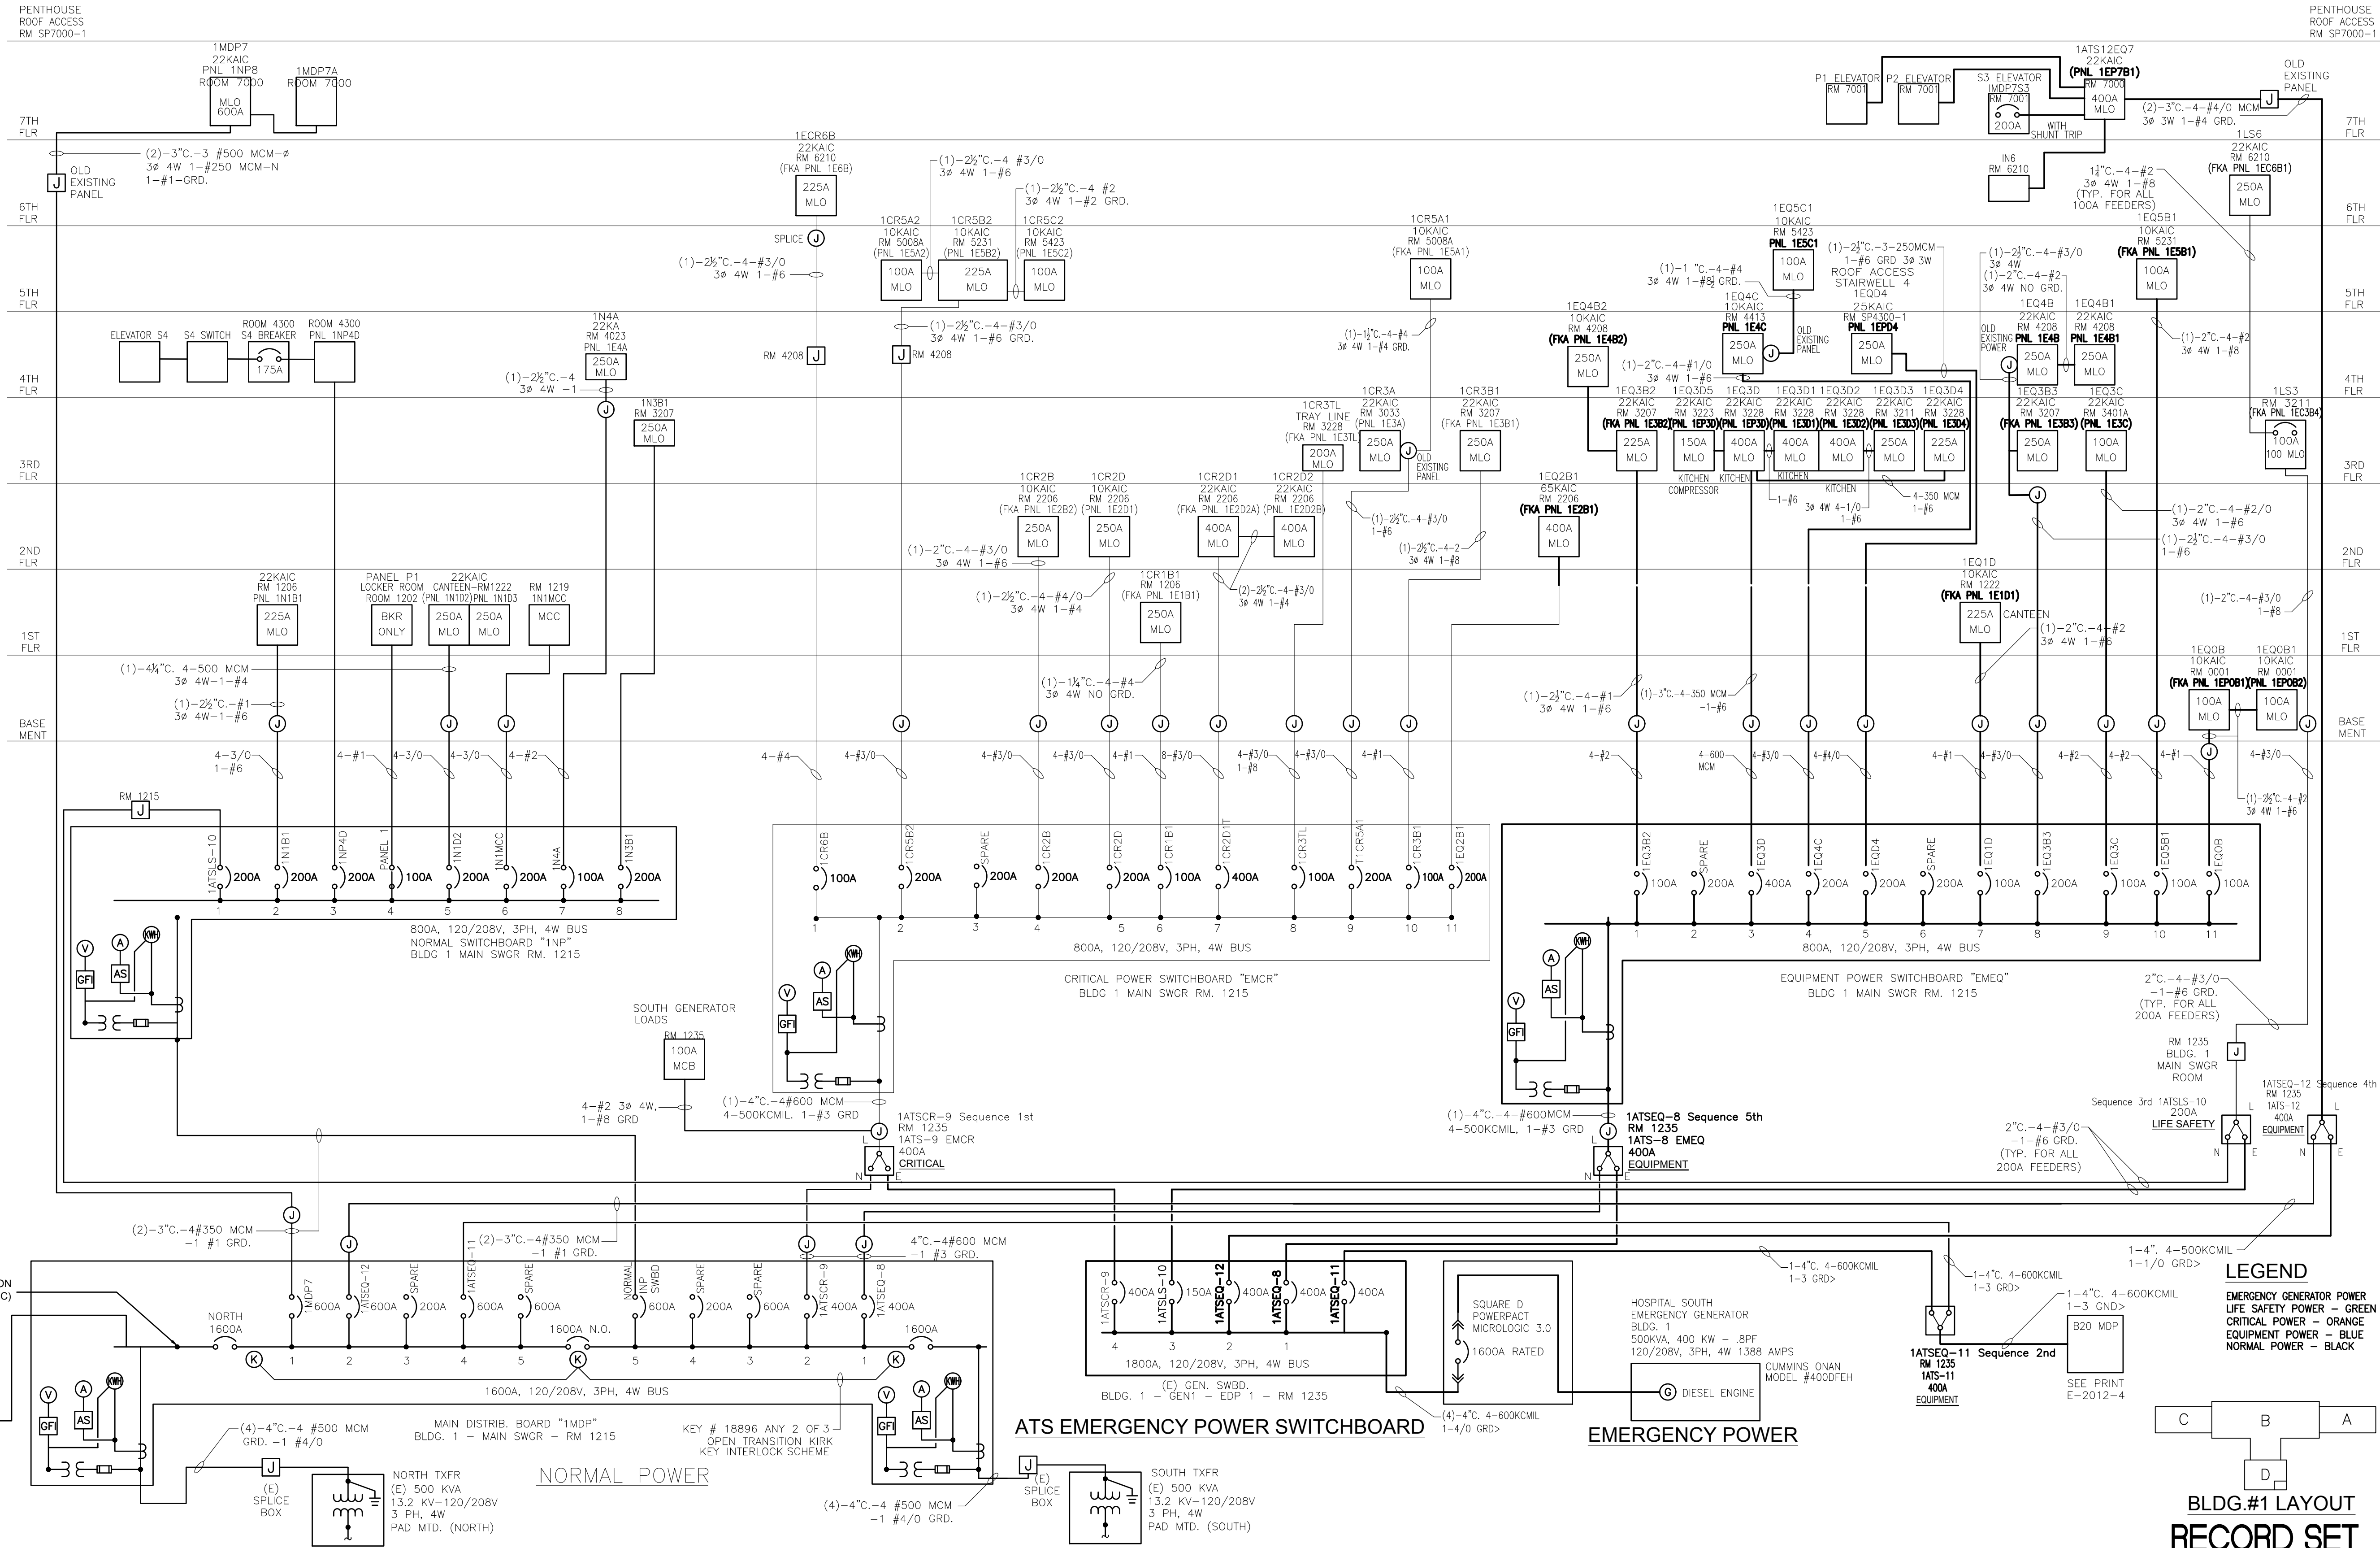

Drawing Title  
ELEC ONE LINE DIAGRAM

Approved Project Director  
STEVEN BOYER, ASSISTANT CHIEF  
ENGINEERING SERVICES  
PHONE: 970-263-5016 FAX: 970-256-8917

Project Title  
GRAND JUNCTION VAMC  
RECORD FILE DRAWINGS

Location  
GRAND JUNCTION, CO  
Date  
MAY 2016  
Checked  
RJO  
Drawn  
DS

Project Number  
575-13-819

Bidding Number  
1

Drawing Number  
E401  
Dwg. of


Office of  
Construction  
and Facilities  
Management







one and one half inches = one foot  
one inch = one foot  
three quarters inch = one foot  
one half inch = one foot  
three eighths inch = one foot  
one quarter inch = one foot  
one eighth inch = one foot

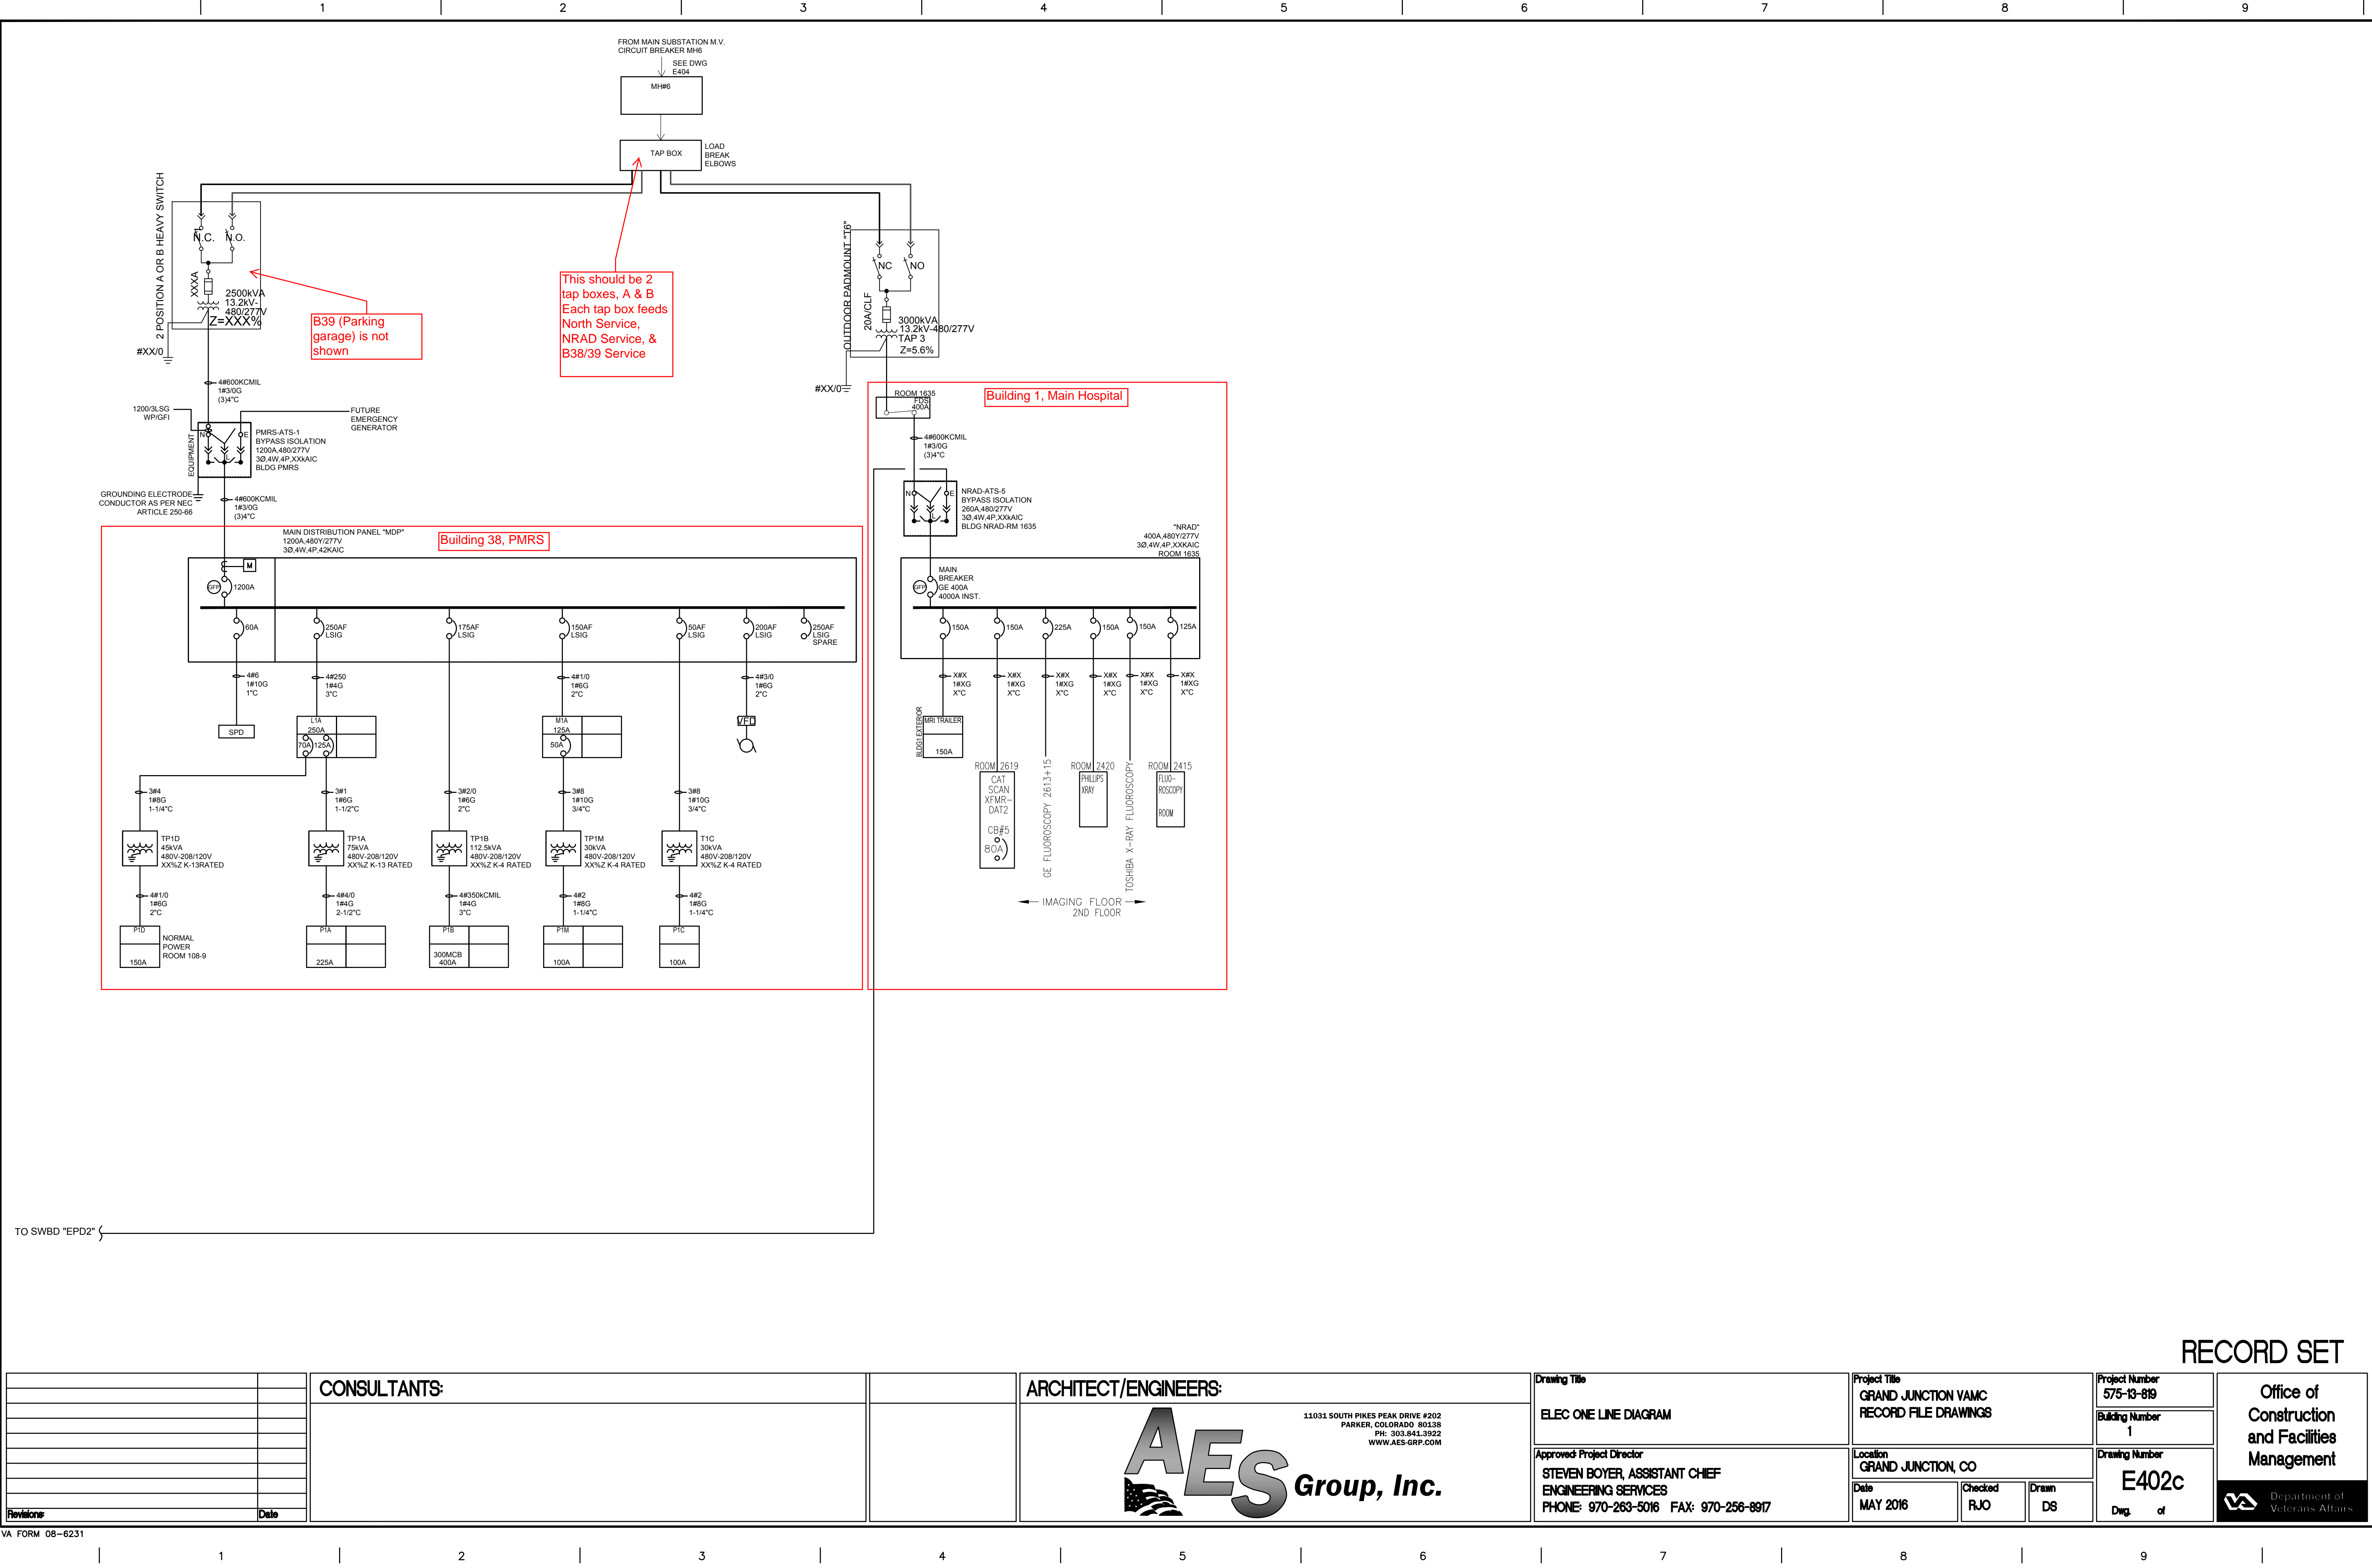


RECORD SET

																																																																																																																																																																																																																																																																																																																																																																																																																																																																																																																																																																																																																																																																																																																																																																																																																																																																																																																																																																																																																																																																																																																																																																																																																																																																																																																																																																																																																																																													</
--	--	----








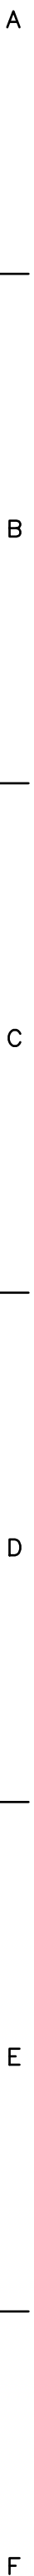


one and one half inches = one foot  
one inch = one foot  
three quarters inch = one foot  
one half inch = one foot  
three eighths inch = one foot  
one quarter inch = one foot  
one eighth inch = one foot

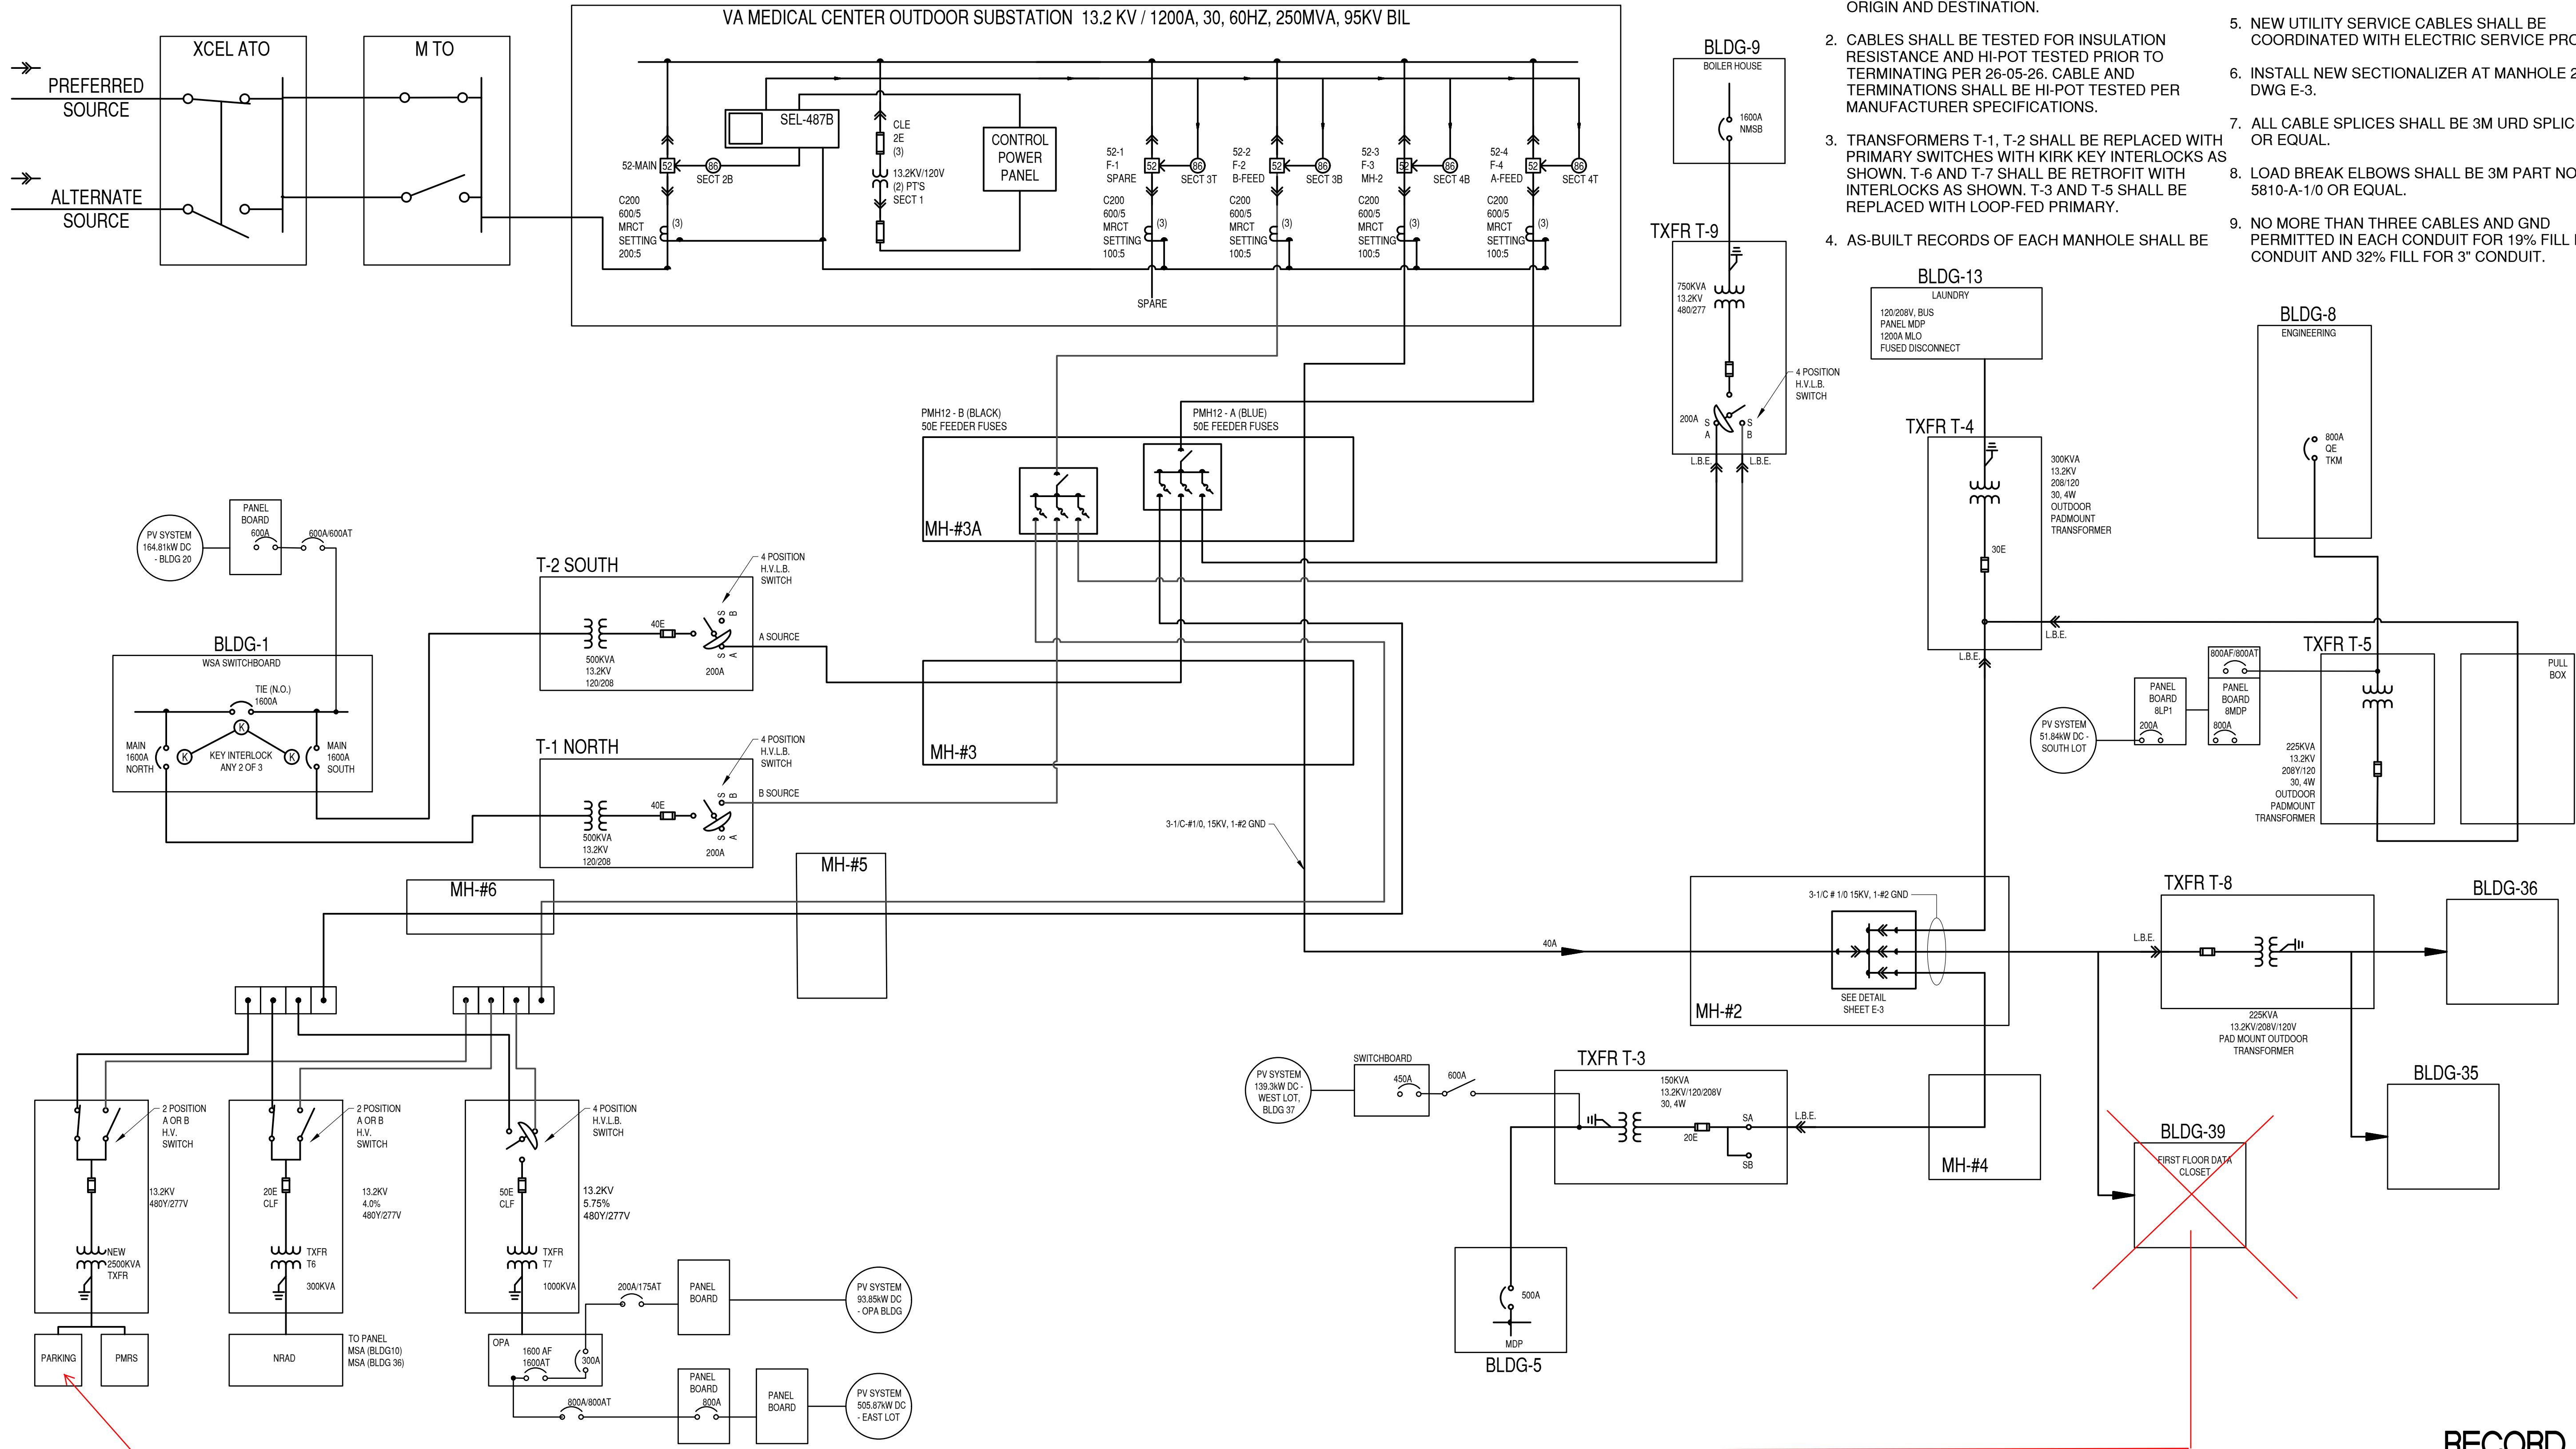

- NOTES:
1. CABLES AND MANHOLES SHALL BE ADEQUATELY SUPPORTED, LASHED AND MARKED FOR PHASE, ORIGIN AND DESTINATION.
  2. CABLES SHALL BE TESTED FOR INSULATION RESISTANCE AND HI-POT TESTED PRIOR TO TERMINATING PER 26-05-26. CABLE AND TERMINATIONS SHALL BE HI-POT TESTED PER MANUFACTURER SPECIFICATIONS.
  3. TRANSFORMERS T-1, T-2 SHALL BE REPLACED WITH PRIMARY SWITCHES WITH KIRK KEY INTERLOCKS AS SHOWN. T-6 AND T-7 SHALL BE RETROFIT WITH INTERLOCKS AS SHOWN. T-3 AND T-5 SHALL BE REPLACED WITH LOOP-FED PRIMARY.
  4. AS-BUILT RECORDS OF EACH MANHOLE SHALL BE
  5. NEW UTILITY SERVICE CABLES SHALL BE COORDINATED WITH ELECTRIC SERVICE PROVIDER.
  6. INSTALL NEW SECTIONALIZER AT MANHOLE 2 PER DWG E-3.
  7. ALL CABLE SPLICES SHALL BE 3M URD SPLICE KIT OR EQUAL.
  8. LOAD BREAK ELBOWS SHALL BE 3M PART NO. 5810-A-1/0 OR EQUAL.
  9. NO MORE THAN THREE CABLES AND GND PERMITTED IN EACH CONDUIT FOR 19% FILL FOR 4" CONDUIT AND 32% FILL FOR 3" CONDUIT.

RECORD SET

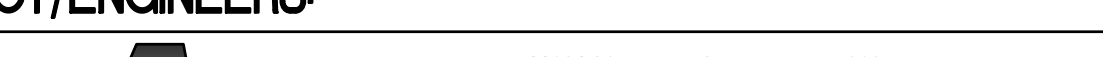		CONSULTANTS:				ARCHITECT/ENGINEERS:		Drawing Title		Project Title		Project Number		Office of Construction and Facilities Management  Department of Veterans Affairs	
						<div><div>11031 SOUTH PIKES PEAK DRIVE #202 PARKER, COLORADO 80138 PH: 303.941.3922 WWW.AES-GRP.COM</div></div>		ELEC ONE LINE DIAGRAM		GRAND JUNCTION VAMC RECORD FILE DRAWINGS		575-13-819			
				Approved Project Director				Location		Building Number					
				STEVEN BOYER, ASSISTANT CHIEF ENGINEERING SERVICES PHONE: 970-263-5016 FAX: 970-256-8917				GRAND JUNCTION, CO		1					
Revisions		Date						Date		Checked		Drawn			
								MAY 2016		RJO		DS		E404	
												Dwg. of			