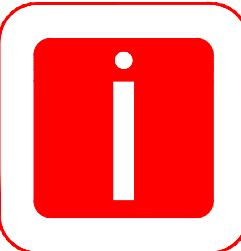
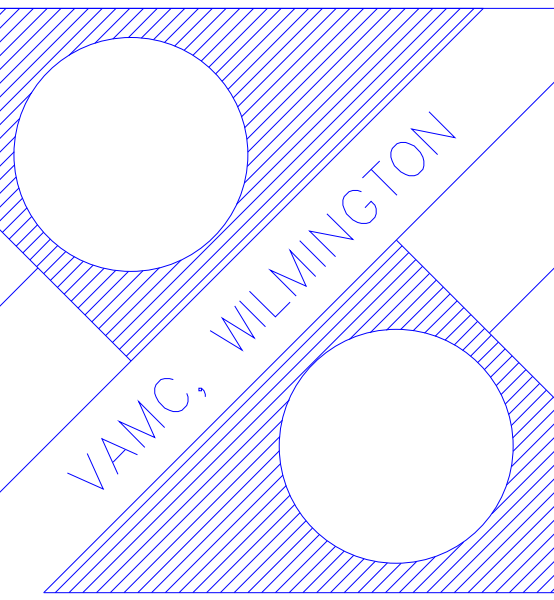


three eighths inch = one foot
one eighth inch = one foot
one quarter inch = one foot
three eighths inch = one foot
one half inch = one foot
one inch = one foot
one and one half inches = one foot
three inches = one foot

Revisions		Date		Professional Seal		 <div>Indus Systems, Inc. 2352, Main Street, Concord MA 01742 Tel: 978-461-0555 www.indus-systems.com</div>		Drawing Title GROUND FLOOR PLAN ARCHITECTURAL		Project Title AS-BUILT Drawings		Date 04-24-2006				VA Department of Veterans Affairs			
						Approved:		Building Number 07		Checked		Drawn						Project No.	
						Approved:		Location VAMC WILMINGTON DELAWARE										Drawing No. 460-7-G-AR	