

A

B

C

D

E

F

A

B

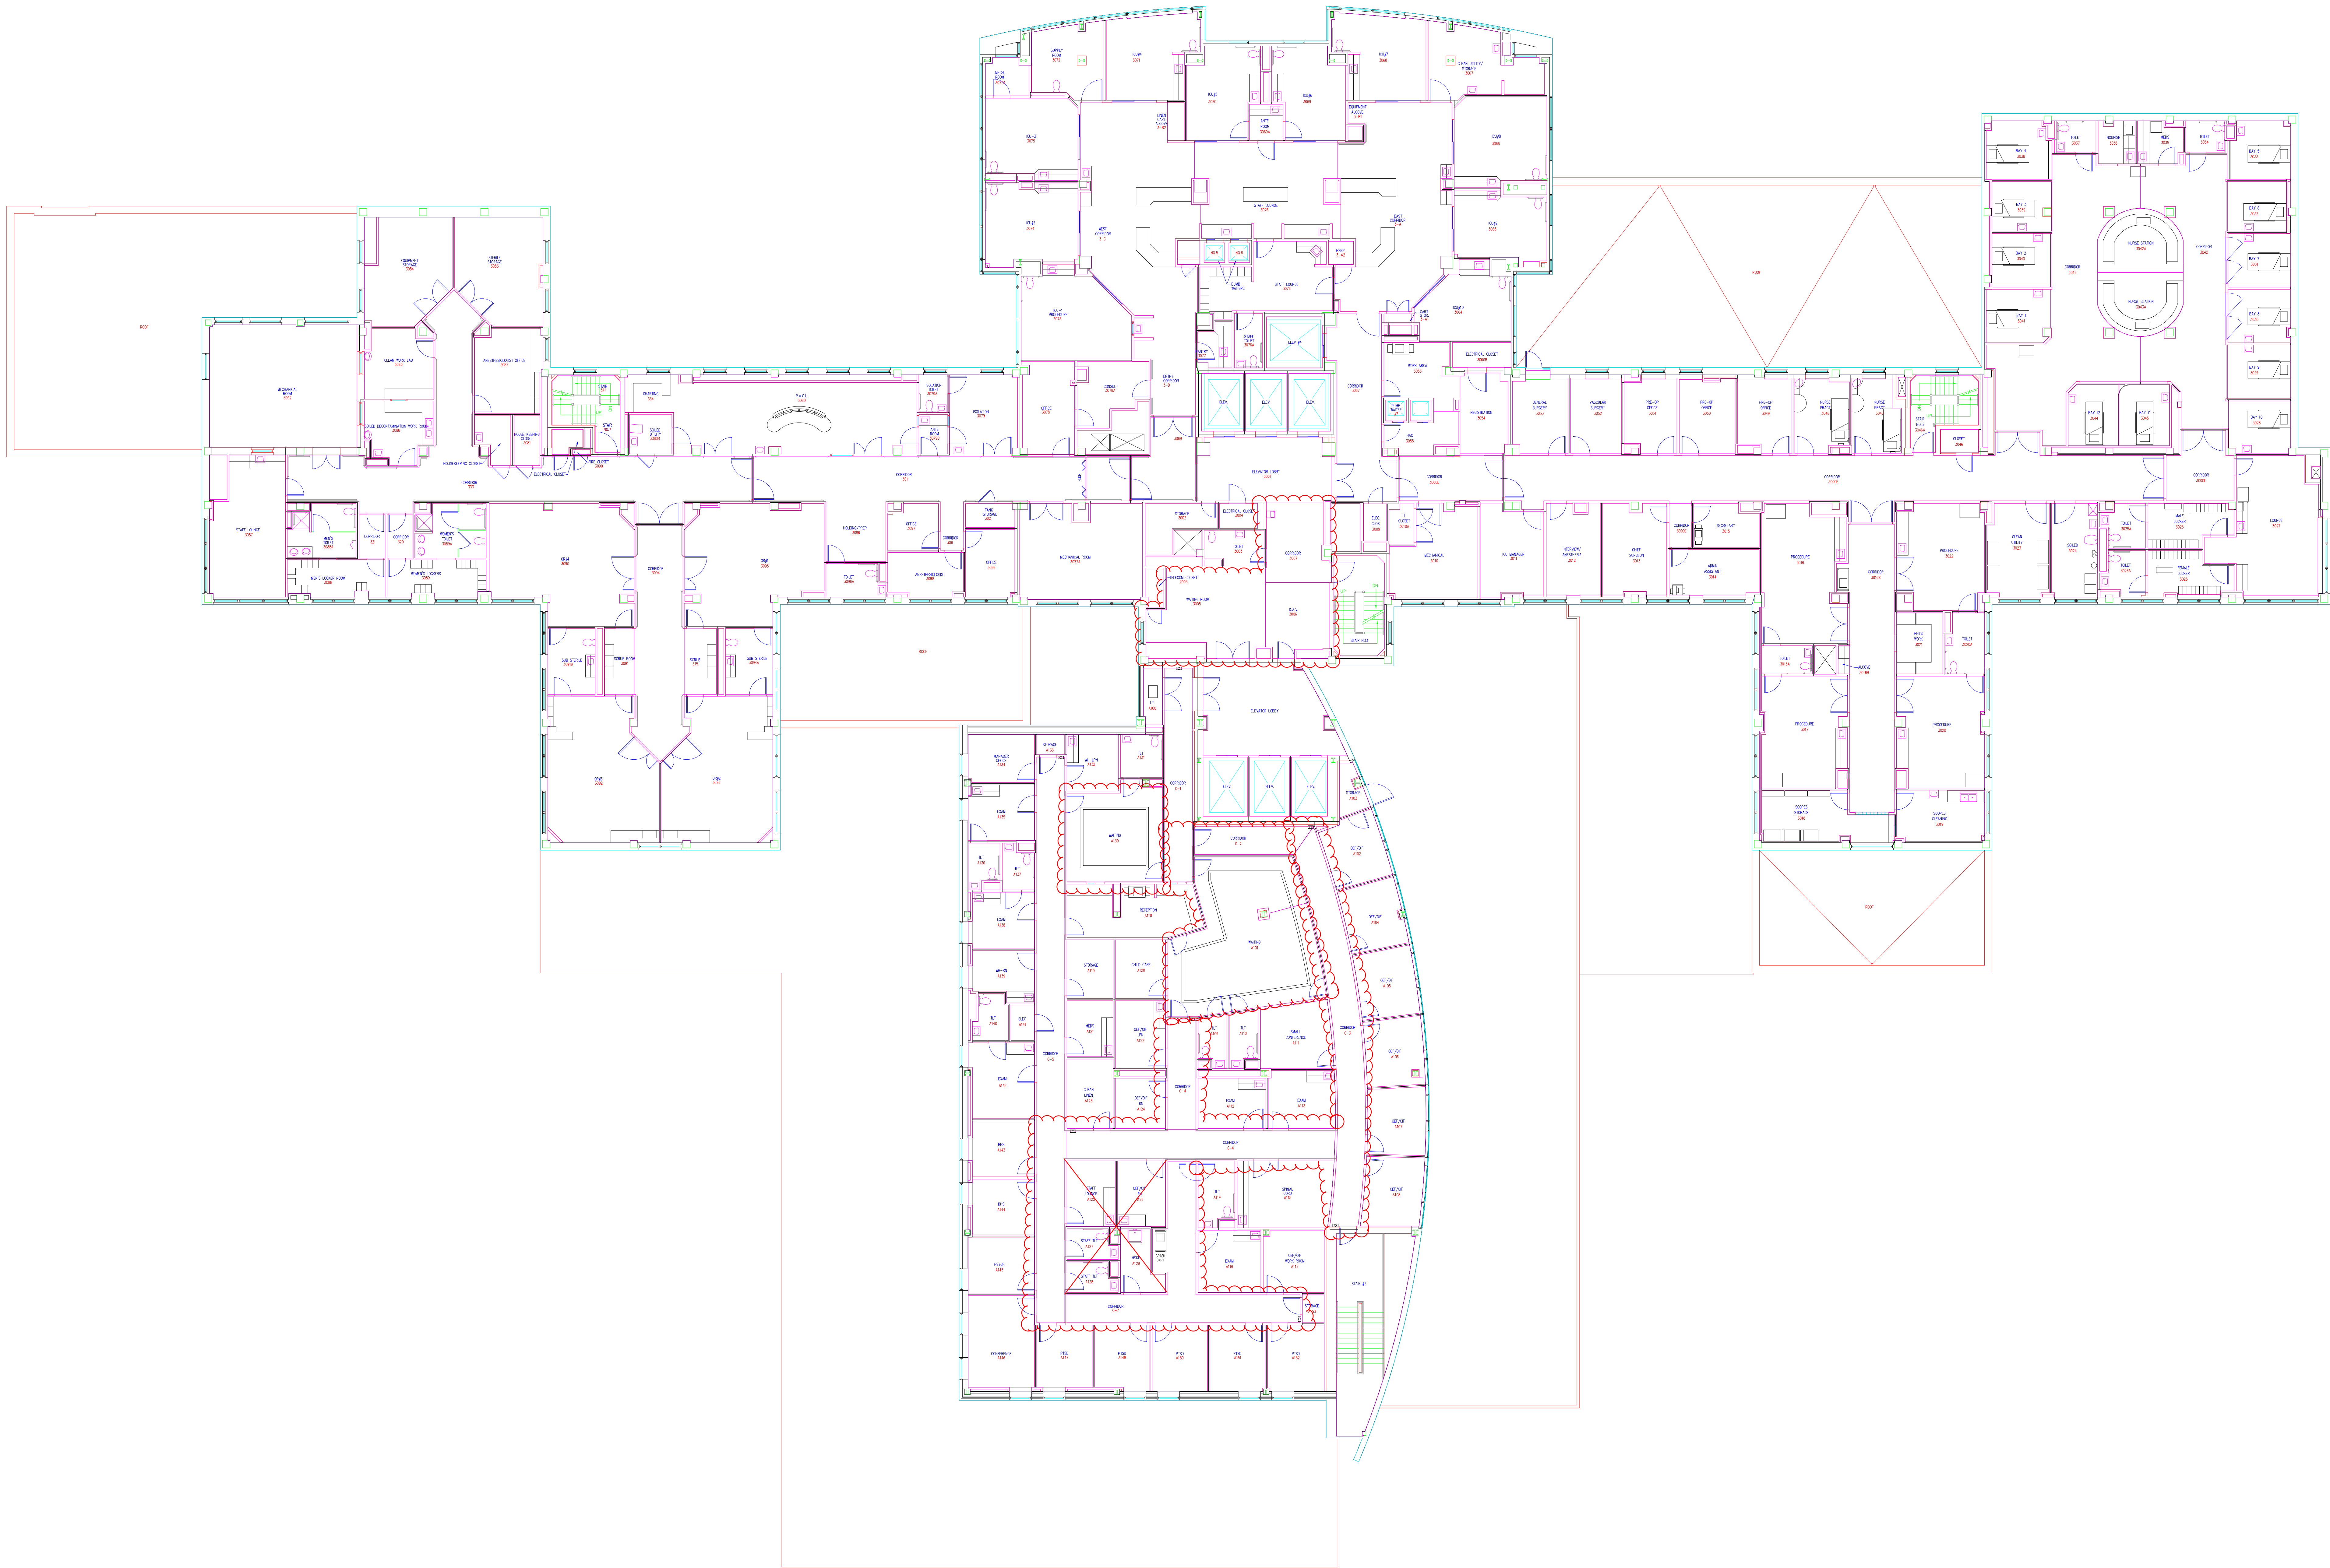
C

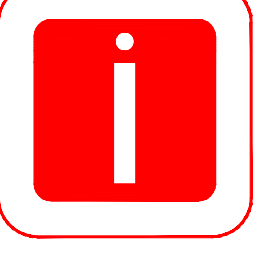
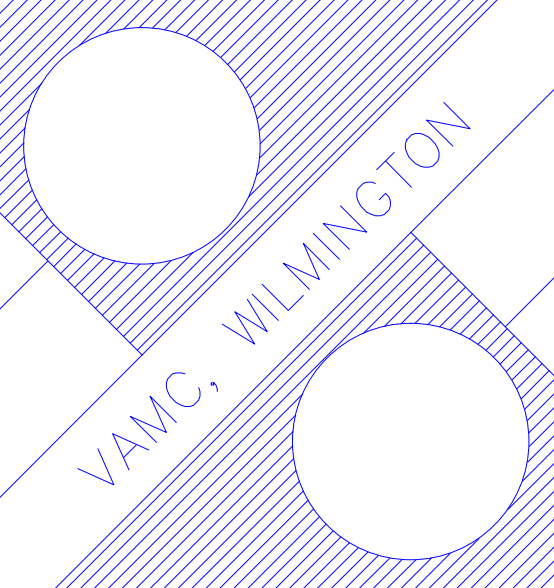
D

E

F

three inches = one foot
one and one half inches = one foot
one inch = one foot
three quarters inch = one foot
one half inch = one foot
three eighths inch = one foot
one quarter inch = one foot
one eighth inch = one foot



Revisions		Date		Professional Seal		 Indus Systems, Inc. 2352, Main Street, Concord MA 01742 Tel: 978-461-0555 www.indus-systems.com		Drawing Title THIRD FLOOR PLAN ARCHITECTURAL		Project Title AS-BUILT Drawings		Date 01-20-2012				Department of Veterans Affairs			
Approved:				Approved:				Building Number 01		Checked		Drawn						Drawing No. 460-1-3-AR	
Approved:				Approved:				Location VAMC WILMINGTON DELAWARE											