

A

B

C

D

E

F

A

B

C

D

E

F

three inches = one foot

one and one half inches = one foot

one inch = one foot


three quarters inch = one foot

one half inch = one foot

three eighths inch = one foot

one quarter inch = one foot

one eighth inch = one foot

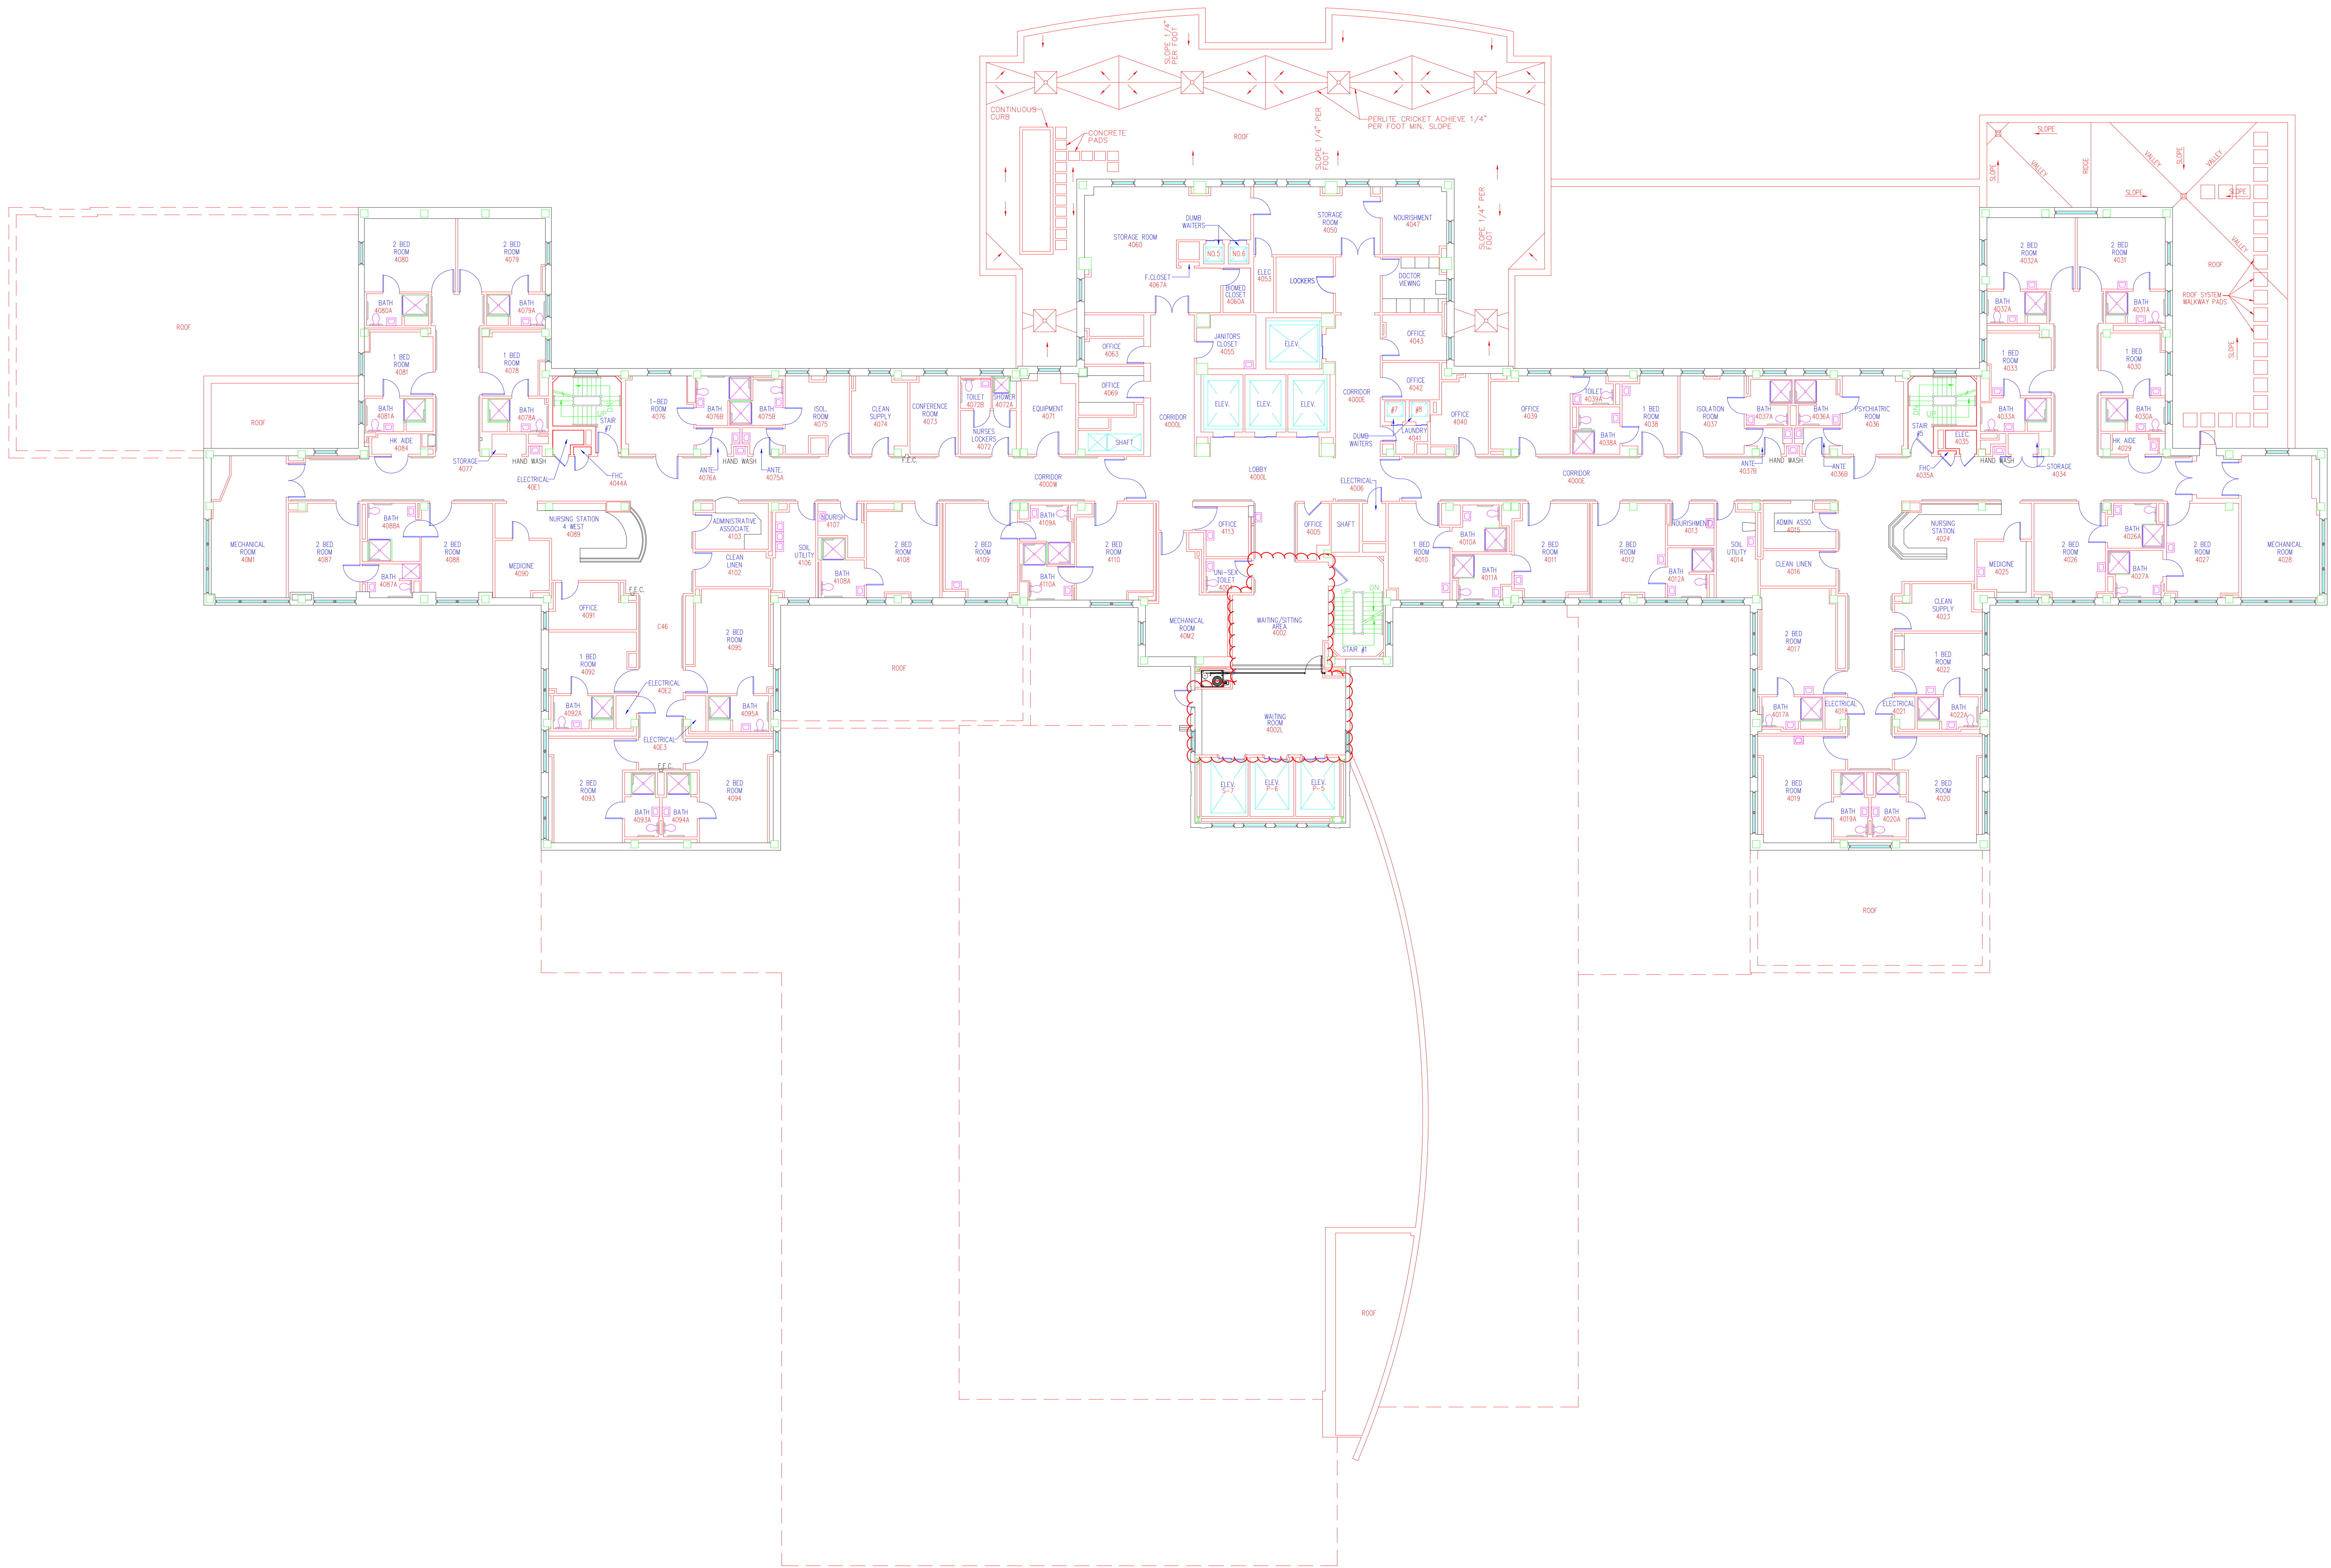

				<div><div><div>i</div></div><div>Indus Systems, Inc. 2352, Main Street, Concord MA 01742 Tel: 978-461-0555 www.indus-systems.com</div></div>	Drawing Title FOURTH FLOOR PLAN ARCHITECTURAL		Project Title AS-BUILT Drawings		Date 10-17-2016	<div><div><div></div></div><div>VAMC, WILMINGTON</div><div><div></div></div></div> <div>VA Department of Veterans Affairs</div>
					Site:		Building Number 01	Checked	Drawn	
Revisions		Date	Professional Seal	Approved:		Location VAMC WILMINGTON DELAWARE		Drawing No. 460-1-4-AR		