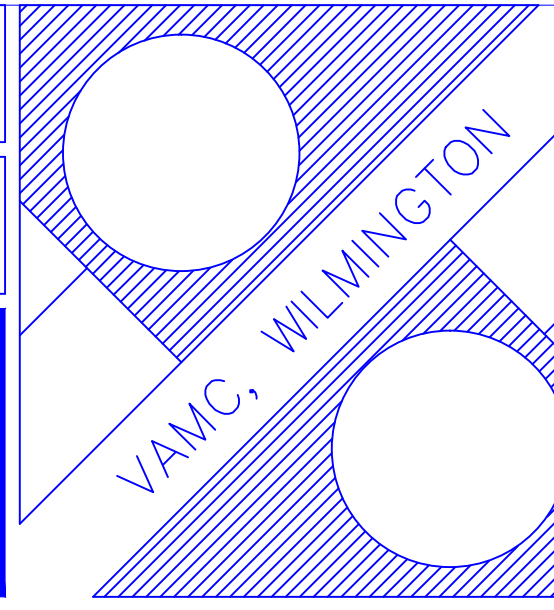
 Indus Systems, Inc. 2352, Main Street, Concord MA 01742 Tel: 978-461-0555 www.indus-systems.com		Drawing Title FIRST FLOOR PLAN ARCHITECTURAL		Project Title AS-BUILT Drawings		Date 01-16-2016			VA Department of Veterans Affairs	
						Approved:		Building Number 07		Checked Drawn				Drawing No. 460-7-1-AR
						Approved:		Location VAMC WILMINGTON DELAWARE						
Revisions		Date		Professional Seal										