



B3 NORTH ELEVATION

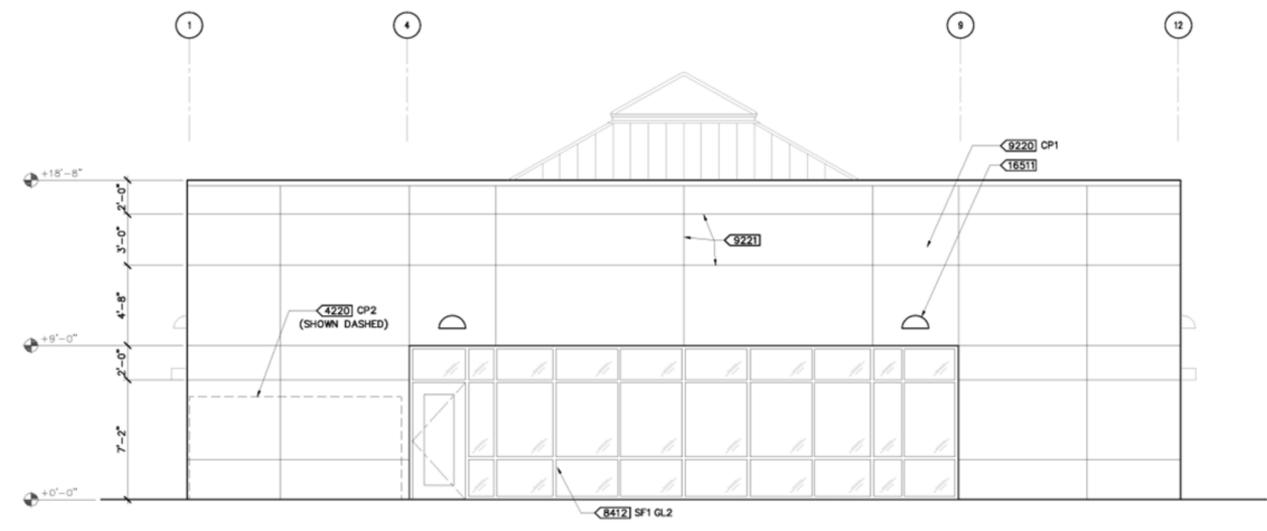


B8 SOUTH ELEVATION

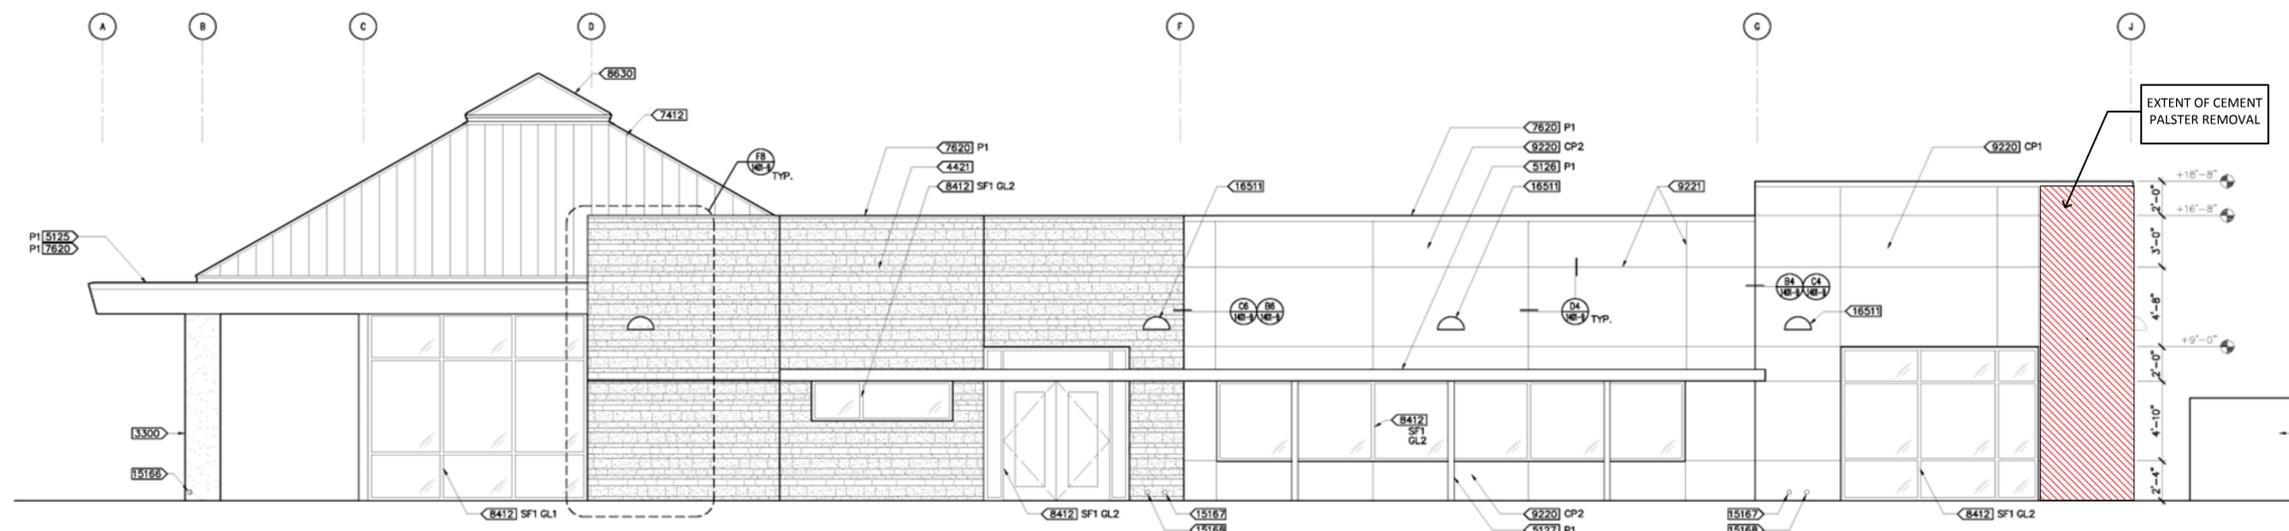

D5 WEST ELEVATION

- EXT. COLORS & FINISHES:**
- ADHERED STONE CLADDING: SEE DETAIL: FR 16511
 - CEMENT PLASTER ACRYLIC TOP COAT: CP1 - MATCH 611 ICI "SEAGULL GRAY" (LIGHT BROWN); CP2 - MATCH 585 ICI "WALLSTREET" (DARK BROWN)
 - STANDING SEAM METAL ROOF: R1 - MATCH AEP SPAN, COOL ZACTIQUE II
 - STOREFRONT: SF1 - MATCH ALCON COMPOSITES CHAMPAGNE METALLIC A3000-DXLE
 - GLAZING: GL1 - CLEAR GLASS; GL2 - GRAY TINTED GLASS
 - PAINT COLORS: P1 - MATCH R1 (ABOVE)

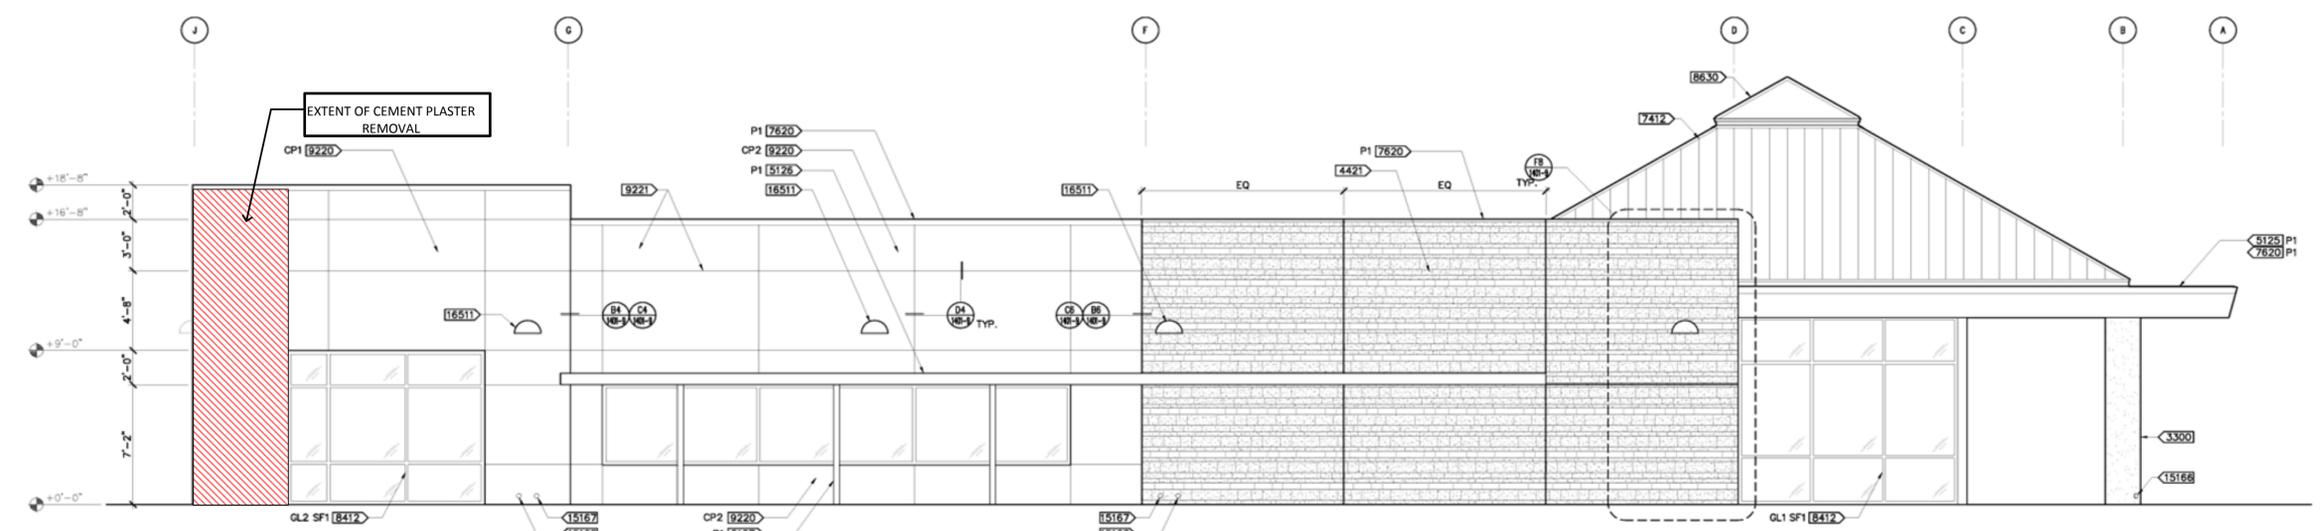

F5 EAST ELEVATION

- KEY NOTES:**
- 3300 CAST-IN-PLACE CONCRETE COLUMN 24" DIA. WITH MEDIUM STUCCO FINISH
 - 4220 CONCRETE UNIT MASONRY WITH PORTLAND CEMENT PLASTER WITH ACRYLIC PLASTER FINISH
 - 4421 ADHERED EXTERIOR STONE CLADDING: FR 16511
 - 5125 ARCHITECTURAL EXPOSED STRUCTURAL STEEL CHANNEL MITER AND WELD CORNERS NO EXPOSED FASTENERS, SEE STRUCT.
 - 5128 ARCHITECTURAL EXPOSED STRUCTURAL STEEL CANOPY SHADE, SEE: CR 16511
 - 5127 ARCHITECTURAL EXPOSED STRUCTURAL STEEL COLUMN
 - 7412 STANDING SEAM METAL ROOF
 - 7820 PAINTED GALVANIZED SHEET METAL COPING
 - 8412 ALUMINUM FRAMED ENTRANCES AND STOREFRONTS
 - 8630 METAL FRAMED SKYLIGHT WITH CLEAR GLASS
 - 9220 PORTLAND CEMENT PLASTER WITH ACRYLIC PLASTER FINISH: M1 16511
 - 9221 REVEAL, TYP. SEE: CR 16511
 - 11518 GRAVESITE LOCATOR (OFD), SEE: CR 16511. NOTE: VERIFY FINAL LOCATION OF GRAVE SITE LOCATORS W/ CONTRACTING OFFICER'S TECHNICAL REP.
 - 15168 RWL CAST INTO CAST-IN-PLACE CONC. COLUMN, DAYLIGHT AT 6" A.F.F.
 - 15167 RWL DOWNSPOUT NOZZLES, SEE: CR 16511. PROVIDE CONC. SPLASH BLOCK AT PLANTER AREAS, TYP.
 - 15168 OVERFLOW DOWNSPOUT NOZZLES, SEE: CR 16511
 - 16511 WALL MOUNTED LIGHT FIXTURE, PER ELEC.

AS - BUILT DRAWINGS

Revisions	Date

MARCH 2010
 AS-BUILT DRAWINGS
 PREPARED FROM AS-BUILT DRAWINGS PROVIDED BY CLARK & SULLIVAN, FEBRUARY, 2010. INFORMATION HAS NOT BEEN FIELD VERIFIED BY A/E.

Carter Burgess
 A Wholely Owned Subsidiary of Jacobs
 Consultants in Architecture, Engineering, Planning, and the Environment
 Sacramento Office
 180 Promenade Circle, Suite 300
 Sacramento, California 95834
 (916) 929-3323 Fax (916) 929-1772

Subconsultant List	
DREYFUSS & BLACKFORD	3540 FOLSOM BLVD., SACRAMENTO, CA. 95816 (916) 453-1234
CAPITAL ENGINEERING CONSULTANTS	11020 SUN CENTER DR., STE. 100 RANCHO CORDOVA, CA. 95670 (916) 851-3500
ECOM ENGINEERING CONSULTANTS	1796 TRIBUTE RD., SUITE 100, SACRAMENTO, CA. 95815 (916) 841-5600
BUEHLER & BUEHLER ASSOCIATES	600 Q STREET, STE. 200, SACRAMENTO, CA. 95814 (916) 443-0303
THE SIERRA WEST GROUP, LLC	2730 GATEWAY OAKS DRIVE, STE. 110 SACRAMENTO, CA. 95833 (916) 925-4000
MARCUS H. BOLE & ASSOCIATES	104 BLOCK DR. WHEATLAND, CA. 95692 (530) 633-0117
PAR ENVIRONMENTAL	1906 21ST STREET, SACRAMENTO, CA. 95816 (916) 739-8356
ESPAÑA GEOTECHNICAL CONSULTING	502 GIUSEPPE CT., ROSEVILLE, CA. 95678 (916) 773-2600
PERRY DESIGN	2091 HIDDEN GOLD TRAIL, COOL, CA. 95614 (530) 823-2621



Drawing Title	P.I.C./ADMINISTRATION BUILDING EXTERIOR ELEVATIONS
Approved: Director, Office of Construction Management	
Approved: Director, Project Management Service	

Project Title	NEW NATIONAL CEMETERY PHASE IB DEVELOPMENT	Date:	MARCH 2010
Building Number	1401	Project No.	921CM2001B
Location	SACRAMENTO VALLEY VA NATIONAL CEMETERY SOLANO COUNTY, CALIFORNIA	Drawn	PAL
		DRAWING NO.	1401-3
			Dwg. 143 Of 222