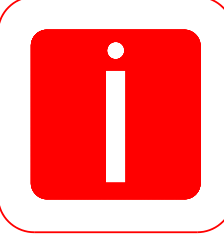
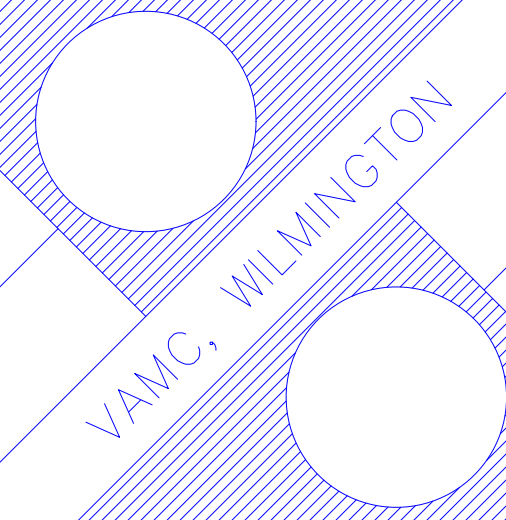


Revisions		Date		Professional Seal		 <div>Indus Systems, Inc. 2352, Main Street, Concord MA 01742 Tel: 978-461-0555 www.indus-systems.com</div>		Drawing Title GROUND FLOOR PLAN ARCHITECTURAL		Project Title AS-BUILT Drawings		Date 03-30-2016		 <div>VAMC, WILMINGTON</div>		VA Department of Veterans Affairs	
Approved:		Building Number 01		Checked		Drawn		Project No.									
Approved:		Location VAMC WILMINGTON DELAWARE						Drawing No. 460-1-G-AR									