


PROJECT FILE NO.	8-1280	AS-BUILT
SHEET TITLE	FIRST FLOOR PLAN	
SCALE	1/8" = 1'-0"	
DATE		
NO.		
DESCRIPTION		
REVISIONS		

10 120 Bed Nursing Home Care Unit
 STIMSON
 The Smith, Korach, Hayel, Hayne
 Architects, Engineers, Planners
 175 Fontainebleau Boulevard
 Miami, Florida
 APPROVED PROJECT DIRECTOR
 JAN 16 1978
 DRAWING NUMBER
 10-2
 PROJECT NUMBER
 546-007

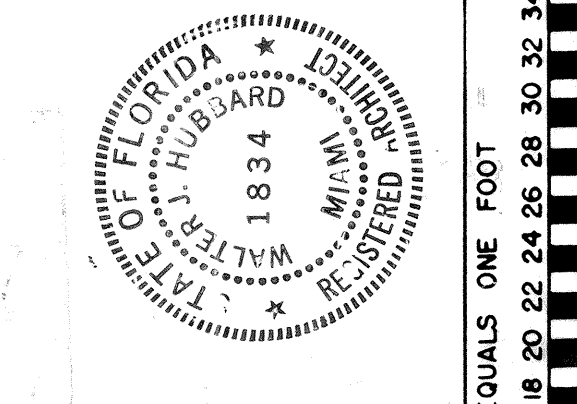

ONE EIGHTH INCH EQUALS ONE FOOT
 ONE QUARTER INCH EQUALS ONE FOOT
 ONE HALF INCH EQUALS ONE FOOT
 ONE INCH EQUALS ONE FOOT
 THREE INCHES EQUALS ONE FOOT

NOTE:
 CEILING HEIGHTS
 BED ROOMS 9'-0"
 BED ROOM ENTRY AREA 8'
 WHEEL CHAIR TOILETS, 7'-6" (TYPICAL)
 WHEEL CHAIR BATHS, 8'-0" (TYPICAL)
 * - HEIGHT OF SUSPENDED CEILING SHOWN
 ○ - NO SUSPENDED CEILING