
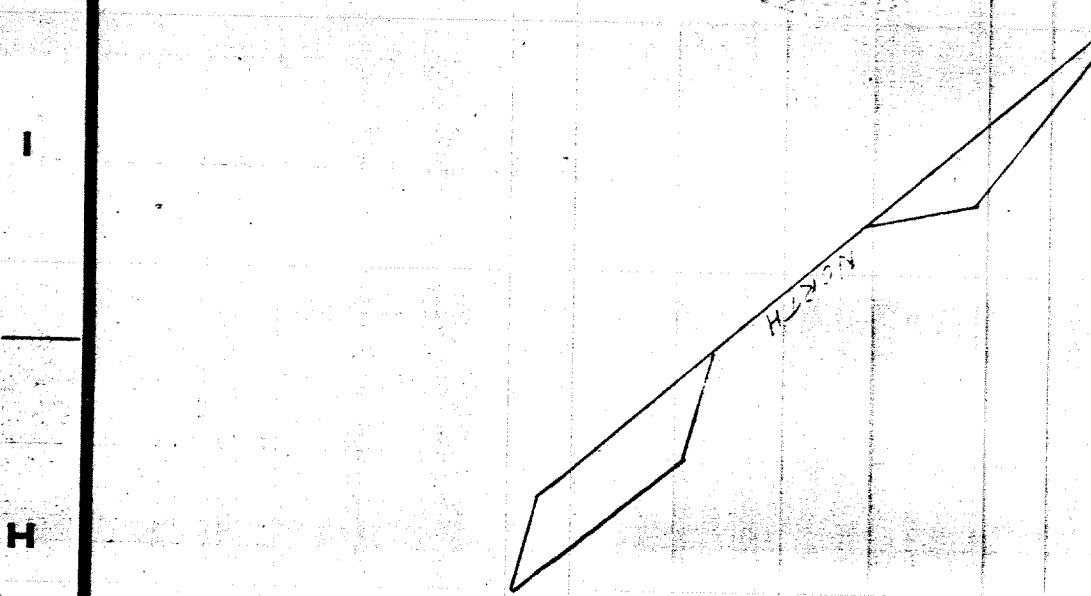


TEST BORING PLAN
BUILDING NO. 100
REPLACEMENT HOSPITAL
PHASE I
V.A.H. BRONX, N.Y.
VETERANS ADMINISTRATION
ARCHITECTURE AND PLANNING
MAX OUBRAHN ASSOCIATES
521 FIFTH AVE. - NEW YORK, N.Y. 10017
DRAWING NUMBER 100-BIA
SHEET 1 OF 1
APPROVED PROJECT DIRECTOR
DATE 2-22-75
CHECKED S.M.K.
DATE 2-22-75
DESIGNED S.M.K.
DATE 2-22-75
PROJECT NO. 526-079

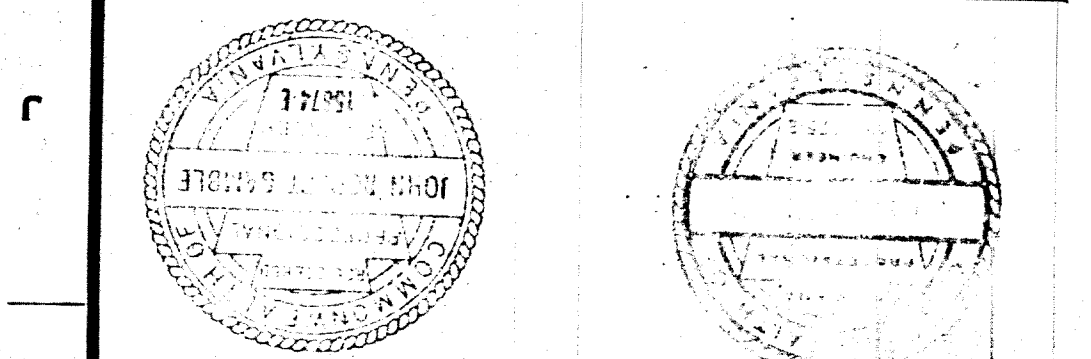

NOTE:
1. RETAINING WALL
IS NOT A TRUE TANGENT WALL.
ONLY POINTS DEFINED
ARE TRUE.
ALL MEASUREMENTS ARE
TO OUTSIDE OF WALL.

GENERAL NOTES:
• CONTOUR INTERVAL - 2 FT.
• TEST BORING LOCATION
• TEST BORING NUMBER
• BENCH MARK - IN BOMB HOLE
• CORNER OF EXISTING BUILDING 164.45

AS BUILT DWG.

306'-6"

191'-6"

LOWEST ELEVATION 185.02

MATCH LINE