

PARTITION INDICATIONS	
2 HOUR FIRE RATED PARTITIONS	2 HOUR FIRE RATED SMOKE PARTITIONS
1 HOUR FIRE RATED PARTITIONS	1 HOUR FIRE RATED SMOKE PARTITIONS
LEAD LINED PARTITIONS	BRICK
CONCRETE MASONRY UNIT (CMU)	CONCRETE
EXISTING WALLS TO REMAIN	NON FIRE RATED PARTITION

ROOM NUMBER BOX		CEILING HEIGHTS
FLOOR & AREA	ROOM NUMBER	A=7'-6" F=
FINISH & COLOR	CEILING HEIGHT	B=8'-0" G=
CORRIDOR, FLOOR	CORRIDOR NUMBER	C=9'-0" H=
FINISH & COLOR	CEILING HEIGHT	D=9'-6" E=EXPOSED STRUCT.


CASEWORK INDICATIONS	
CONTRACTOR FURNISHED AND INSTALLED (CC)	VA FURNISHED, CONTRACTOR INSTALLED (VC)
VA FURNISHED AND INSTALLED (VV)	

DIMENSIONS, IN GENERAL, ARE TO FACE OF FINISHED PARTITION AND TO GRID LINE AT EXTERIOR WALL.

NOTE: ROOM NUMBER BOXES WHICH APPEAR WITH ONLY FINISH & COLOR BOX FILLED IN REFER TO ACCENT COLOR USED IN THAT SPACE.

ALL CORRIDOR CEILING WITH EXCEPTION OF GROUND FLOOR IS TO BE 7'-6". THIS DOES NOT INCLUDE ELEV. LOBBIES.

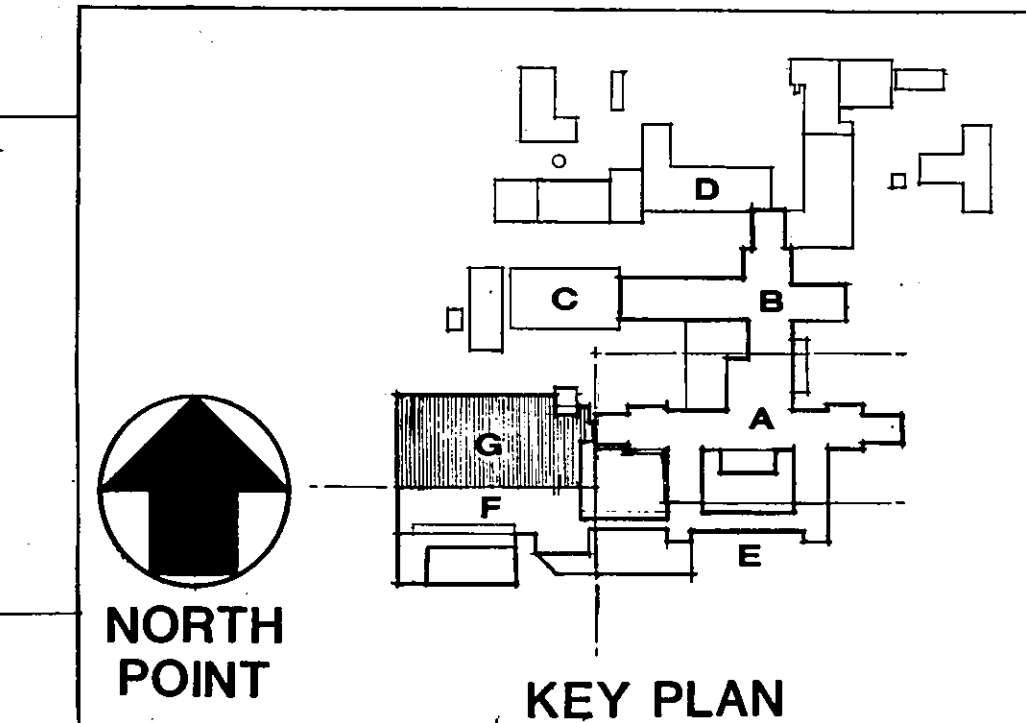

## SECOND FLOOR PLAN - BLOCK G

SCALE 1/8" = 1'-0"

RADIATION SHIELDING SCHEDULE									
RM. NO.	ROOM NAME	FLOOR	CLG.	WALLS				VIEW SCREEN	VIEW WINDOW
				NORTH	EAST	SOUTH	WEST		DOORS
2F-112	RAPIDO.	1.5MM	---	2.15MM	2.15MM	2.15MM	2.15MM	2.15MM	2.15MM
2F-113	CHEST	1.5MM	---	2.15MM	2.15MM	2.15MM	2.15MM	2.15MM	2.15MM
2F-114	RADIOLOGY/FLUOROSCOPY	1.5MM	---	2.15MM	2.15MM	2.15MM	2.15MM	2.15MM	2.15MM
2F-115	C.A.T. SCANNING	1.5MM	---	2.15MM	2.15MM	2.15MM	2.15MM	2.15MM	2.15MM
2F-116	RADIOLOGY/FLUOROSCOPY	1.5MM	---	2.15MM	2.15MM	2.15MM	2.15MM	2.15MM	2.15MM
2F-117	CONTROL (CAT SCANNING)	---	---	2.15MM	2.15MM	---	---	---	4.5MM

RADIATION SHIELDING SCHEDULE (CONT'D)									
RM. NO.	ROOM NAME	FLOOR	CLG.	WALLS				VIEW SCREEN	VIEW WINDOW
				NORTH	EAST	SOUTH	WEST		DOORS
2G-228	ENDOSCOPY	1.5MM	---	2.15MM	2.15MM	2.15MM	2.15MM	2.15MM	2.15MM
2G-134	I.V.P. ROOMS	1.5MM	---	2.15MM	2.15MM	2.15MM	2.15MM	2.15MM	2.15MM
2G-135	I.V.P. ROOMS	1.5MM	---	2.15MM	2.15MM	2.15MM	2.15MM	2.15MM	2.15MM
2G-136	G.P. ROOMS	1.5MM	---	2.15MM	2.15MM	2.15MM	2.15MM	2.15MM	2.15MM
2G-137	SPECIAL PROCEDURE	1.5MM	---	2.15MM	2.15MM	2.15MM	2.15MM	2.15MM	2.15MM
2G-138	POLY TOME	1.5MM	---	---	---	---	---	---	---

7/10/84 AS BUILT	
NO.	DATE
REVISIONS:	
SHEET TITLE	
SECOND FLOOR PLAN - BLOCK G	
BLOC. NO.	PROJECT TITLE
1	CLINICAL ADDITION, MODERNIZATION & CORRECTION OF SEISMIC DEFICIENCIES
DRWN	CHECKED
TMS	JLD
DATE	
OCT 14 1980	
DRAWING NUMBER	
1-31R	
DWS. 31 OF 191	
PROJECT NUMBER	
635-018	
VETERANS ADMINISTRATION	
LOCATION	
VAMC, OKLAHOMA CITY, OKLAHOMA	

