
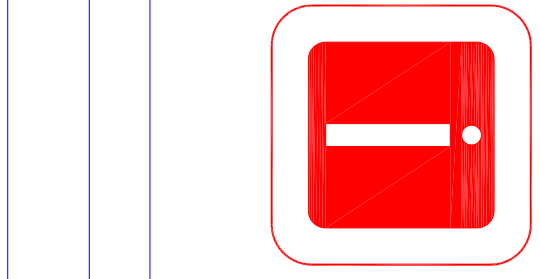


Site: Memphis, Building: 1, Floor: 1

Hatch Pattern	Service	Area Sq. Ft.
	ACS - Primary Care	16,607.48
	ACS - Specialty Care	3,725.76
	ACS - Urgent Care	10,144.34
	Canteen	329.24
	Dental	6,283.80
	Director's Suite	371.77
	EMS	419.15
	Engineering	587.51
	Eye Clinic	9,673.79
	Fiscal	262.62
	Inpatient Intermediate Care/Inpatient Mental Health Care (Shared)	8,428.88
	Inpatient Mental Health Care	7,258.87
	IRM	316.78
	Lobby	552.13
	MAS	4,621.49
	Mental Health Clinic	9,737.60
	Missing	431.53
	Nursing Service Administration	88.91
	Pathology and Lab	19,704.12
	Psychiatry Administration	1,561.80
	Radiology	22,768.97
	Rehab Medicine	13,001.61
	Social Work	144.26
	Swing	4,691.58
	Common Space	23,300.5

NOTE:


FF: - FLOOR FINISH

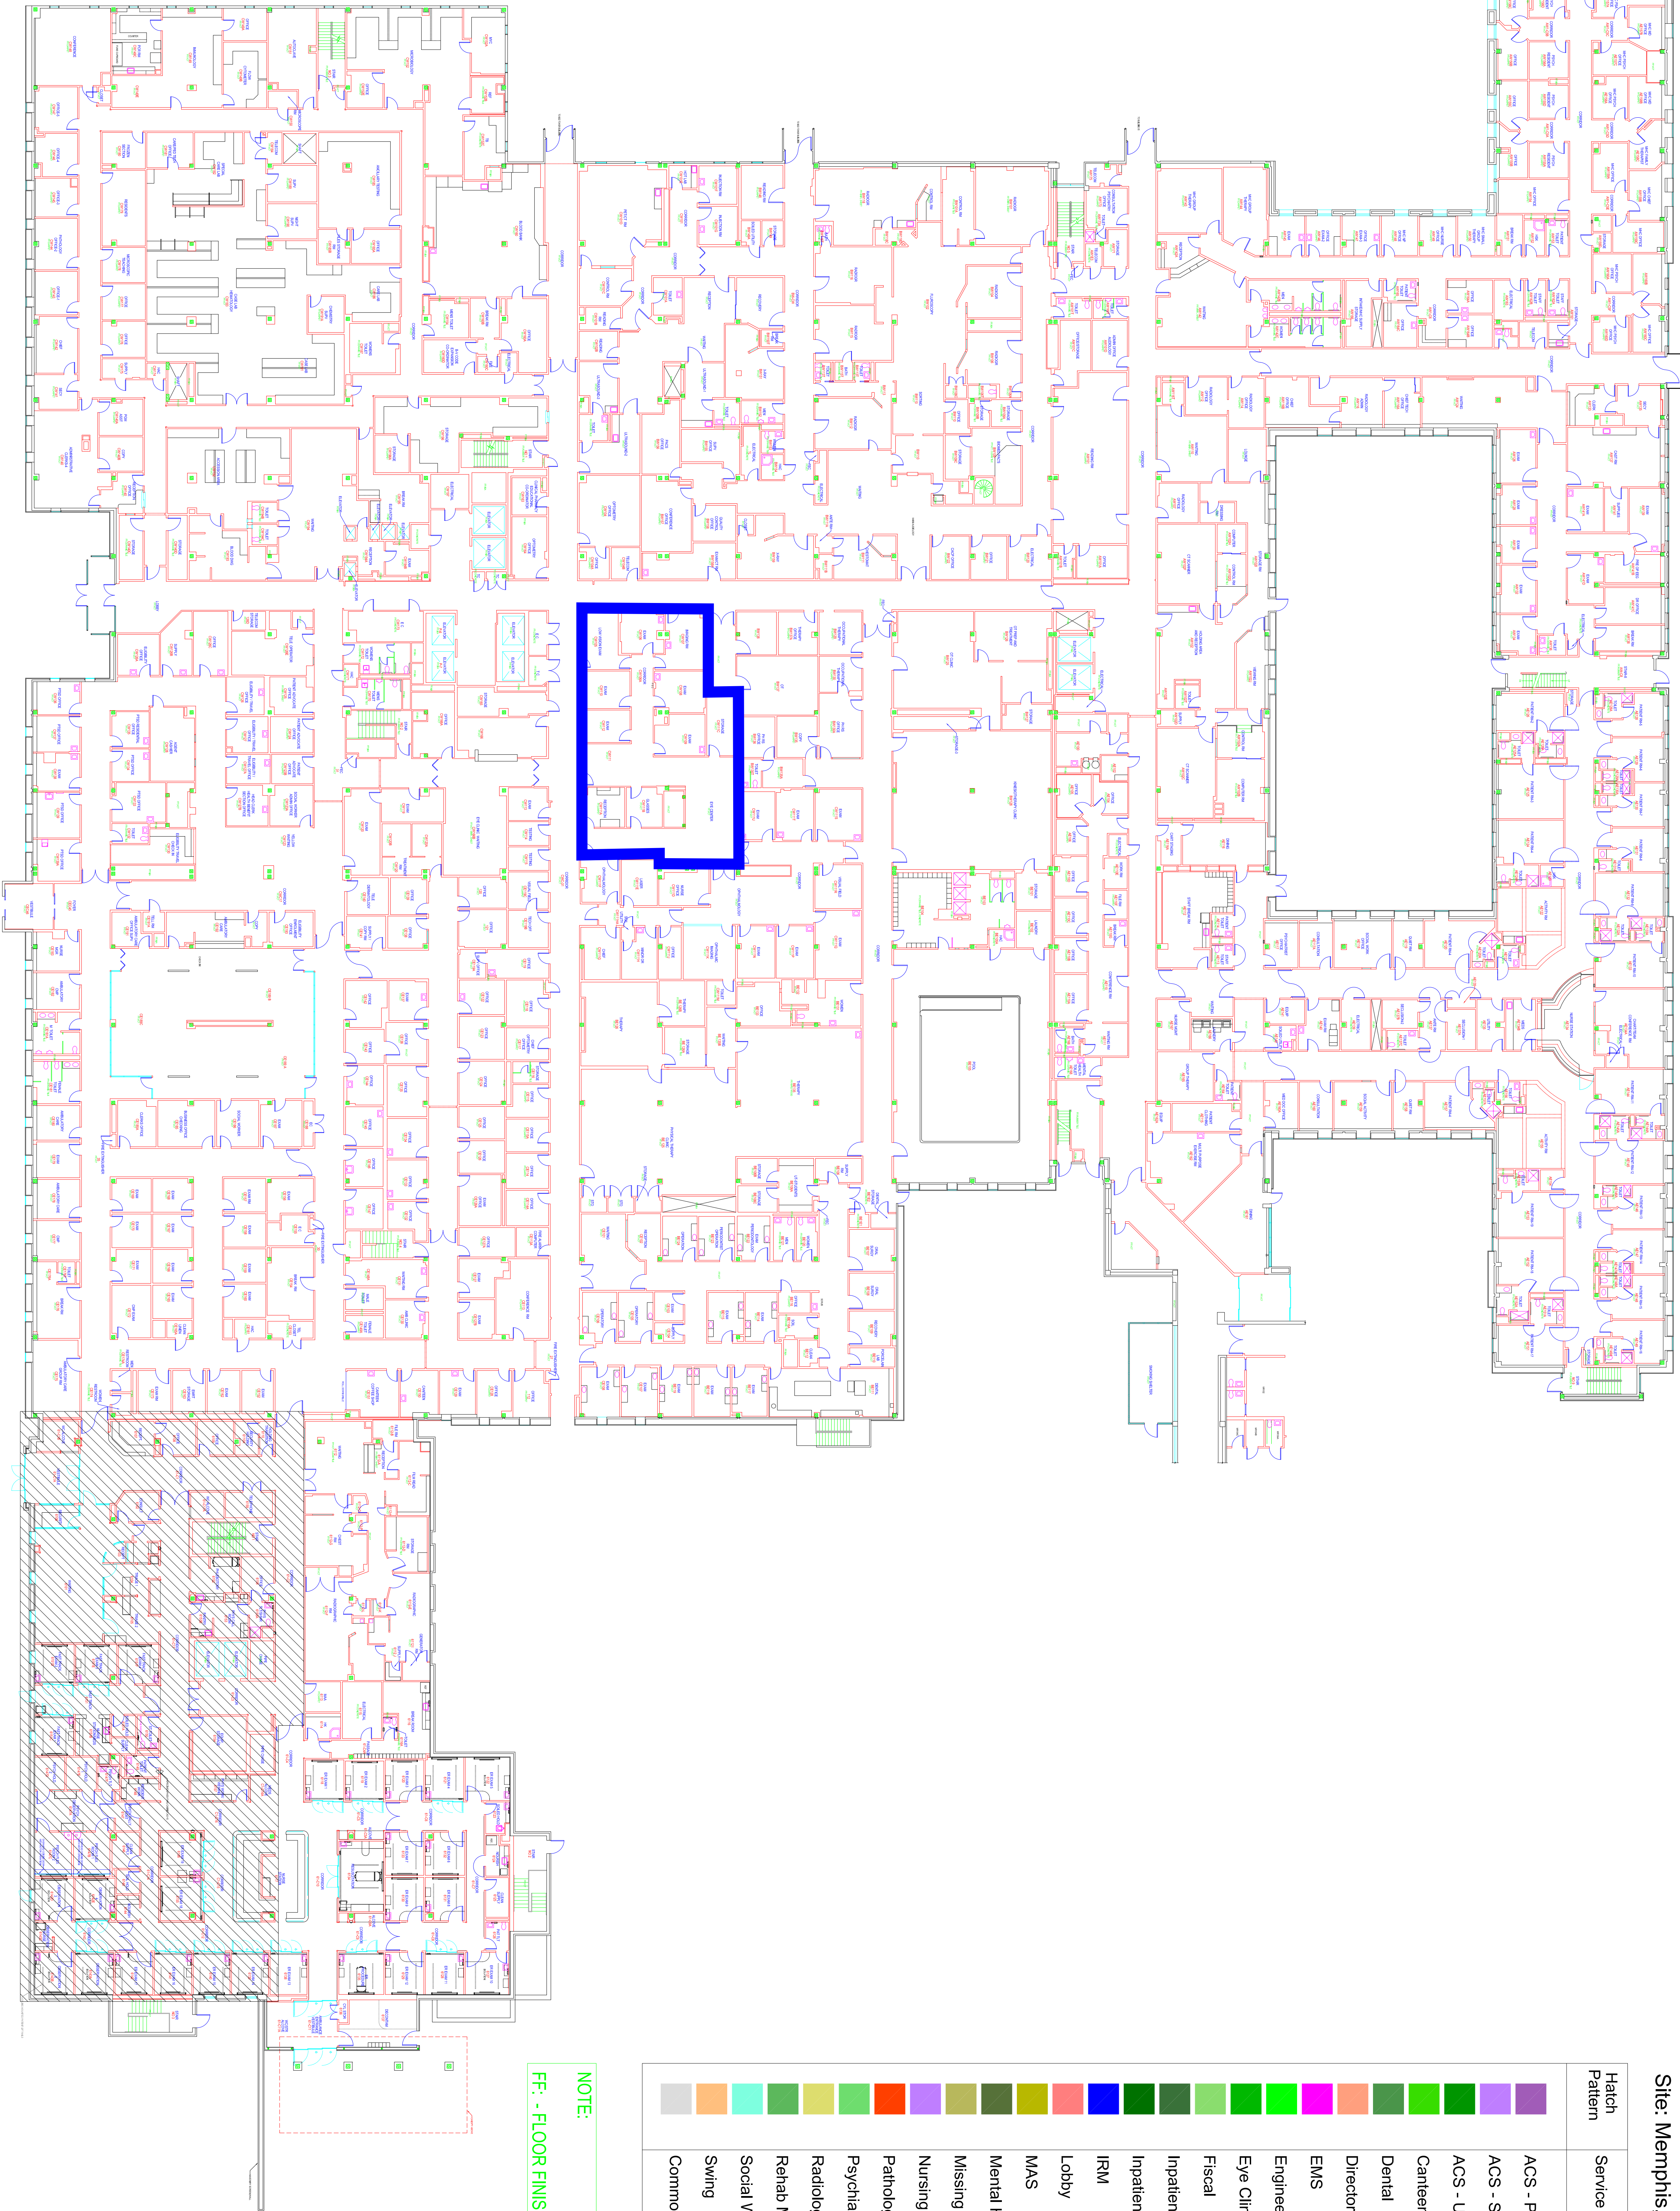

Indus Systems, Inc.  
2352, Main Street, Concord MA 01742  
Tel: 978-461-0555  
www.indus-systems.com

Drawing Title		Project Title	
FIRST FLOOR PLAN ARCHITECTURAL		AS-BUILT Drawings	
Site: MEMPHIS	Building: 01	Drawn:	Checked:
Location: VA MEMPHIS		Approved:	Approved:

Date 12-09-2015
Project No.
Drawing No.

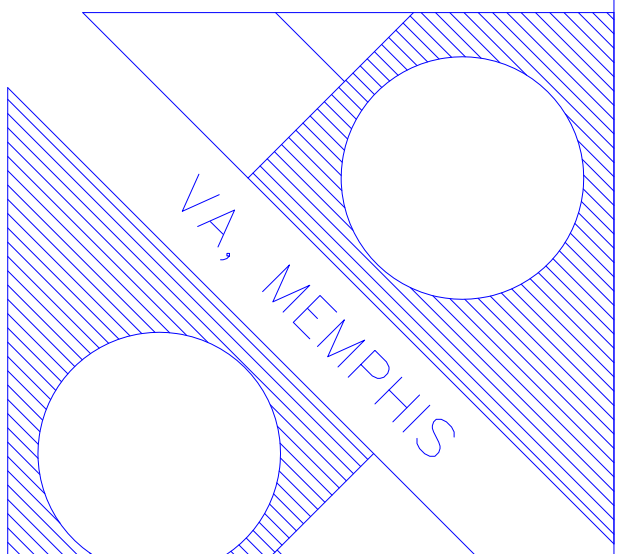

VA Department of Veterans Affairs

Revisions

Date

Professional Seal

VA FORM 08-6231, OCT 1978