


# ASBUILT

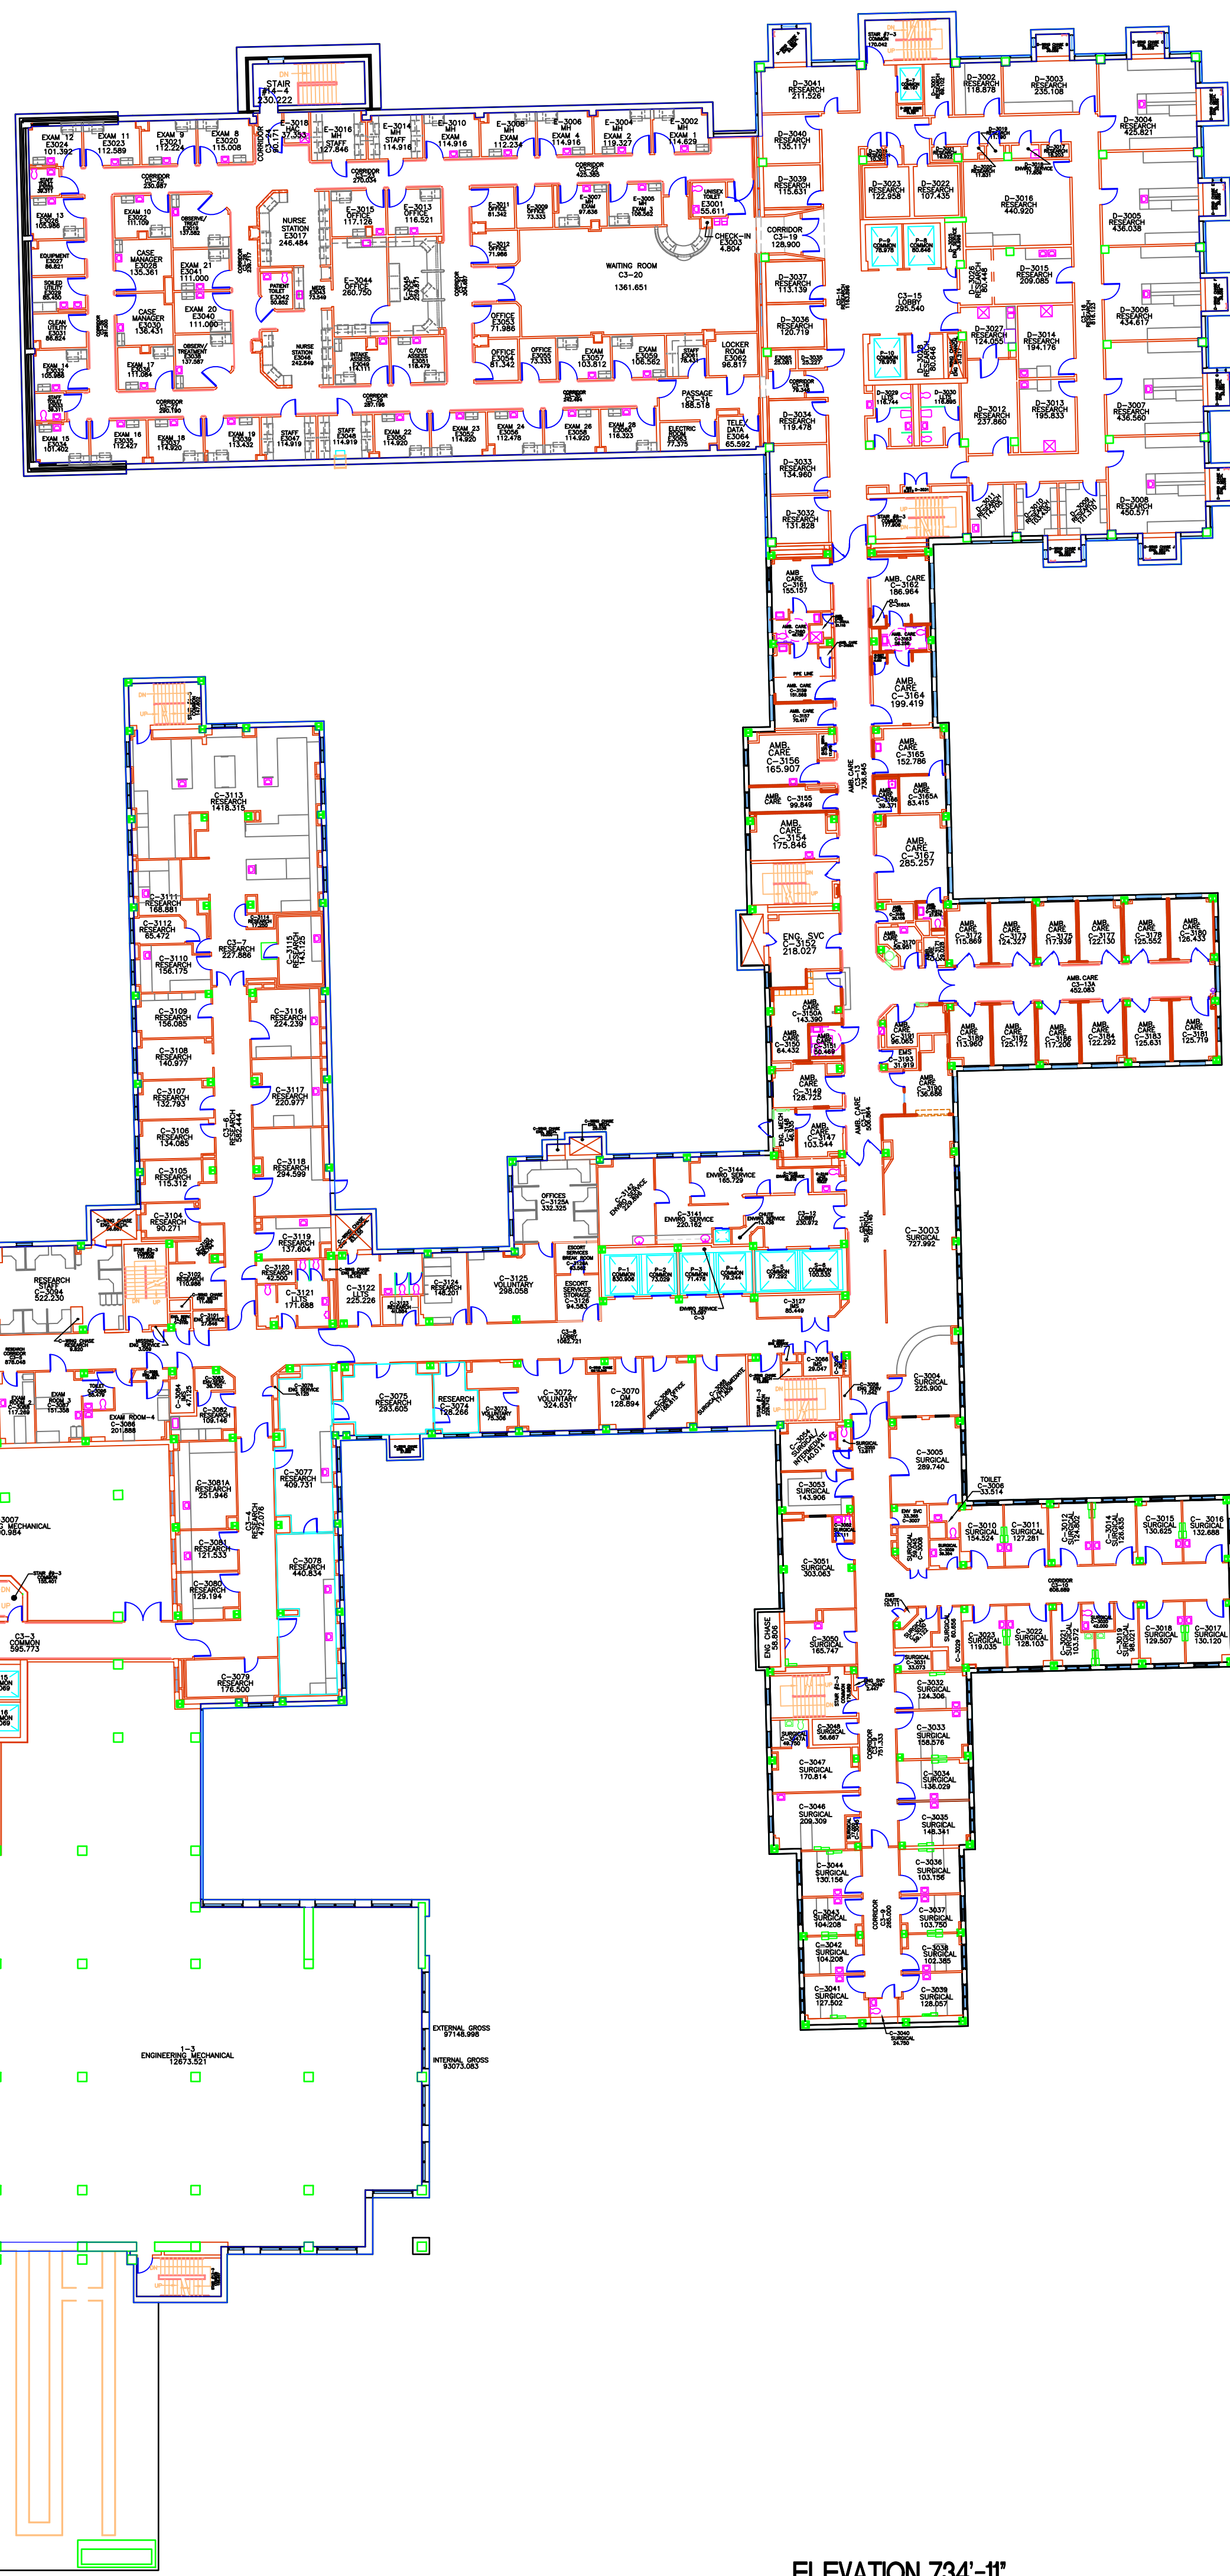

**3** THIRD FLOOR PLAN WITH SQ. FT.  
SCALE: 1" = 25'


ELEVATION 734'-11"

DRAWING ORIGINATED ON 3-20-2002  
UPDATED JUNE 2016  
EXTERNAL GROSS: 97148.998 SQ. FT.

Revisions:	Date
1 REVISED FLOOR PLAN TO ACCOMMODATE RENOV. NEW WALLS & DOORS.	2/11/2010
2 REVISED SQ. FT FOR NEW SPACE RENOVATIONS	5/11/2010
3 REVISED FLOOR PLAN TO ACCOMMODATE RENOV. NEW WALLS & DOORS.	8/30/2011
4 REVISED FLOOR PLAN TO ACCOMMODATE 4 TH FLOOR RENOV.	1/2/2014
5 REVISED FLOOR PLAN TO ACCOMMODATE ALL RENOV. FORMAT AND LAYOUT	11/09/2015

<b>PLOT DATE:</b>	
<b>PLOT DATE:</b>	
<b>CAD DRAWING FILE LOCATION:</b>	S:\Architectural\Engineering CADD Control Center(A)\Asbuilts\Bldg_1_Current Asbuilts

<b>ADDRESS:</b>	Richard L. Roudebush VA Medical Center 1481 W. 10th St. Indianapolis, Indiana 46202
-----------------	---

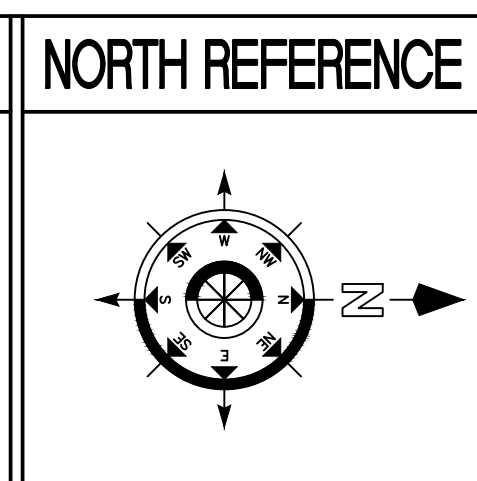

<b>PROJECT ENGINEERS:</b>	CHIEF OF ENGINEERING: SCOTT L. MORITZ ASSISTANT CHIEF OF ENG: ANDREW J. HAWK
<b>DRAWN BY:</b>	A. FERNANDEZ

<b>Drawing Title:</b>	FLOOR PLAN WITH SQ. FT.
<b>Approved: Project Director:</b>	

<b>Project Title:</b>	THIRD FLOOR
<b>Location:</b>	WEST TENTH STREET
<b>Date:</b>	2 JAN 2014
<b>Checked:</b>	
<b>Drawn:</b>	AF

<b>Project Number:</b>	-
<b>Building Number:</b>	BUILDING #1
<b>Drawing Number:</b>	A-105
<b>Dwg. 5 of 13</b>	

