

- NOTES:
- 1 NEW ITEMS SHOWN BOLD (TYPICAL)
 - 2 EXISTING ITEMS SHOWN LIGHT (TYPICAL)
 - 3 COORDINATE WITH GENERAL CONTRACTOR FOR CUTTING AND PATCHING OF EXISTING ROOF FOR INSTALLATION OF NEW EXHAUST FAN.
 - 4 COORDINATE INSTALLATION WITH ELECTRICAL CONTRACTOR.



J&J MAINTENANCE, INC.
3755 Capital of Texas Hwy. S., Suite 355
Austin, Texas 78704-7916
512-444-7271 FAX: 512-444-7454




Rev.	Date	By	App.
01	AS-BUILT DRAWINGS 12/15/11		
More	Description	Date	App.

Designed by:	Clad by:	Date:	Rev.
Reviewed by:	Submitted by:	File name:	Plot date:
Chief, Arch. Branch		Plot scale:	

AS-BUILT DRAWINGS
SURGERY SUITE
JACK C. MONTGOMERY VA MEDICAL CENTER
BUILDING #1, C-WING, 3RD FLR.,
MUSKOGEE, OKLAHOMA
DACAB7-03-D-0010 TASK ORDER 001

Sheet
reference
number:
M-3
Sheet 34 of 92

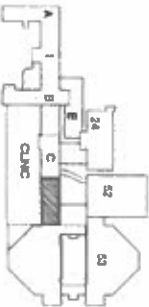


KEY PLAN
SCALE: NO SCALE


NOTES:
COORDINATE ALL REPAIRS OR MODIFICATIONS TO
EXISTING ROOFING MATERIALS AS REQUIRED FOR
ALL NEW PENETRATIONS AND ROOF CURBS WITH
OWNER'S APPROVED ROOFING CONTRACTOR. ALL
REPAIRS SHALL BE COMPLETED WITHIN 90 DAYS
OF THE EXISTING ROOF WARRANTY.

1 PARTIAL PENTHOUSE HVAC PLAN



ATTACHMENT C-4

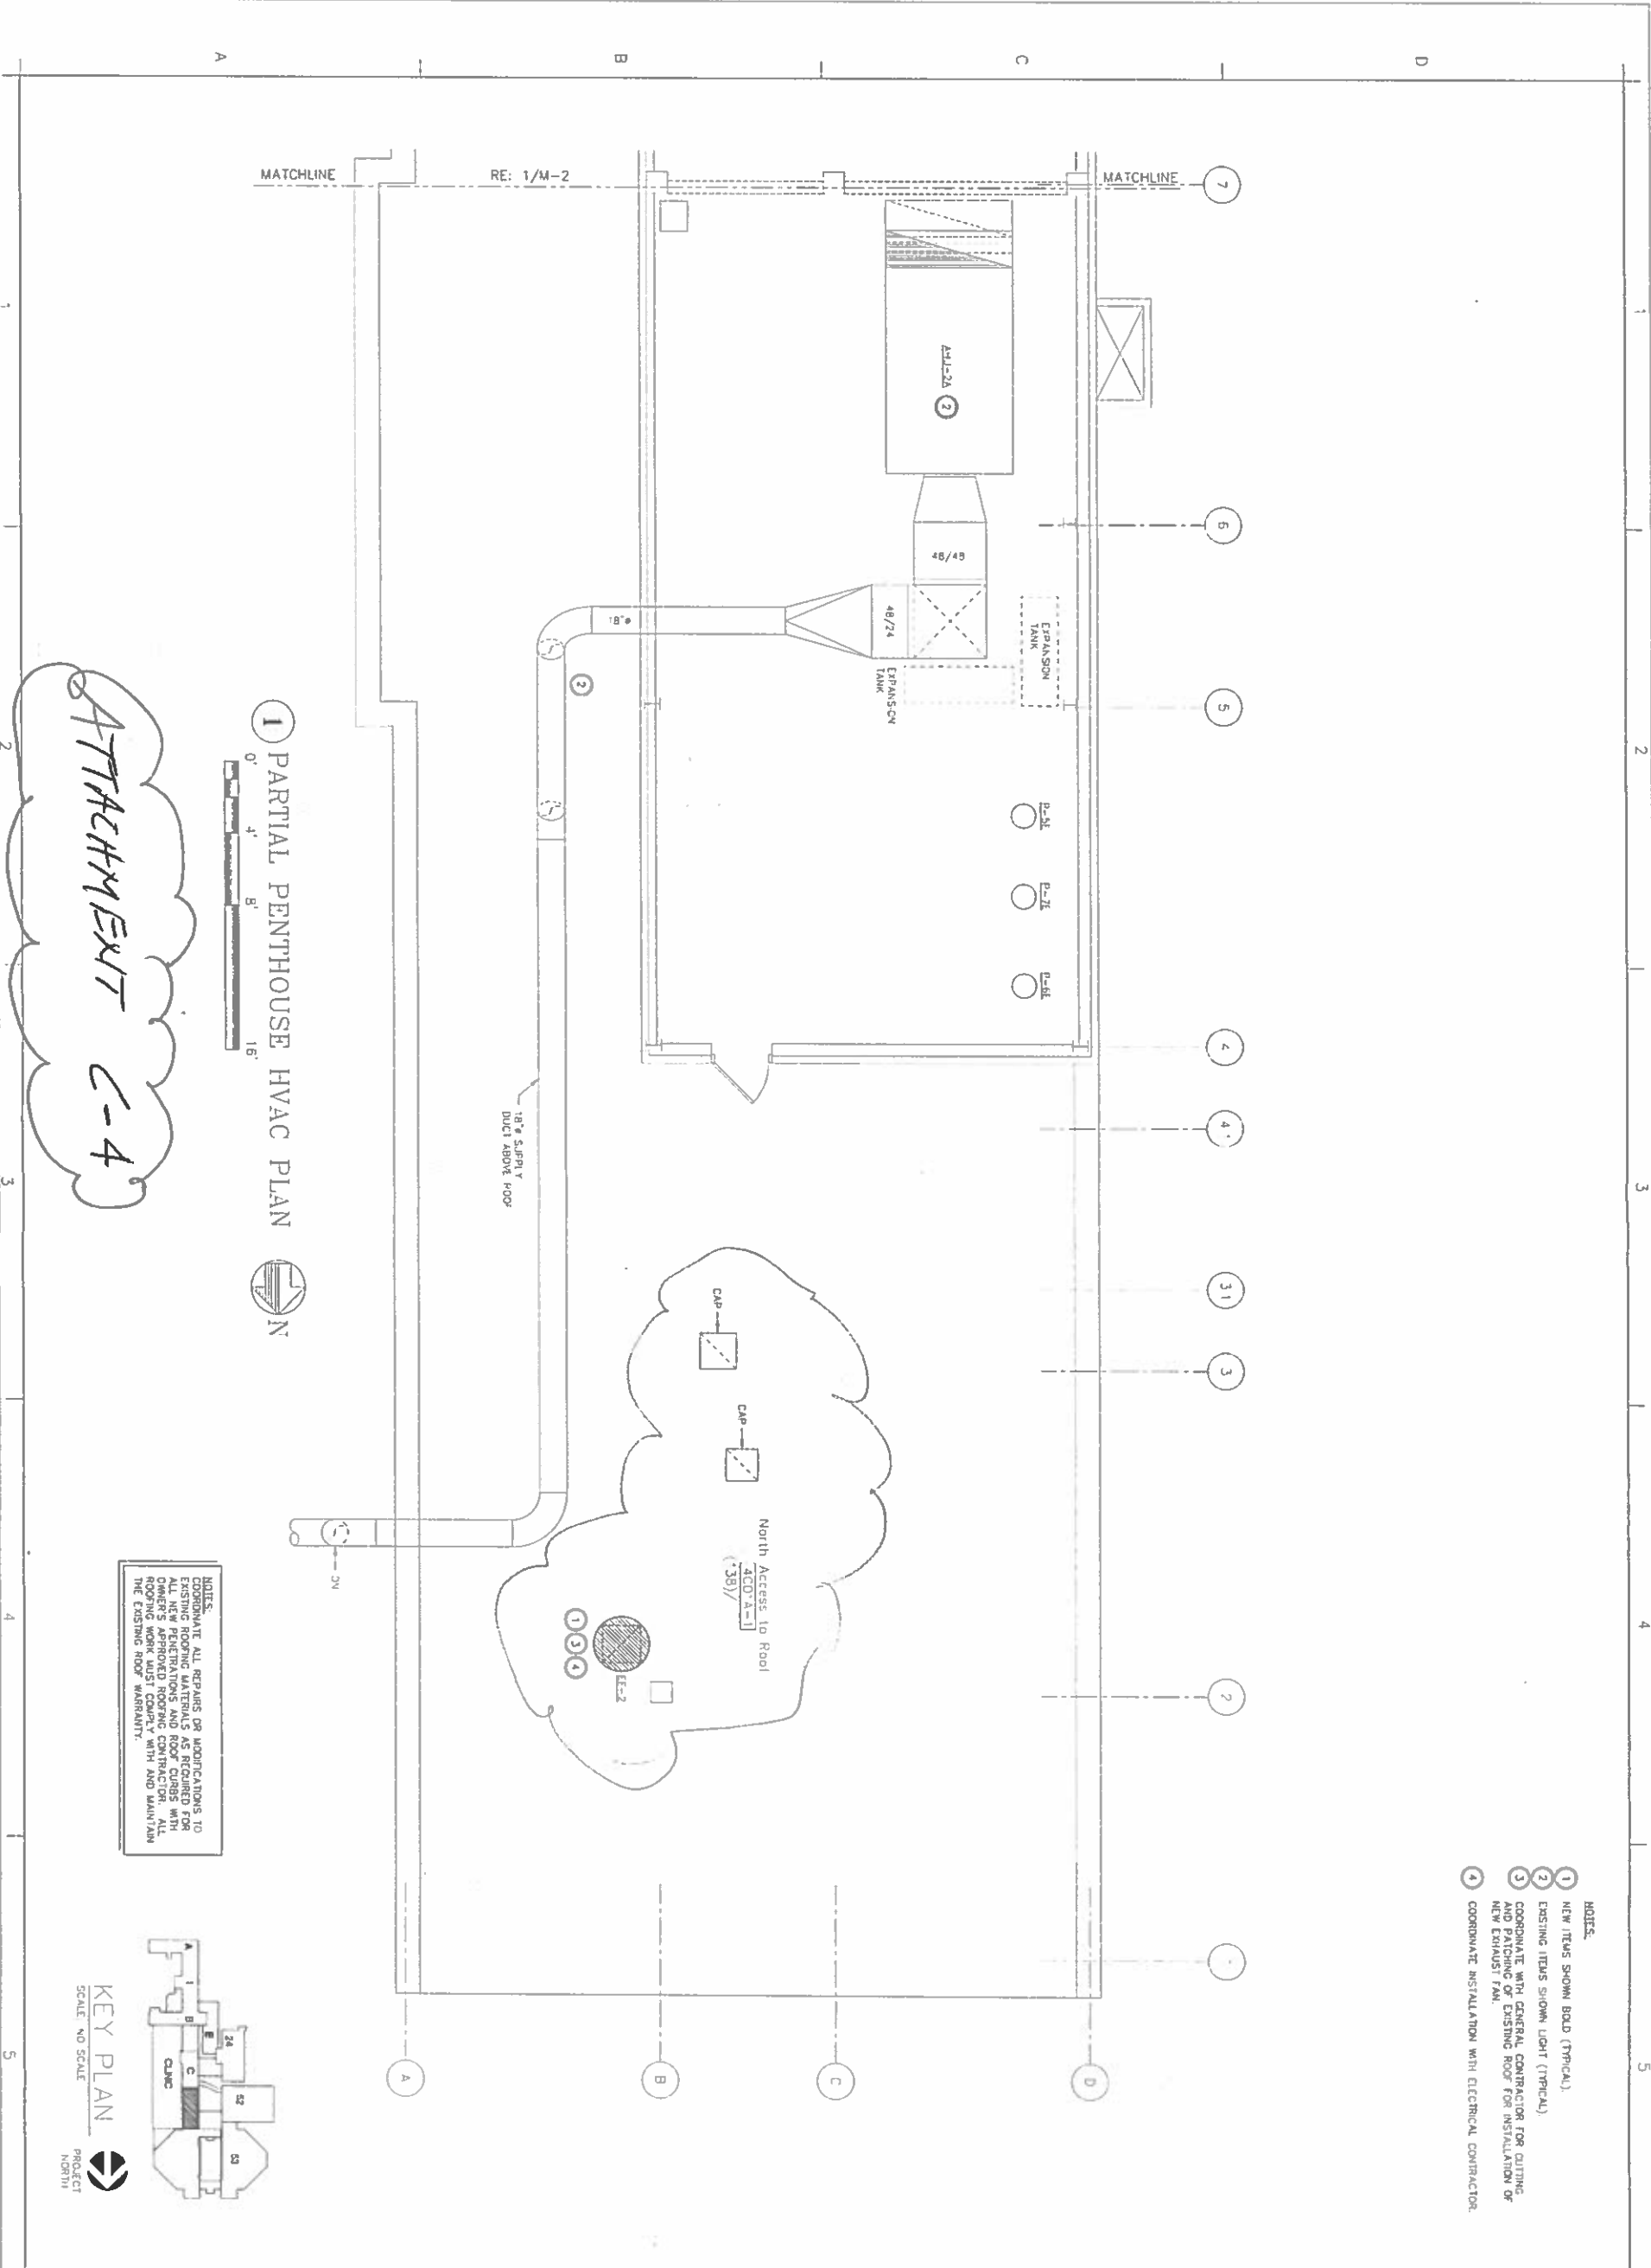

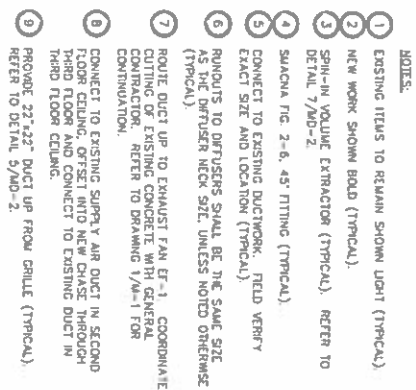

ATTACHMENT C-5



01	15-GR/1 DIAGRAMS	12/5/11
Drawn	Designed	Revised



3755 Capital of Texas Hwy. S., Suite 355
Austin, Texas 78704-7916
512-444-7271 FAX: 512-444-7454

US Army Corps
of Engineers
Huntsville District

Sheet
reference
number
M-7
Sheet 38 of 92



Sheet
reference
number

M-8

AS BUILT DRAWINGS
SURGERY SUITE
JACK C. MONTGOMERY VA MEDICAL CENTER
BUILDING #1, C-WING, 3RD FLR.,
MUSKOGEE, OKLAHOMA
DACA87 03-D-0010 TASK ORDER 001

Designed by:		Date:	Rev.
Drawn by:	Check by:	Design file no.	
Reviewed by:		Drawing code	
Submitted by:		File name	
Chief Arch. Branch		Plot date	
		Plot size	


01	IS-BURT drawings	12-15-11
----	------------------	----------



3755 Capital of Texas Hwy. S., Suite 355
Austin, Texas 78704-7916
512-444-7271 FAX:512-444-7454



US Army Corps
of Engineers
Huntsville District

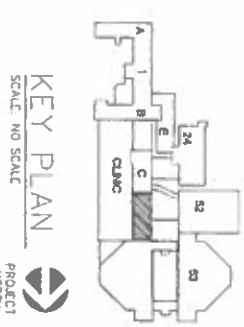

KEY PLAN
SCALE: NO SCALE

Sheet
reference
number

M-9

Sheet 40 of 92

AS-BUILT DRAWINGS
SURGERY SUITE
JACK C. MONTGOMERY VA MEDICAL CENTER
BUILDING #1, C-WING, 3RD FLR.,
MUSKOGEE, OKLAHOMA
DACAB7-03-D-0010 TASK ORDER 001

Designed by:		Date:	Rev.
Drawn by:	Clad by:	Design file no.	
Revised by:		Drawing code:	
Submitted by:		File name Plot date Plot scale	
Chief Arch. Branch			

01	45-BALT BRANDED	12 15 81	
Signs	Description	Date	Appr



J&J MAINTENANCE, INC.
3755 Capital of Texas Hwy. S., Suite 355
Austin, Texas 78704-7916
512-444-7271 FAX: 512-444-7454

