


A  
three inches = one foot  
1  
0  
6  
B  
one and one half inches = one foot  
2  
0  
6  
C  
one inch = one foot  
2  
0  
6  
D  
three quarters inch = one foot  
4  
0  
6  
E  
one half inch = one foot  
4  
0  
6  
F  
three eighths inch = one foot  
8  
0  
6  
G  
one quarter inch = one foot  
16  
0  
6  
H  
one eighth inch = one foot  
32  
0  
6

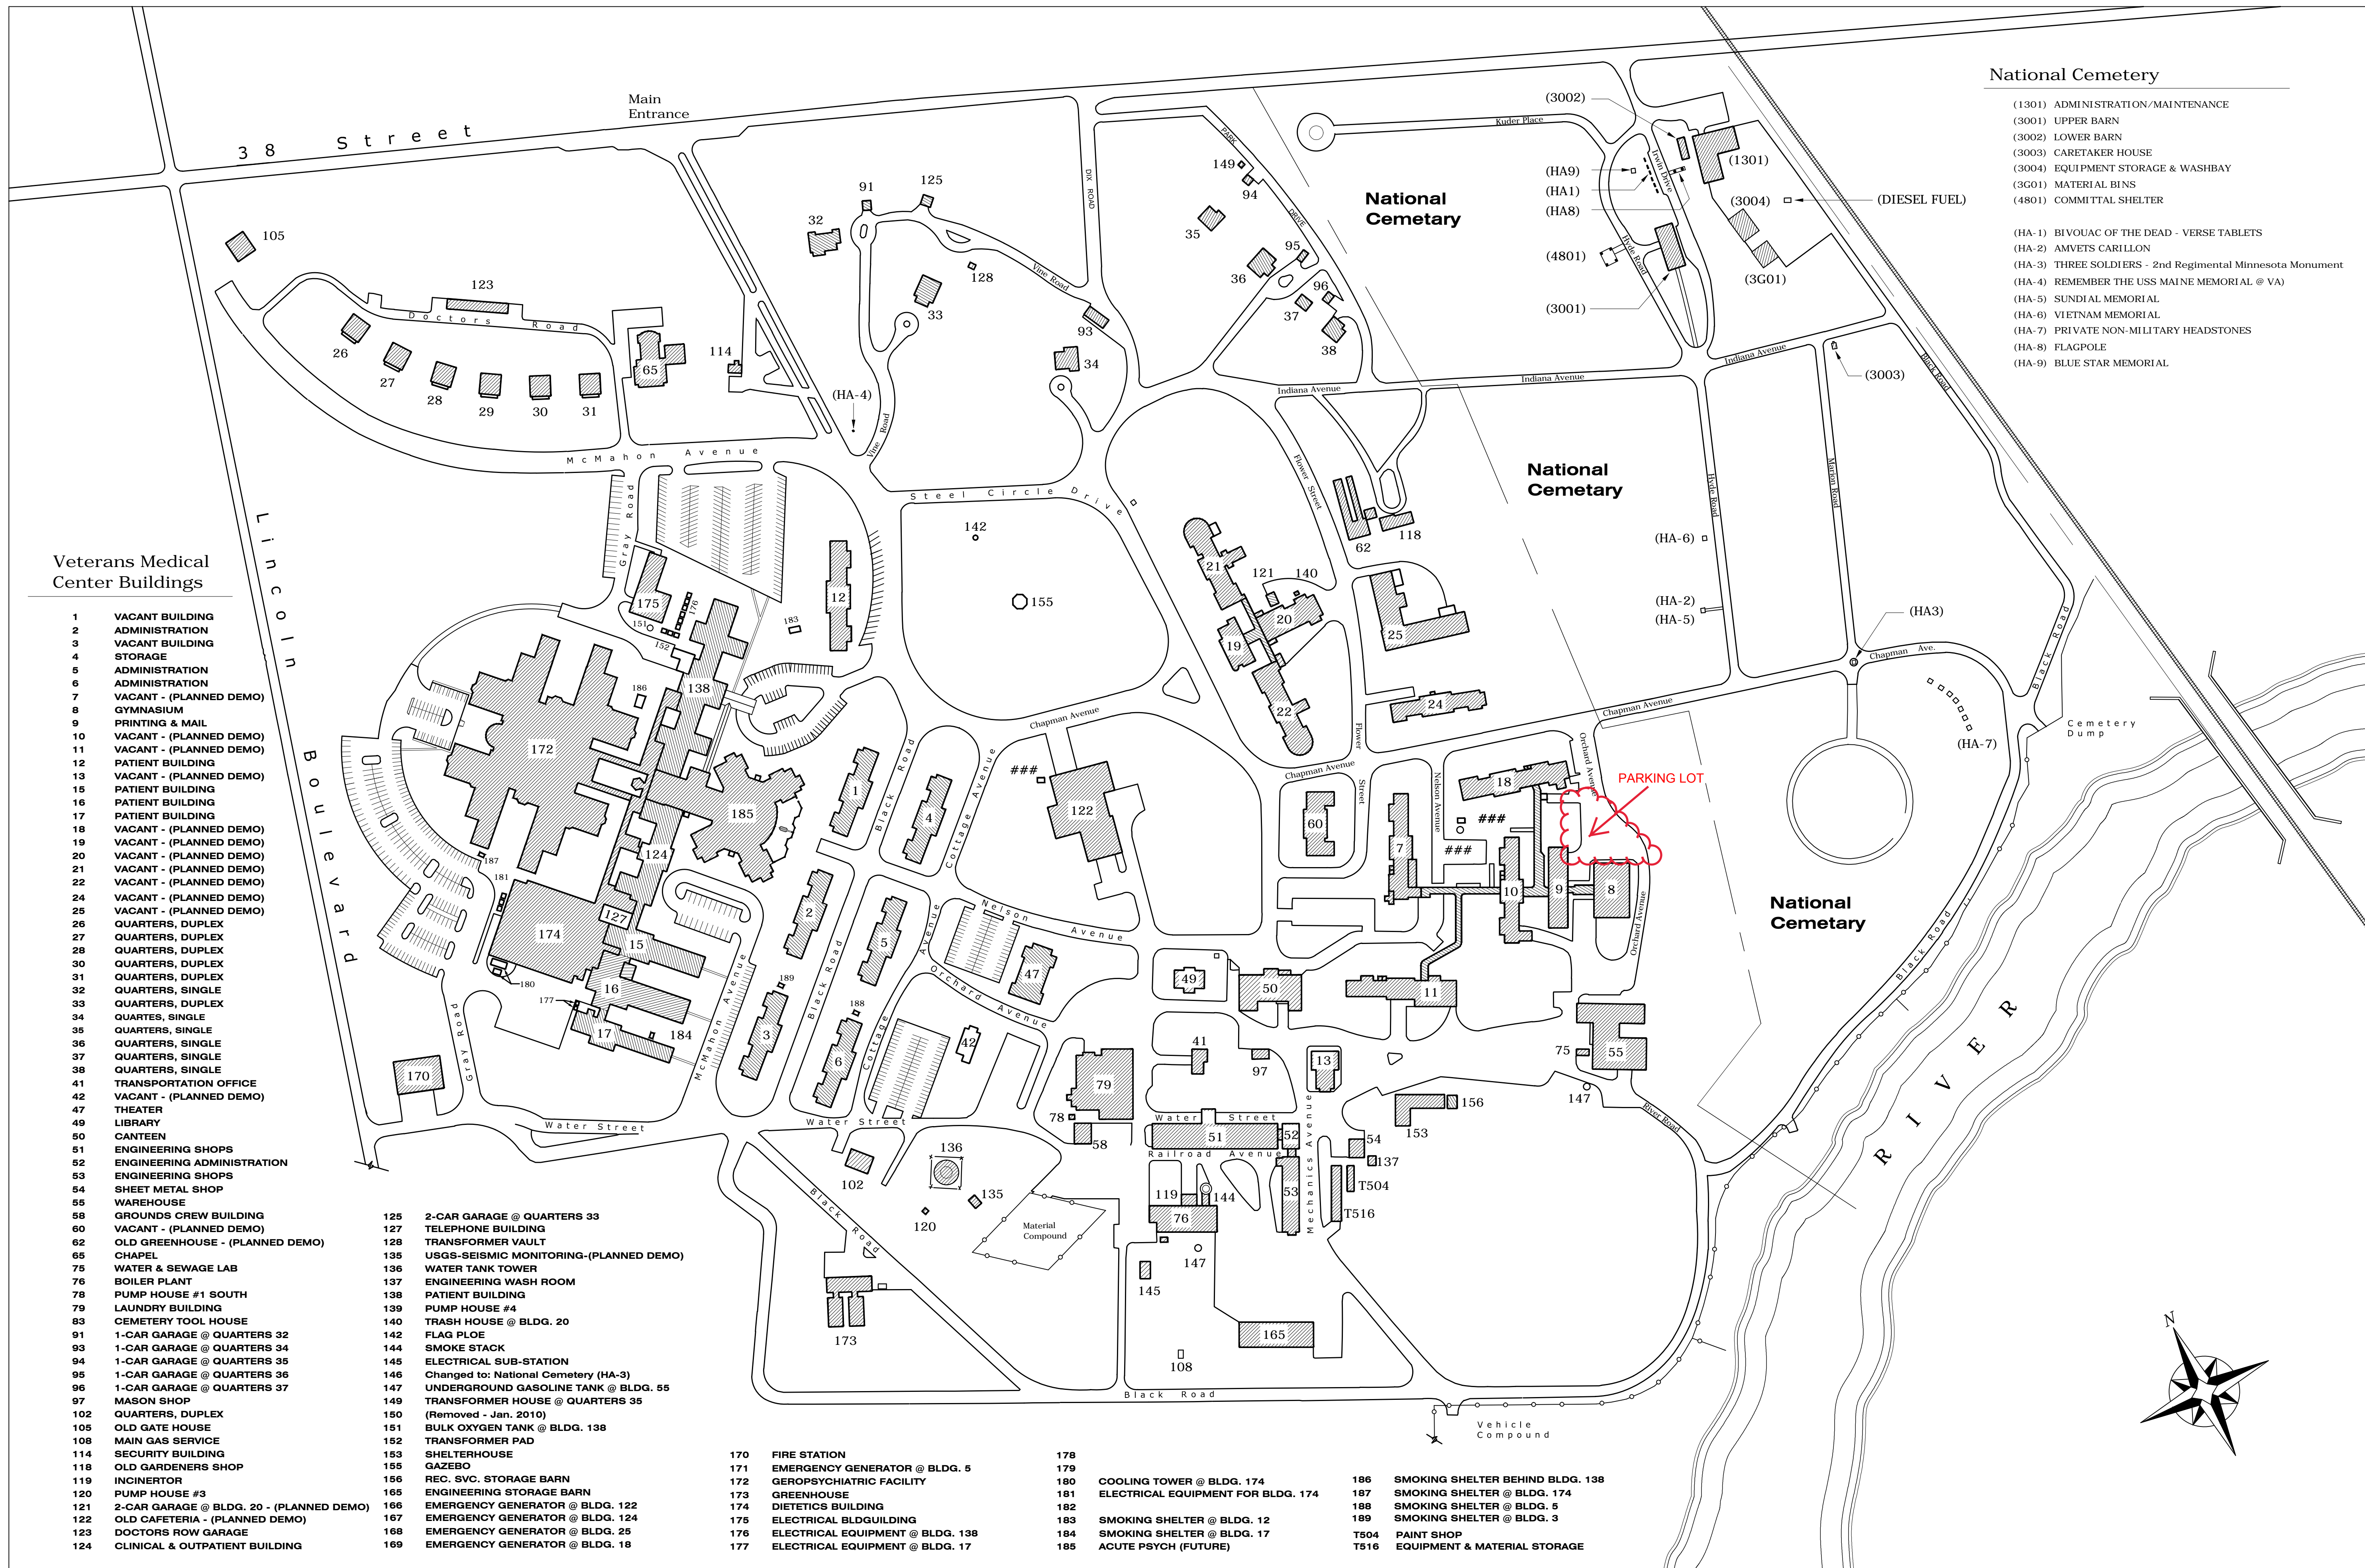

VA Northern Indiana Health Care  
System, Marion  
1700 E 38th Street  
Marion, IN 46953

Drawing Title  
**Plot Plan**  
VA NIHCS, Marion Campus  
Site Record Drawings

REVISED TO CURRENT CONDITIONS		ELKINS	01/20/2010
SYM	REVISIONS	BY	DATE
Project Number		Building Number	
Location		Drawing Number	
Date		Checked	
Date		Drawn	
Dwg. 1 of 11			

