

TOTAL AREA: 55,756 FT²


NO INDUSTRY - MEDIA - OR PUBLIC RELEASE.
Warning: This document is FOR OFFICIAL USE ONLY.




DESIGNED BY: M. SEDA		DRAWN BY: M. SEDA		CHECKED BY: M. SEDA		DATE: 11AUG17		CLIENT PROJECT #:		CONTRACT NUMBER:		DRAWING #:		DRAWING TITLE:		PROJECT TITLE:	
LOCATION: VA MEDICAL CENTER		BUILDING NUMBER: ONE		AUTOCAD NAME: BASEMENT.DWG		SHT: OF:		BASEMENT EAST		RECORD DWGS							
REVISIONS		DATE		Office of Facilities		Dept. of Veterans Affairs		Oscar G. Johnson Medical Center		325 East 14 th Street		Iron Mountain, MI 49801					





TOTAL AREA: 59,124 FT²

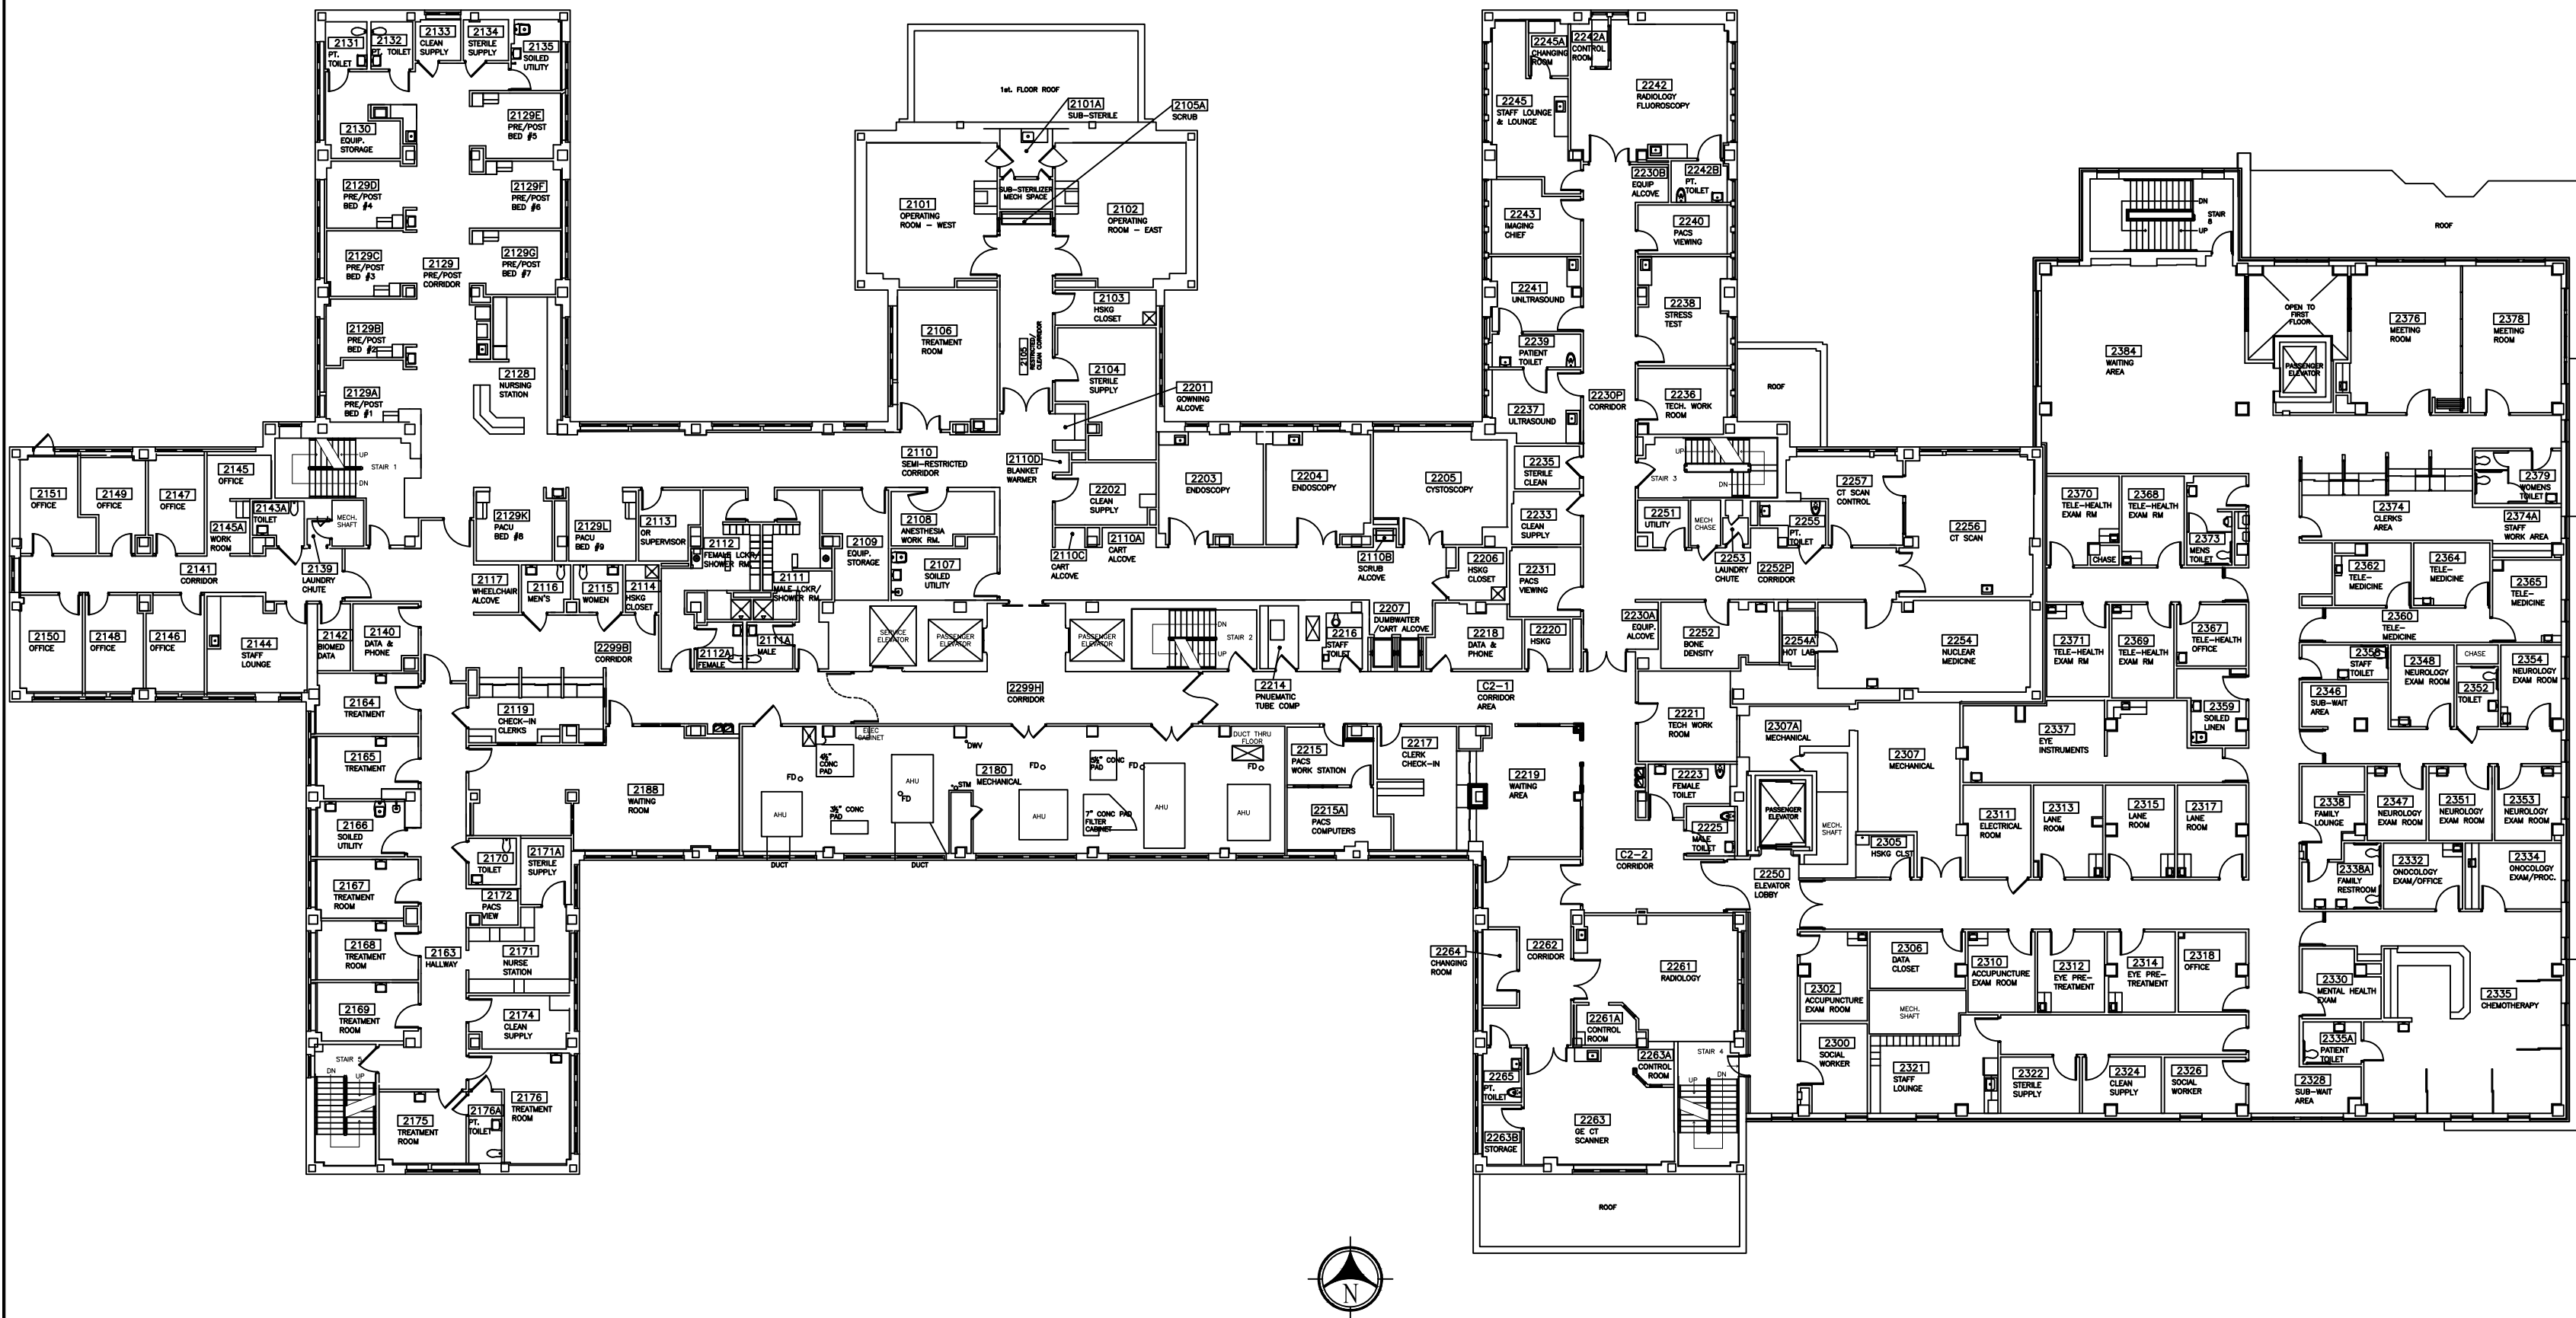
			Dept. of Veterans Affairs Oscar G. Johnson Medical Center 325 East "H" Street Iron Mountain, MI 49801	DESIGNED BY:	DRAWN BY:	CHECKED BY:	DATE:	CLIENT PROJECT #:	CONTRACT NUMBER:	DRAWING #:	DRAWING TITLE:	PROJECT TITLE:
				M. SEDA	M. SEDA	11AUG17						FIRST FLOOR EAST
REVISIONS		DATE		LOCATION:	VA MEDICAL CENTER IRON MOUNTAIN, MICHIGAN	SCALE:	NTS	BUILDING NUMBER:	AUTOCAD NAME:	SHT. OF:		
								ONE	1st FLOOR.DWG			



TOTAL AREA: 42,859FT²


NO INDUSTRY - MEDIA - OR PUBLIC RELEASE.
Warning: This document is FOR OFFICIAL USE ONLY.


				Dept. of Veterans Affairs Oscar G. Johnson Medical Center 325 East "H" Street Iron Mountain, MI 49801		DESIGNED BY:	DRAWN BY:	CHECKED BY:	DATE:	CLIENT PROJECT #:	CONTRACT NUMBER:	DRAWING #:	DRAWING TITLE:	PROJECT TITLE:
				LOCATION:	VA MEDICAL CENTER IRON MOUNTAIN, MICHIGAN		SCALE:	NTS		BUILDING NUMBER:	AUTOCAD NAME:		SHT:	OF:
REVISIONS		DATE												

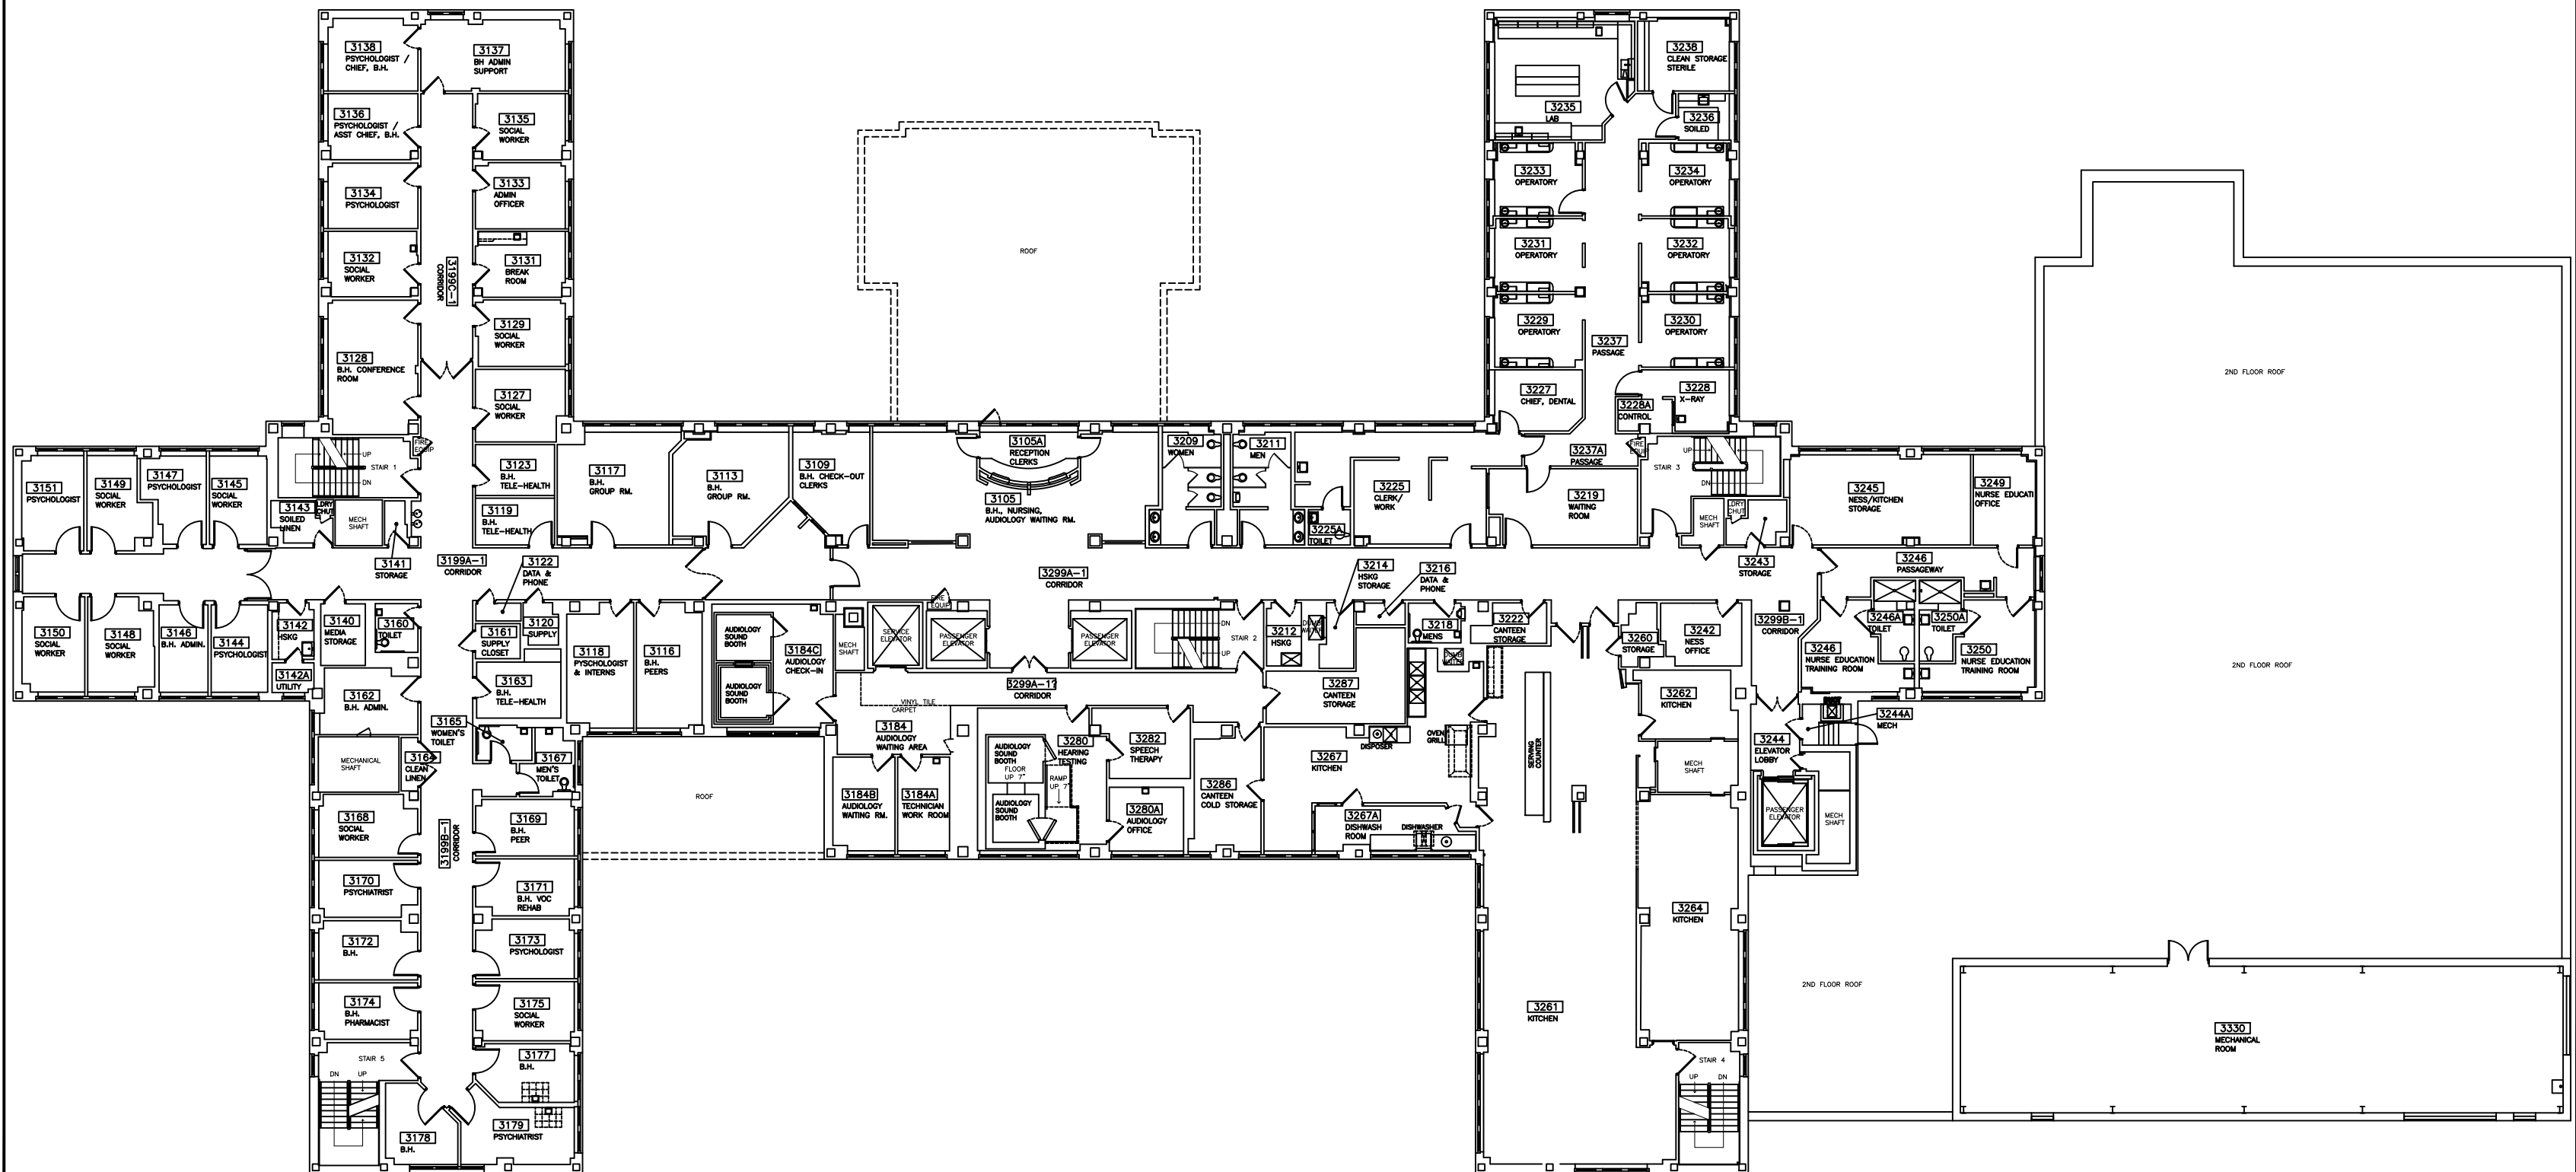

NO INDUSTRY - MEDIA - OR PUBLIC RELEASE.
Warning: This document is FOR OFFICIAL USE ONLY.


TOTAL AREA: 29,021FT²


<div>REVISIONS</div> <div>DATE</div>	<div>  Dept. of Veterans Affairs Oscar G. Johnson Medical Center 325 East 1st Street Iron Mountain, MI 49801 </div>	<div> DESIGNED BY: M. SEDA DRAWN BY: M. SEDA CHECKED BY: M. SEDA DATE: 11AUG17 LOCATION: VA MEDICAL CENTER IRON MOUNTAIN, MICHIGAN </div>	<div> CLIENT PROJECT #: ONE CONTRACT NUMBER: 3RD FLOOR.DWG DRAWING #: SHT. 0F: AUTOCAD NAME: </div>	<div> DRAWING TITLE: THIRD FLOOR </div>	<div> PROJECT TITLE: RECORD DWGS </div>
--------------------------------------	---	--	--	---	---

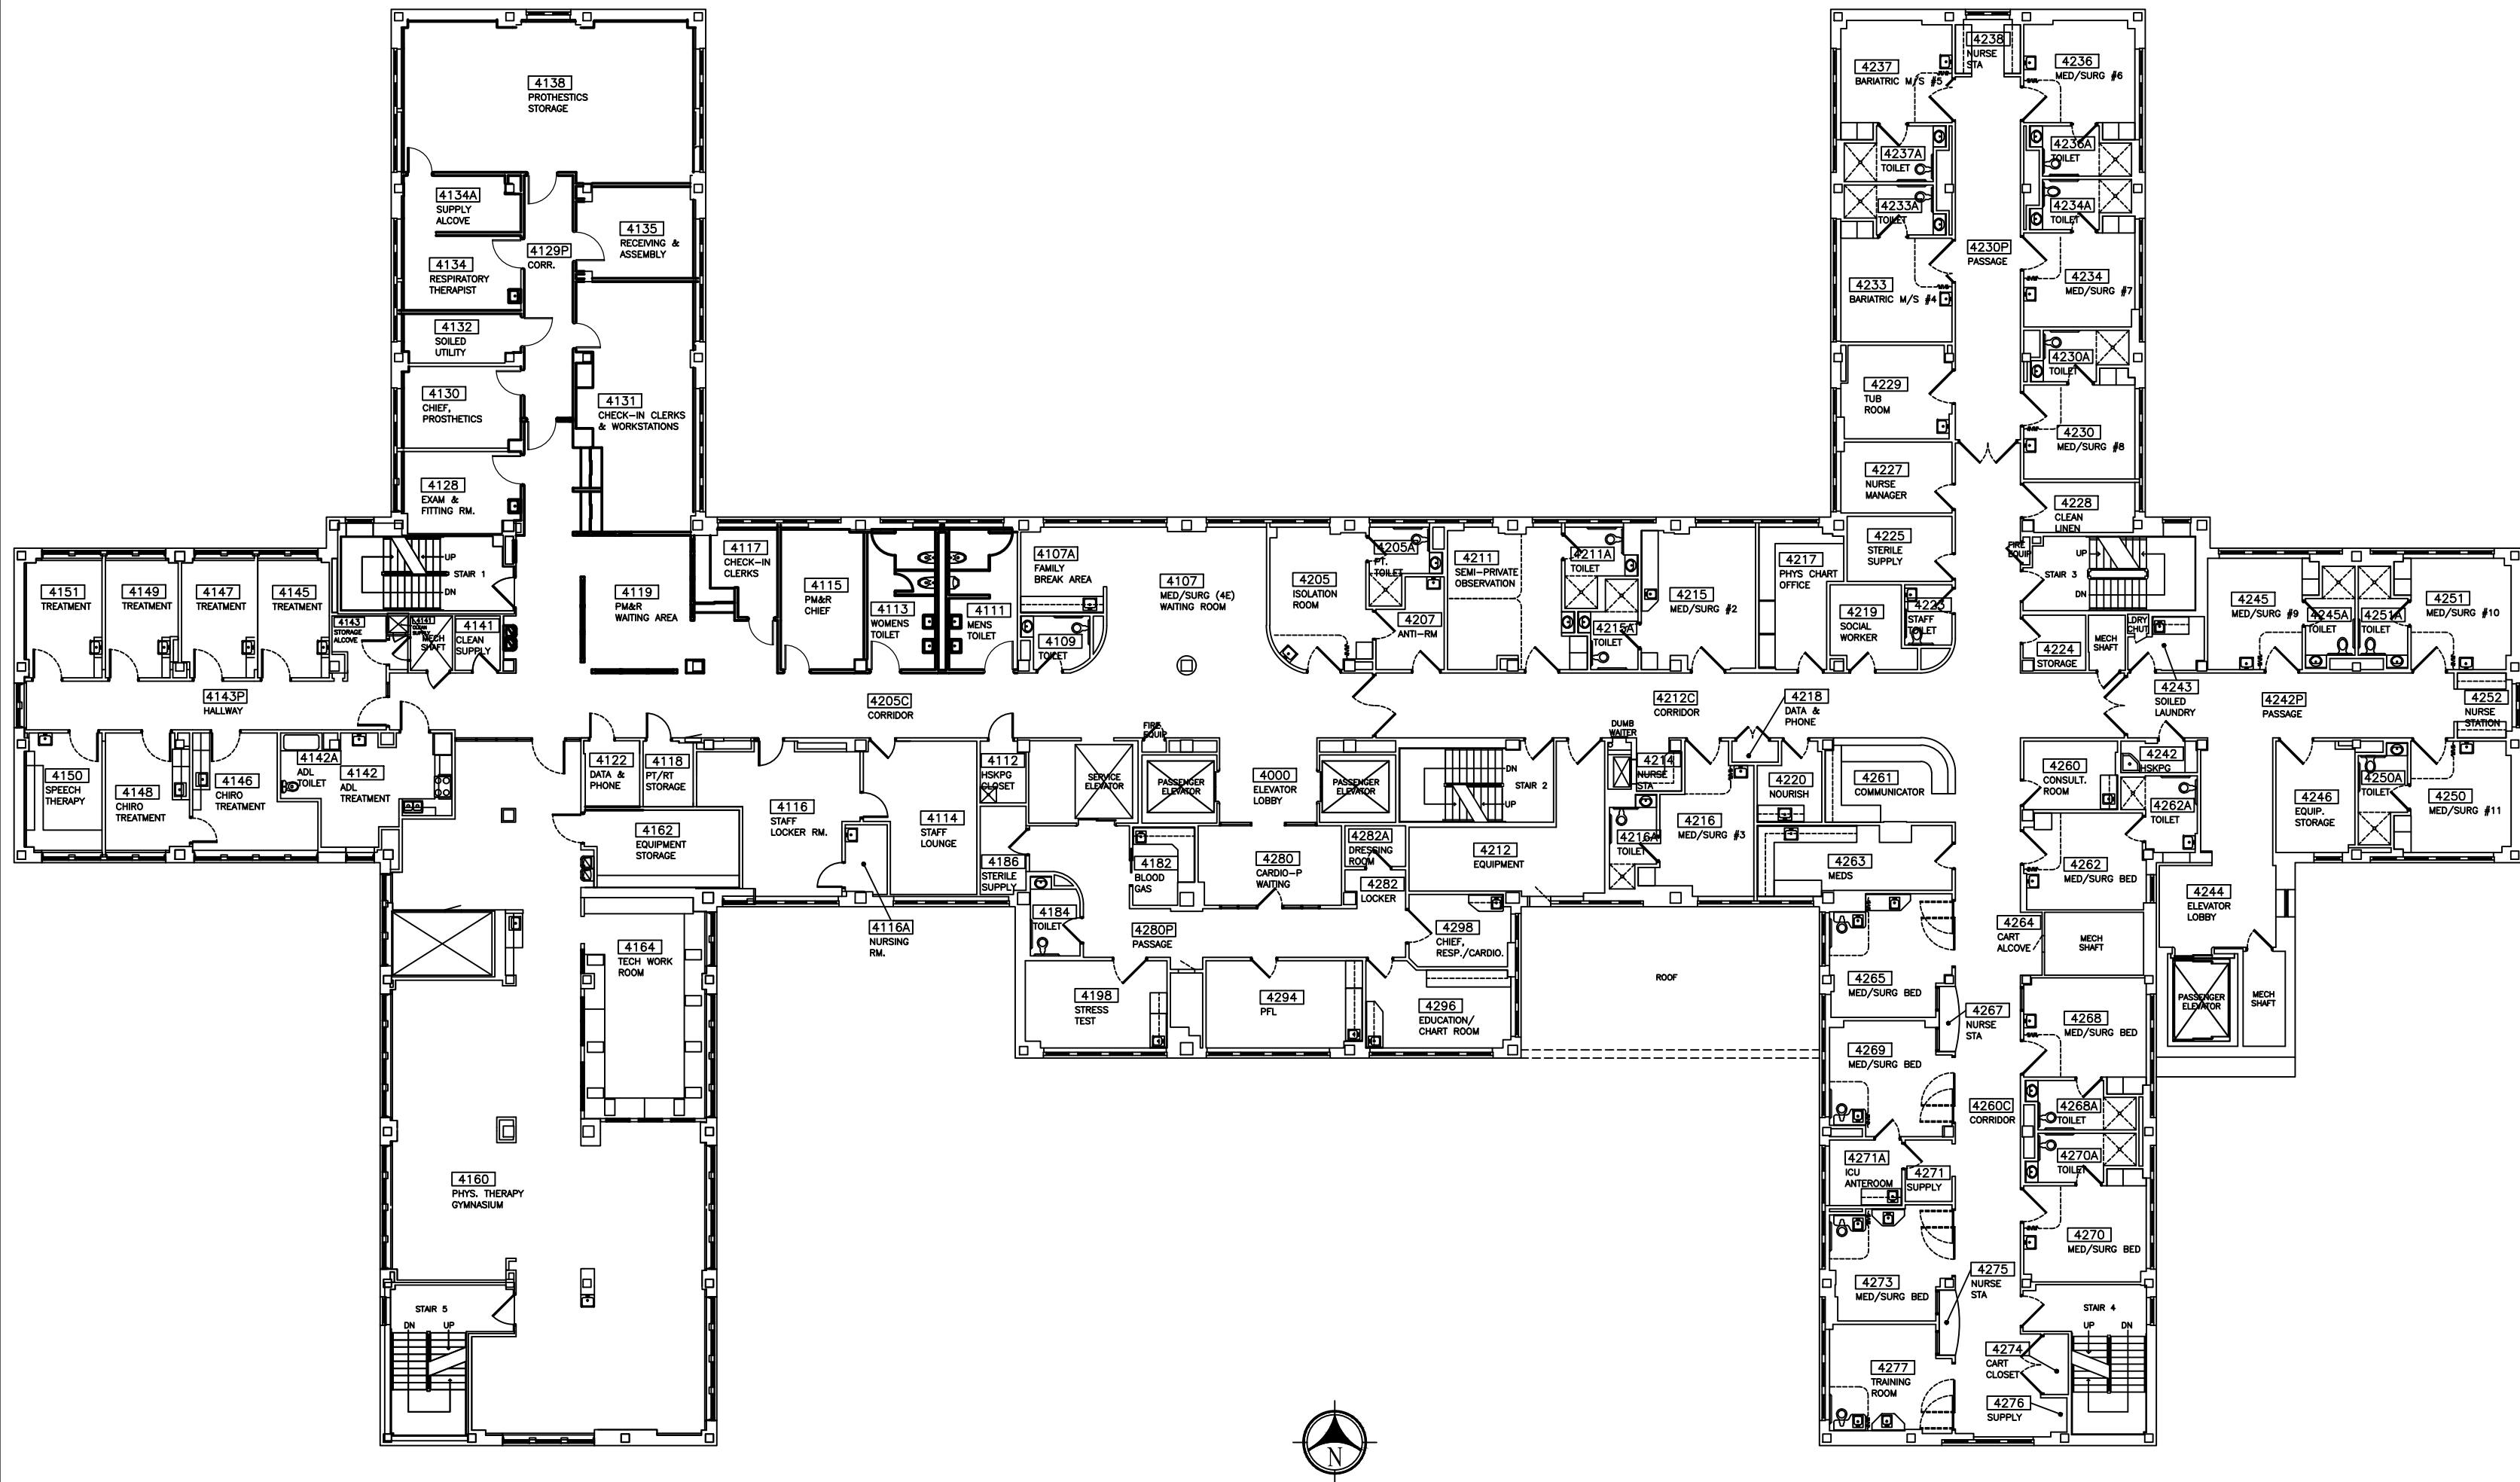

NO INDUSTRY - MEDIA - OR PUBLIC RELEASE.
Warning: This document is FOR OFFICIAL USE ONLY.


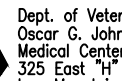
TOTAL AREA: 26,027FT²


REVISIONS	DATE	 Dept. of Veterans Affairs Oscar G. Johnson Medical Center 325 East "H" Street Iron Mountain, MI 49801	DESIGNED BY:	DRAWN BY:	CHECKED BY:	DATE:	CLIENT PROJECT #:	CONTRACT NUMBER:	DRAWING #:	DRAWING TITLE:	PROJECT TITLE:
			LOCATION:	M. SEDA	M. SEDA	11AUG17	VA MEDICAL CENTER IRON MOUNTAIN, MICHIGAN	SCALE:	BUILDING NUMBER:	AUTOCAD NAME:	SHT: OF:
						NTS	ONE		4TH FLOOR.DWG		
										FOURTH FLOOR	RECORD DWGS

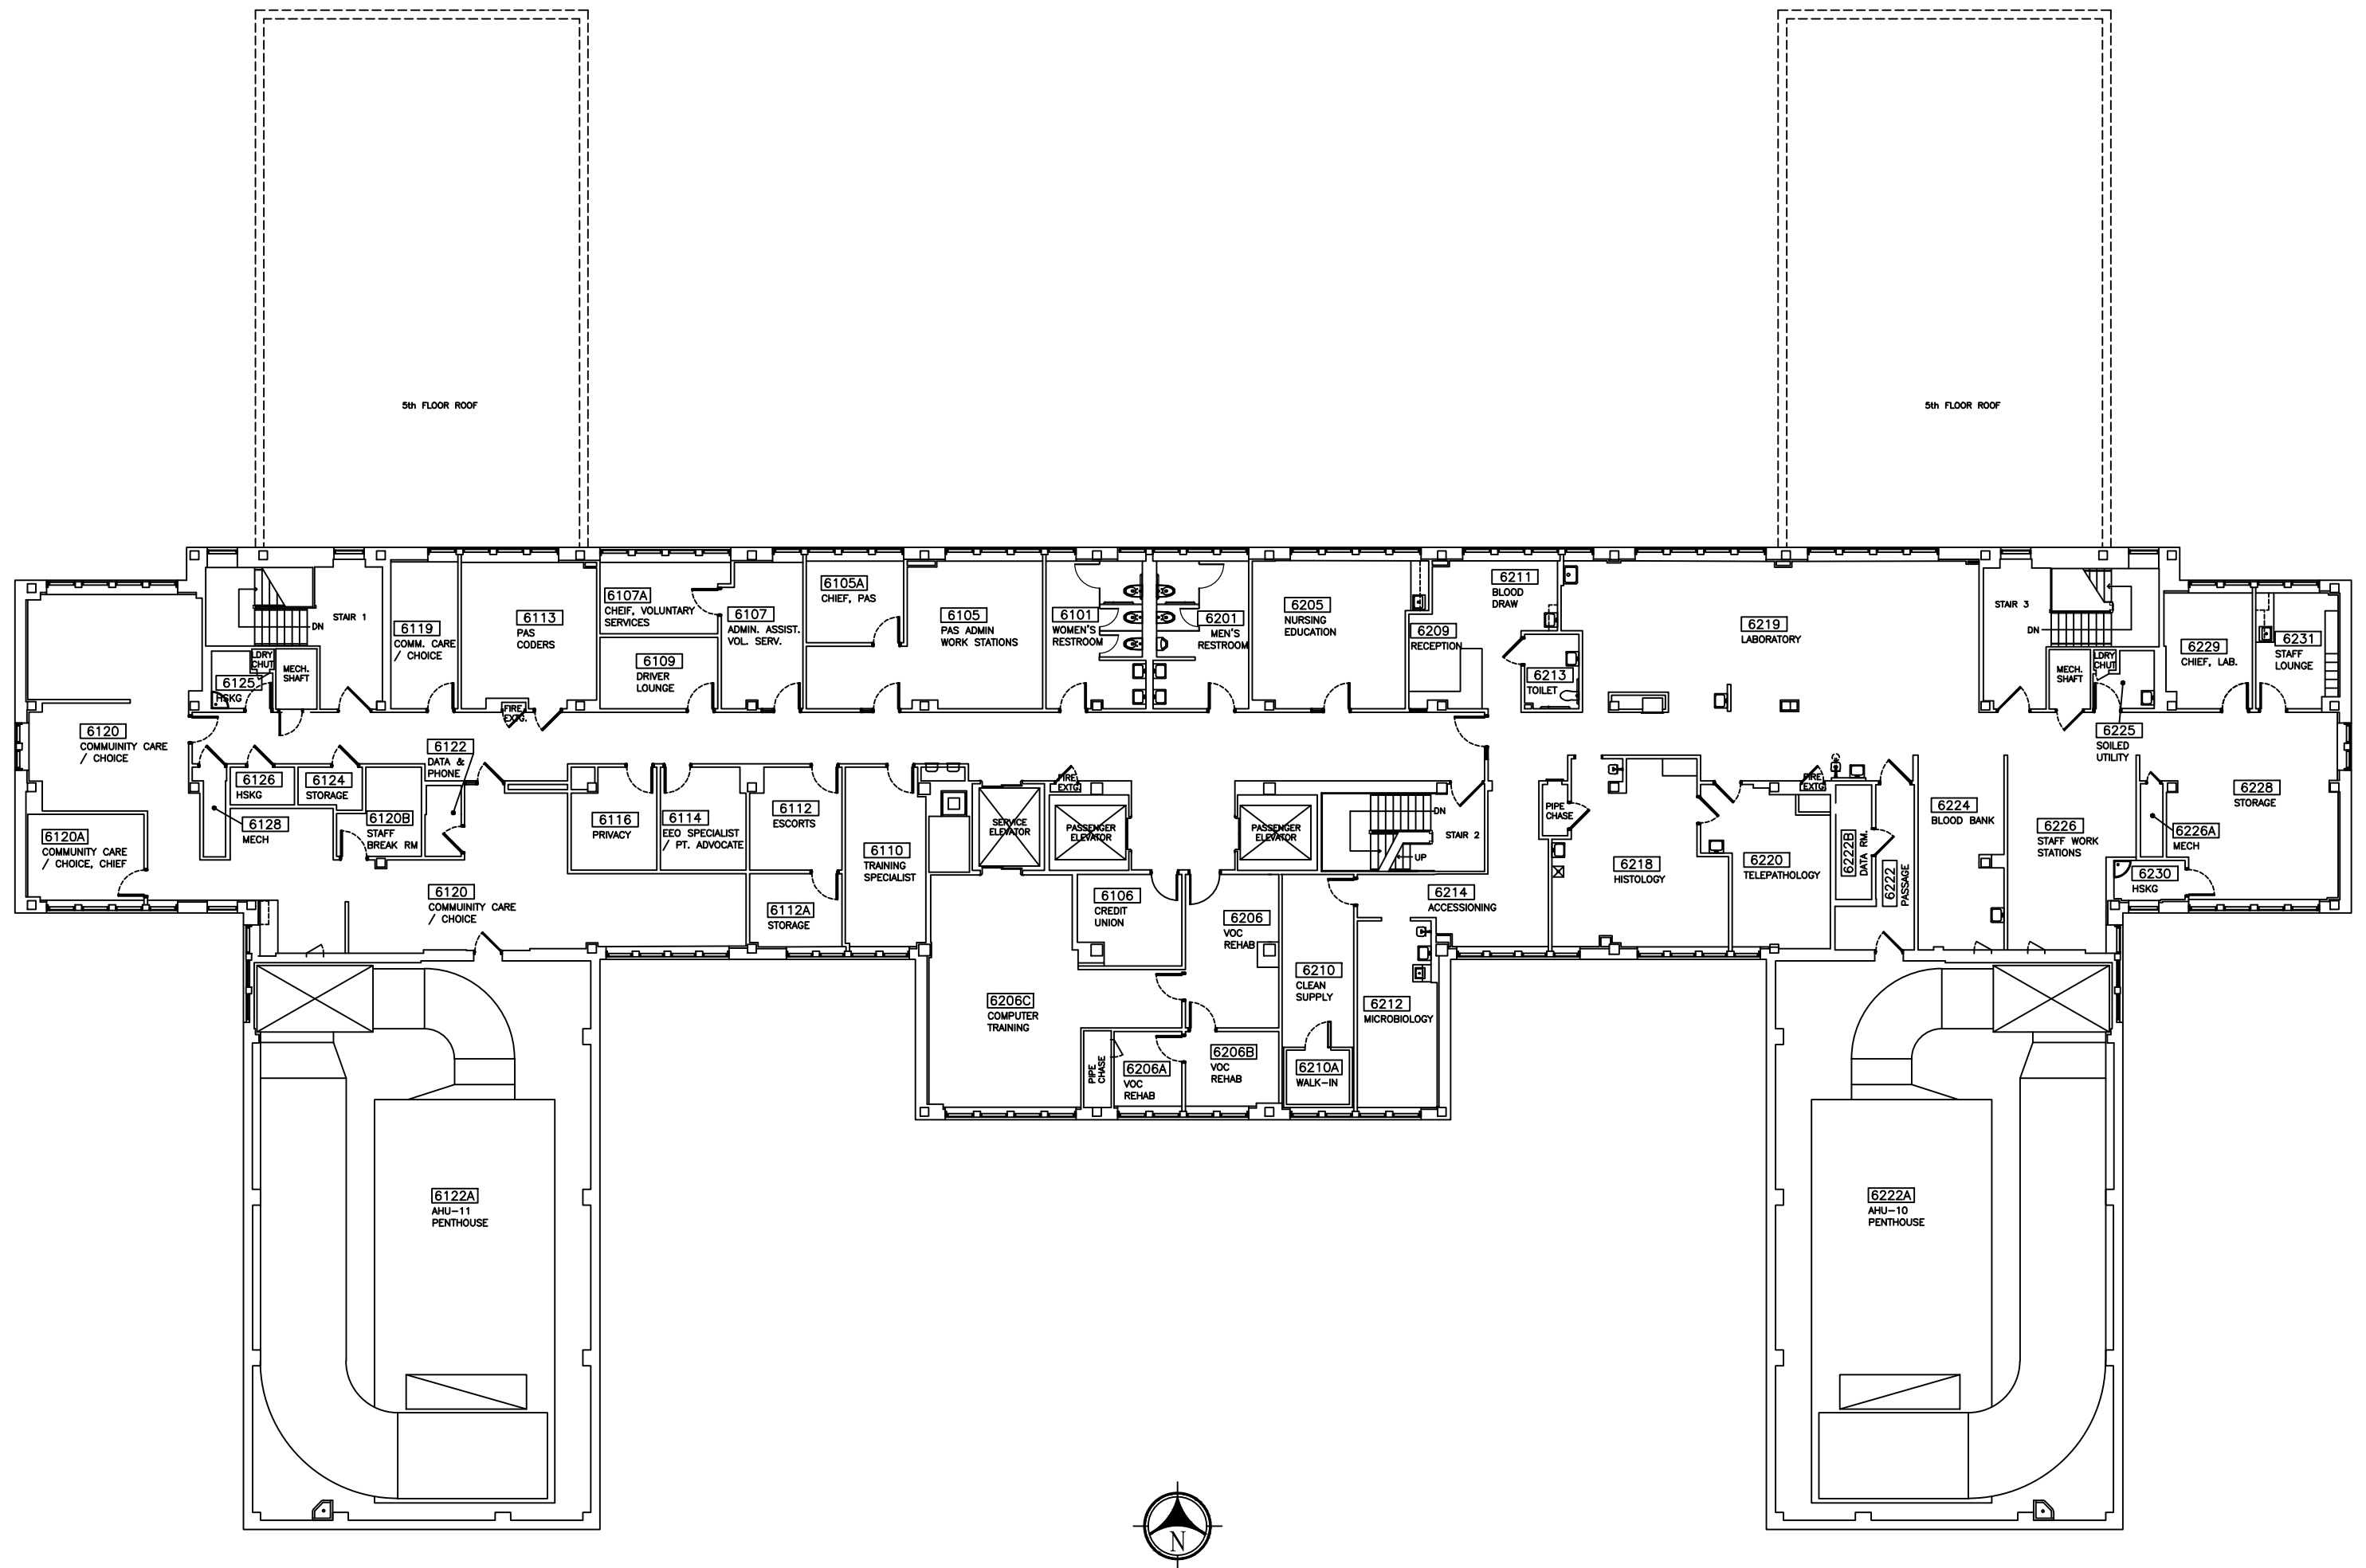

NO INDUSTRY - MEDIA - OR PUBLIC RELEASE.
Warning: This document is FOR OFFICIAL USE ONLY.



TOTAL AREA: 19,294FT²

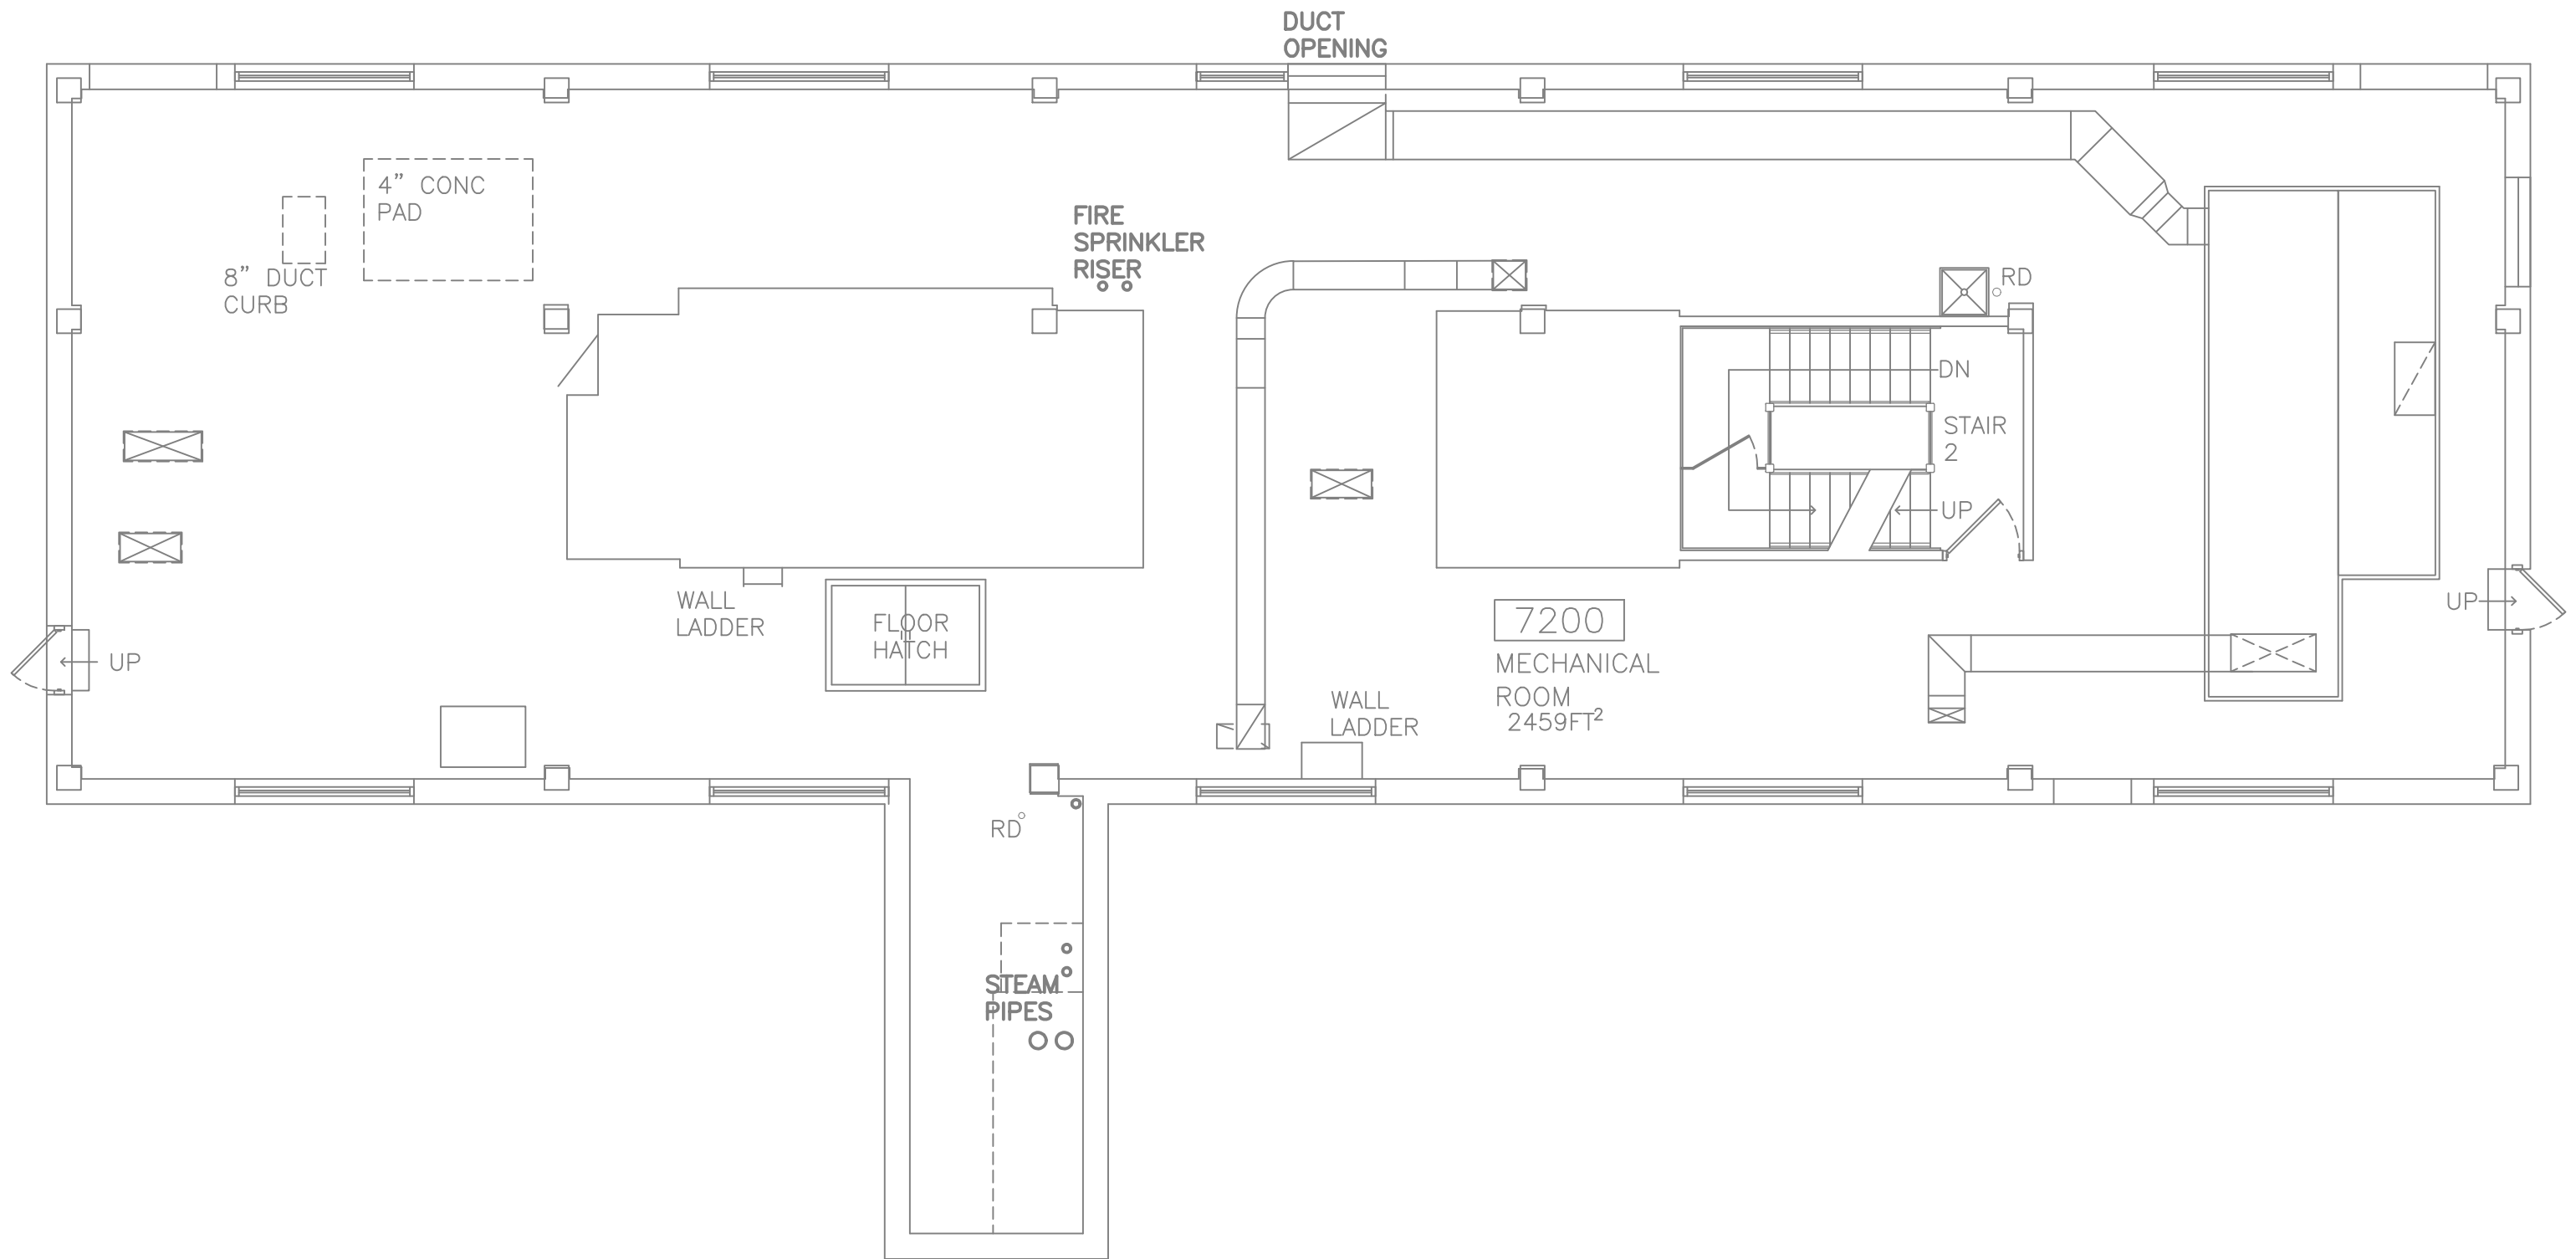		 Dept. of Veterans Affairs Oscar G. Johnson Medical Center 325 East "H" Street Iron Mountain, MI 49801		DESIGNED BY:	DRAWN BY:	CHECKED BY:	DATE:	CLIENT PROJECT #:	CONTRACT NUMBER:	DRAWING #:	DRAWING TITLE: SIXTH FLOOR	PROJECT TITLE: RECORD DWGS	
					M. SEDA	M. SEDA	11AUG17						
				LOCATION:	VA MEDICAL CENTER IRON MOUNTAIN, MICHIGAN		SCALE:	BUILDING NUMBER:	AUTOCAD NAME:	SHT:			OF:
						NTS	ONE	6TH FLOOR.DWG					
REVISIONS		DATE											



NO INDUSTRY - MEDIA - OR PUBLIC RELEASE.
Warning: This document is FOR OFFICIAL USE ONLY.

TOTAL AREA: 3,287FT²

REVISIONS		DATE			Dept. of Veterans Affairs Oscar G. Johnson Medical Center 325 East 14 th Street Iron Mountain, MI 49801	DESIGNED BY:	DRAWN BY:	CHECKED BY:	DATE:	CLIENT PROJECT #:	CONTRACT NUMBER:	DRAWING #:	DRAWING TITLE:	PROJECT TITLE:
						LOCATION:	VA MEDICAL CENTER IRON MOUNTAIN, MICHIGAN	SCALE:	NTS	BUILDING NUMBER:	ONE	AUTOCAD NAME:	SHT: OF:	SEVENTH FLOOR RECORD DWGS

