

REVISIONS

NO.	DATE	DESCRIPTION

REVISED FOR '85 BUILT CONDITIONS 4-6-84



RECORD DRAWINGS: CONTRACTOR SHALL VERIFY ALL CONDITIONS AND MATERIALS BEFORE PROCEEDING WITH CONSTRUCTION. THE CONTRACTOR SHALL BE RESPONSIBLE FOR OBTAINING ALL NECESSARY PERMITS AND APPROVALS. THIS DRAWING IS NOT TO BE USED FOR ANY OTHER PROJECTS WITHOUT THE WRITTEN CONSENT OF THE ARCHITECT.

**NOTE: AREAS A1 AND A2 ARE TO BE FULLY SPRINKLED PER NFPA 101 UNDER THIS CONTRACT**

**SECOND FLOOR PLAN**  
**AREA A1** 1/8"=1'-0"

**OUTPATIENT/CLINICAL ADDITION**

Project Title: JULY 16, 1986  
Drawing No: 575-025  
1-12

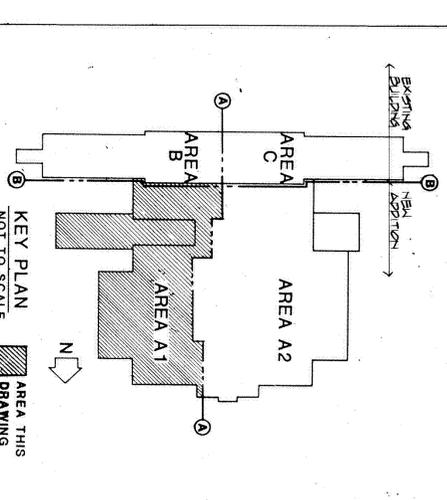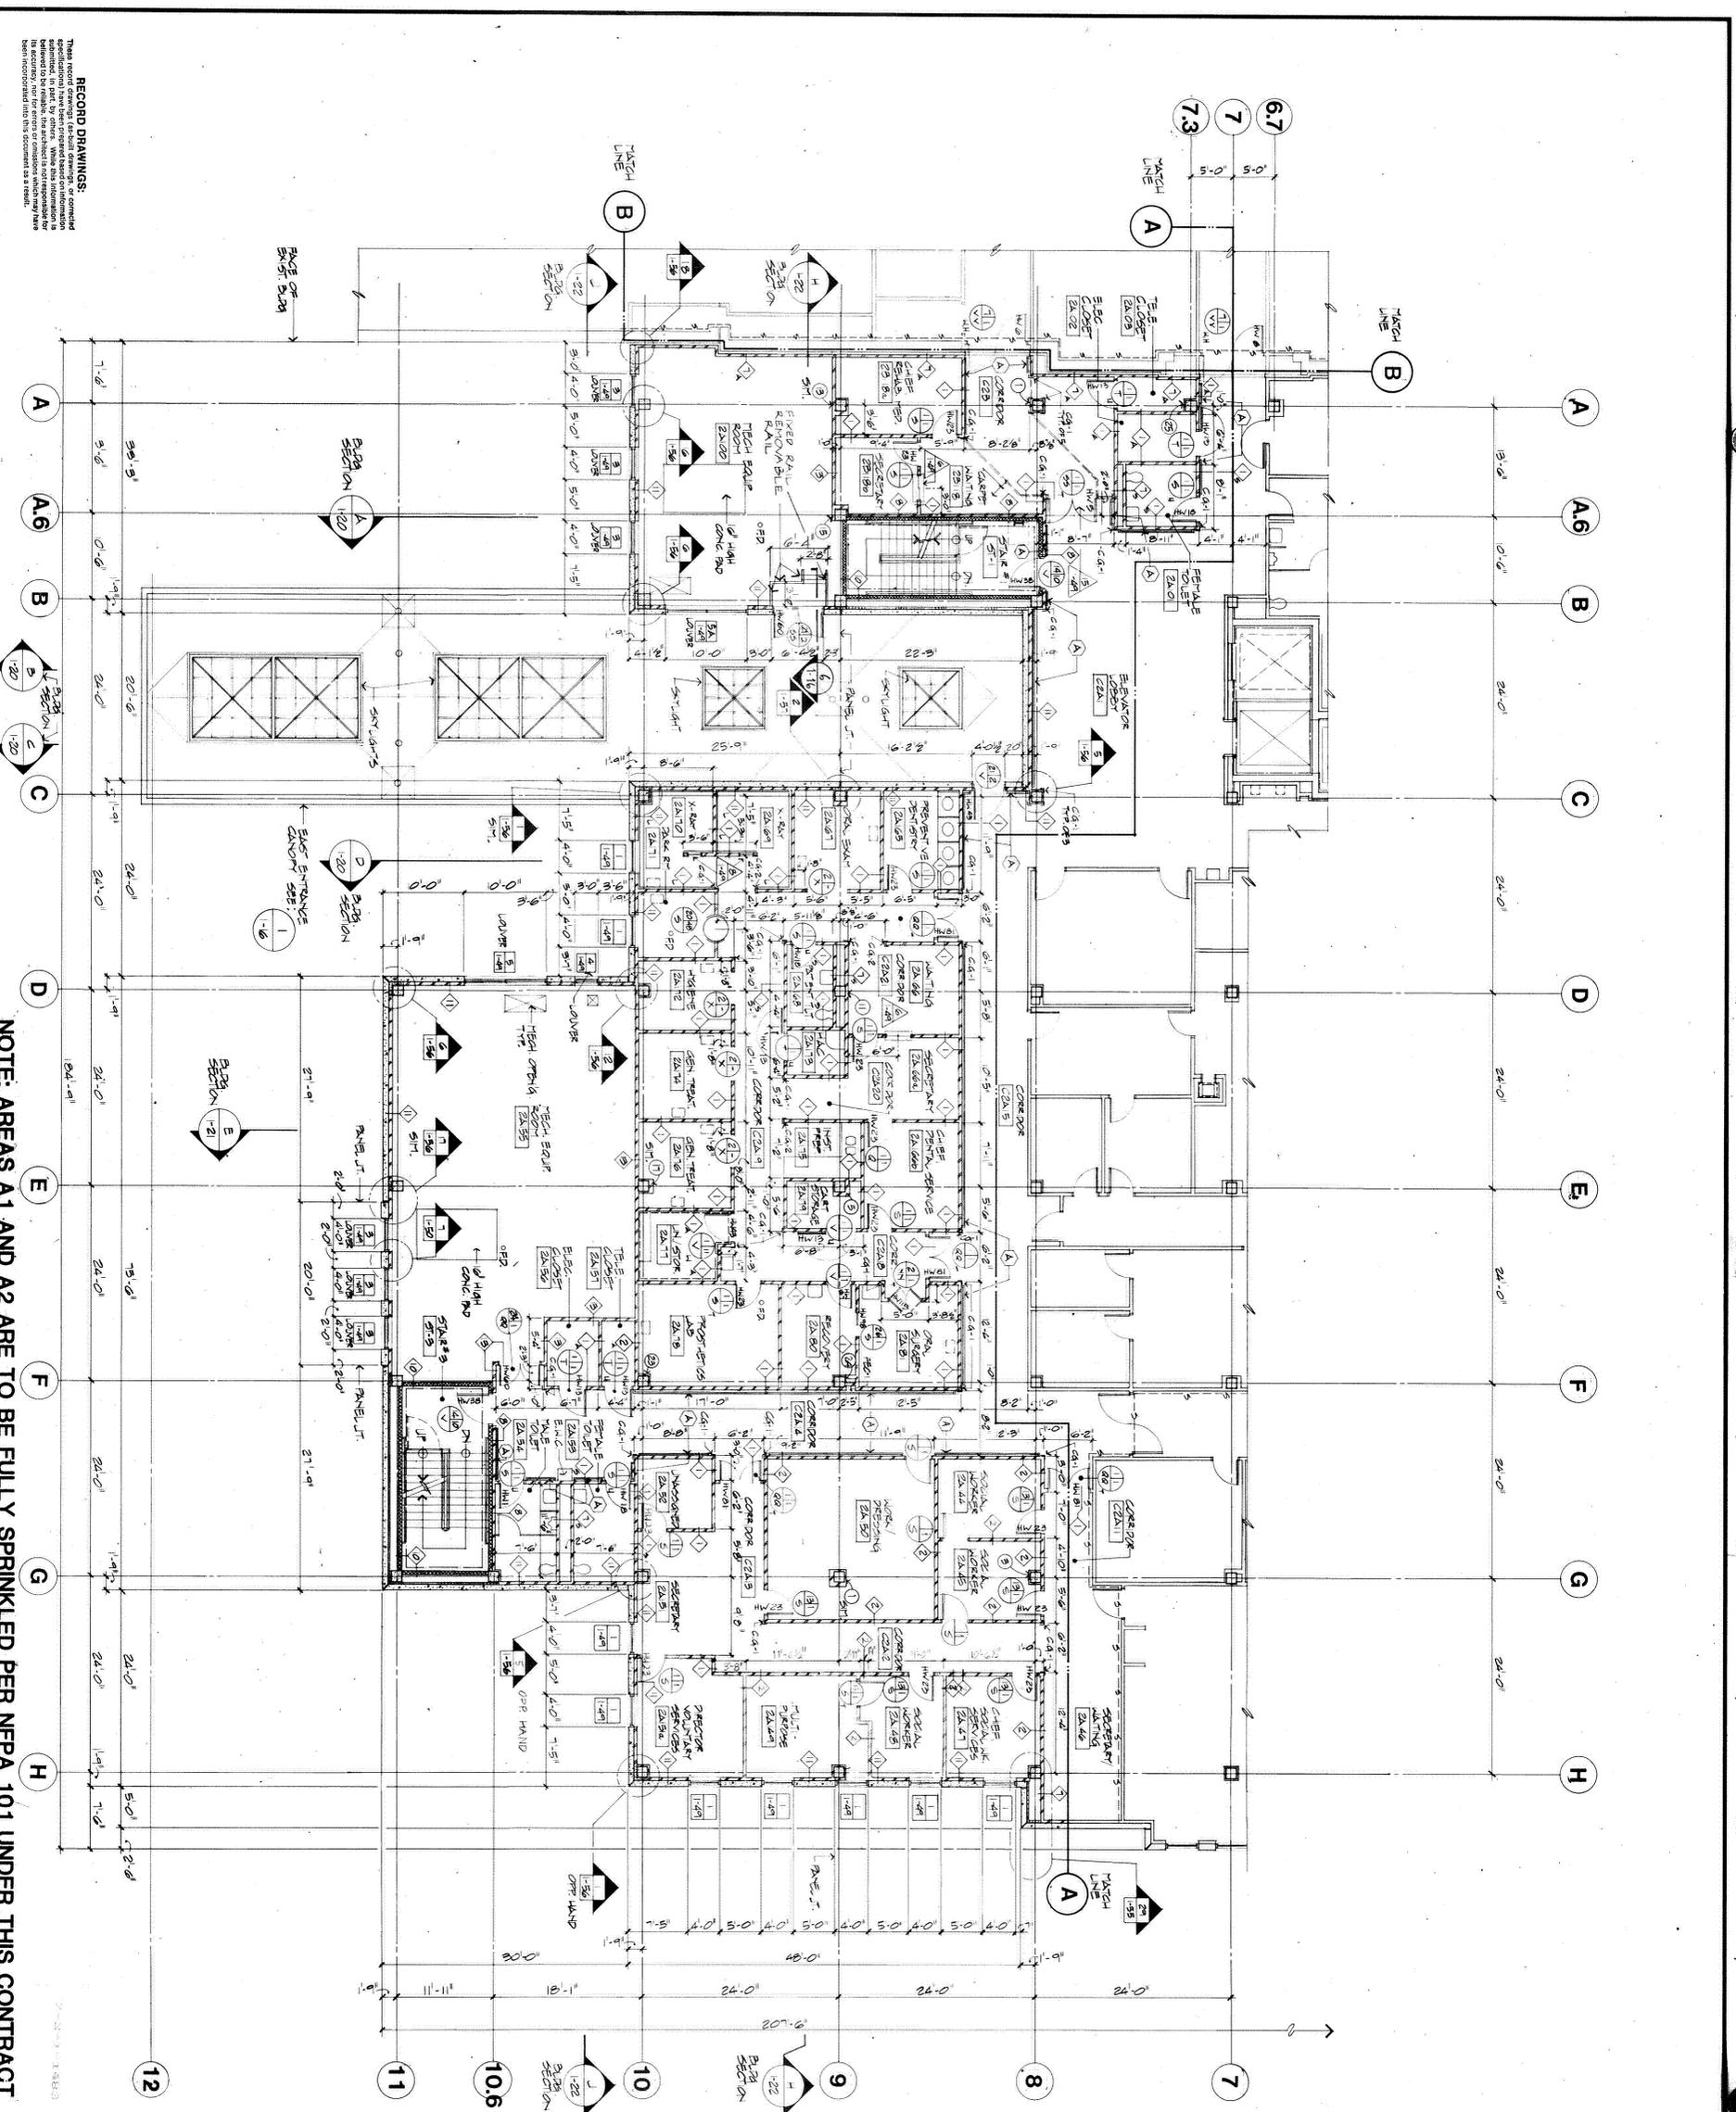

**WALL SYMBOL LEGEND**

- 1HR. WALL
- 2HR. WALL
- 1HR. SMOKE WALL
- LEAD LINED WALL

**DENTAL SERVICE**

**SOCIAL WORK SERVICE**

SECOND FLOOR PLAN FINISH FLOOR ELEVATION: +890.65

- GENERAL FLOOR PLAN NOTES**
- FOR STANDARD ARCHITECTURAL SYMBOLS, REFER TO UNIFORM SYMBOLS AND MATERIAL INDICATORS, REFER TO SHEET 1-3A.
  - FOR LARGE SCALE STAIR PLANS, SECTIONS AND 1-3A.
  - FOR LARGE SCALE ELEVATOR AND DUMBWELL SECTIONS AND DETAILS, REFER TO SHEETS 1-34 AND 1-35.
  - FOR DOOR AND FRAME TYPES AND SIZES, REFER TO SHEET 1-40.
  - FOR INTERIOR WALL TYPES, REFER TO SHEET 1-30.
  - FOR INTERIOR COLUMN PLAN DETAILS, REFER TO SHEET 1-54 AND 1-55.
  - FOR 1/4" PLAN ENTAILS, SHOWING EQUIPMENT, CASEWORK, TOILET ROOM LAYOUTS AND RELATED SCHEDULES AND REFERENCING, THROUGHOUT THE DRAWINGS, REFER TO SHEET 1-32.
  - CONTRACTOR TO FIELD VERIFY LOCATION OF EXISTING STRUCTURAL MEMBERS AND CONDITIONS TO EXISTING CORRIDORS.
  - FOR ROOM FINISH REQUIREMENTS, REFER TO SHEET 1-30.
  - FOR INTERIOR FINISH REQUIREMENTS, REFER TO SHEET 1-30.
  - FOR INTERIOR CORNER GUARD DETAILS, REFER TO SHEET 1-30.
  - FOR FIRE EXTINGUISHER CABINET (FEC) DETAILS, REFER TO DETAIL 5, SHEET 1-60.
  - FOR ELECTRIC WATER COOLER (E.W.C.) DETAILS, REFER TO DETAIL 10, SHEET 1-60.