


### LEGEND

- █ EDUCATIONAL (1)
- █ DIGITAL SIGNAGE (5)
- █ PLAYER ONLY (2)

1. BUILDING 77 ELEVATOR LOBBY
2. ACROSS FROM BUILDING 204 ELEVATORS
3. WAITING AREA ACROSS FROM ELEVATORS
4. OUTSIDE CONFERENCE CENTER
5. OUTSIDE CONFERENCE CENTER
6. ELEVATOR LOBBY
7. SURGERY FAMILY WAITING
8. ELEVATOR LOBBY NEAR ICU & PCU

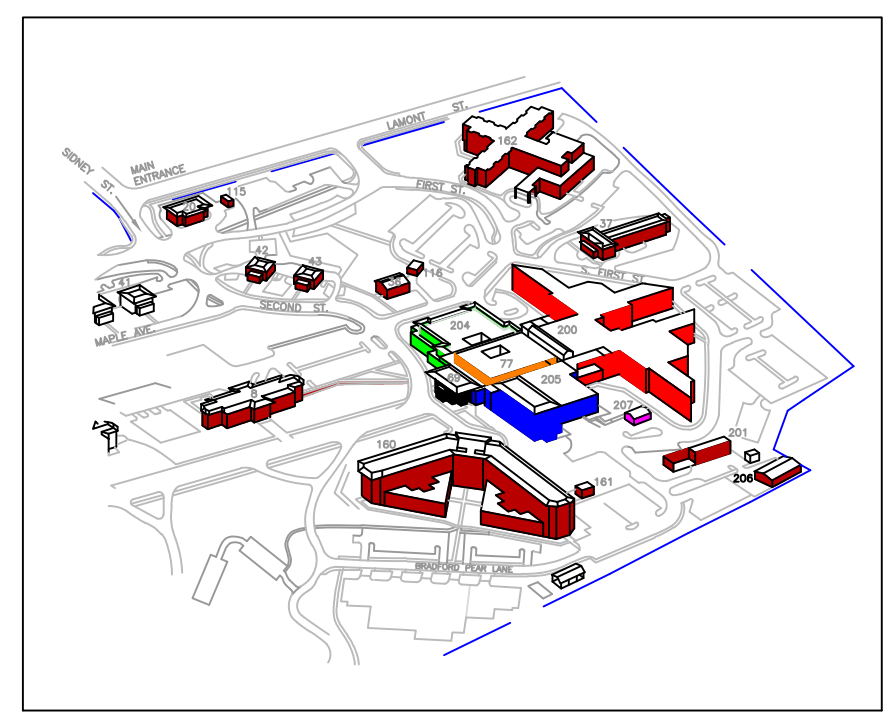

GROUND FLOOR PLAN BLDG. 69 / 77 / 200 / 204 / 205 / 207

KEY PLAN  
(PARTIAL SITE PLAN)

\*CONFIRM LOCATIONS OF DATA, POWER, AND BLOCKING. NOTE CURRENT LOCATIONS... IF APPLICABLE.

|   |           |---|-----------|---|-------------------------------|--|---|--|---|--|-------------------------|-----------------------------------|--|-----------------|-------------------------------|----------------------------|--|--|--|--|--------------------------------|---------------------------------------|
| <table border="1" style="width: 100%; border-collapse: collapse;"> <tr> <td style="width: 50%; height: 40px;">Revisions</td> <td style="width: 50%; height: 40px;">Date</td> </tr> </table> | Revisions | Date                                    |                               | <table border="1" style="width: 100%; border-collapse: collapse;"> <tr> <td colspan="2">Drawing Title<br/><i>AS-BUILT GROUND FLR.<br/>HOSPITAL GROUP</i></td> <td colspan="2">Project Title<br/><i>DIGITAL DISPLAY</i></td> <td>Date<br/><i>12/16/11</i></td> </tr> <tr> <td colspan="2">Approved: Chief, Engineering Svc.</td> <td>Building Number</td> <td>Checked By:<br/><i>CLAWSON</i></td> <td>Drawn By:<br/><i>WALKER</i></td> </tr> <tr> <td colspan="2">Approved: Asst.Chief, Engineering Svc.</td> <td colspan="2">Location :<br/><i>MOUNTAIN HOME, TN</i></td> <td>DRAWING NO.<br/><br/>Dwg. 1 of 5</td> </tr> </table> | Drawing Title<br><i>AS-BUILT GROUND FLR.<br/>HOSPITAL GROUP</i> |  | Project Title<br><i>DIGITAL DISPLAY</i> |  | Date<br><i>12/16/11</i> | Approved: Chief, Engineering Svc. |  | Building Number | Checked By:<br><i>CLAWSON</i> | Drawn By:<br><i>WALKER</i> | Approved: Asst.Chief, Engineering Svc. |  | Location :<br><i>MOUNTAIN HOME, TN</i> |  | DRAWING NO.<br><br>Dwg. 1 of 5 | <br>Department of<br>Veterans Affairs |
| Revisions   | Date      |   |                               |  |   |  |   |  |                         |                                   |  |                 |                               |                            |  |  |  |  |                                |                                       |
| Drawing Title<br><i>AS-BUILT GROUND FLR.<br/>HOSPITAL GROUP</i>   |           | Project Title<br><i>DIGITAL DISPLAY</i> |                               | Date<br><i>12/16/11</i>  |   |  |   |  |                         |                                   |  |                 |                               |                            |  |  |  |  |                                |                                       |
| Approved: Chief, Engineering Svc.   |           | Building Number                         | Checked By:<br><i>CLAWSON</i> | Drawn By:<br><i>WALKER</i>   |   |  |   |  |                         |                                   |  |                 |                               |                            |  |  |  |  |                                |                                       |
| Approved: Asst.Chief, Engineering Svc.  |           | Location :<br><i>MOUNTAIN HOME, TN</i>  |                               | DRAWING NO.<br><br>Dwg. 1 of 5   |   |  |   |  |                         |                                   |  |                 |                               |                            |  |  |  |  |                                |                                       |