


LEGEND

— EDUCATIONAL (2)
— DIGITAL SIGNAGE (7)

1. X-RAY
2. ACROSS FROM BUILDING 204 ELEVATORS
3. CORRIDOR OVERLOOKING ATRIUM
4. BUILDING 200 CENTER ELEVATOR LOBBY
5. EYE CLINIC WAITING
6. B2 / C2 ELEVATOR LOBBY
7. B2 / C2 CORNER
8. D2 / E2 CORNER
9. D2 / E2 ELEVATOR LOBBY

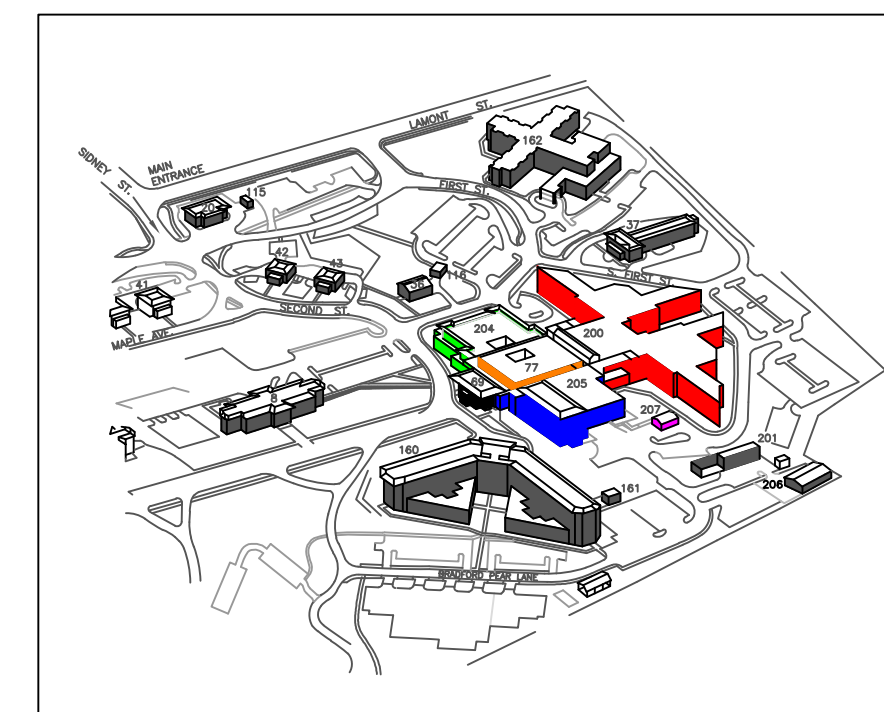

SECOND FLOOR PLAN BLDG. 69 / 77 / 200 / 204 / 205 / 207

KEY PLAN
(PARTIAL SITE PLAN)

* CONFIRM LOCATIONS OF DATA, POWER, AND BLOCKING. NOTE CURRENT LOCATIONS... IF APPLICABLE.

Drawing Title AS-BUILT SECOND FLR. HOSPITAL GROUP		Project Title DIGITAL DISPLAY		Date 12/16/11
Approved: Chief, Engineering Svc.		Building Number		Project No.
Approved: Asst.Chief, Engineering Svc.		Checked By: CLAWSON	Drawn By: WALKER	DRAWING NO.
Location : MOUNTAIN HOME, TN		Dwg. 3 Of 5		