


HOMOGENEOUS AREAS	MATERIAL
①	LABELED / ASSUMED ACM PIPE INSULATION

HOMOGENEOUS AREAS	MATERIAL
②	WELDED SHEET VINYL FLOORING
③	HARD PLASTER SKIM COAT
③A	PLASTER BASE COAT
④	12" WHITE/BLUE-GREEN SPOT FLOOR
④A	FLOOR TILE MASTIC TILE
⑤	SUSPENDED CEILING TILE

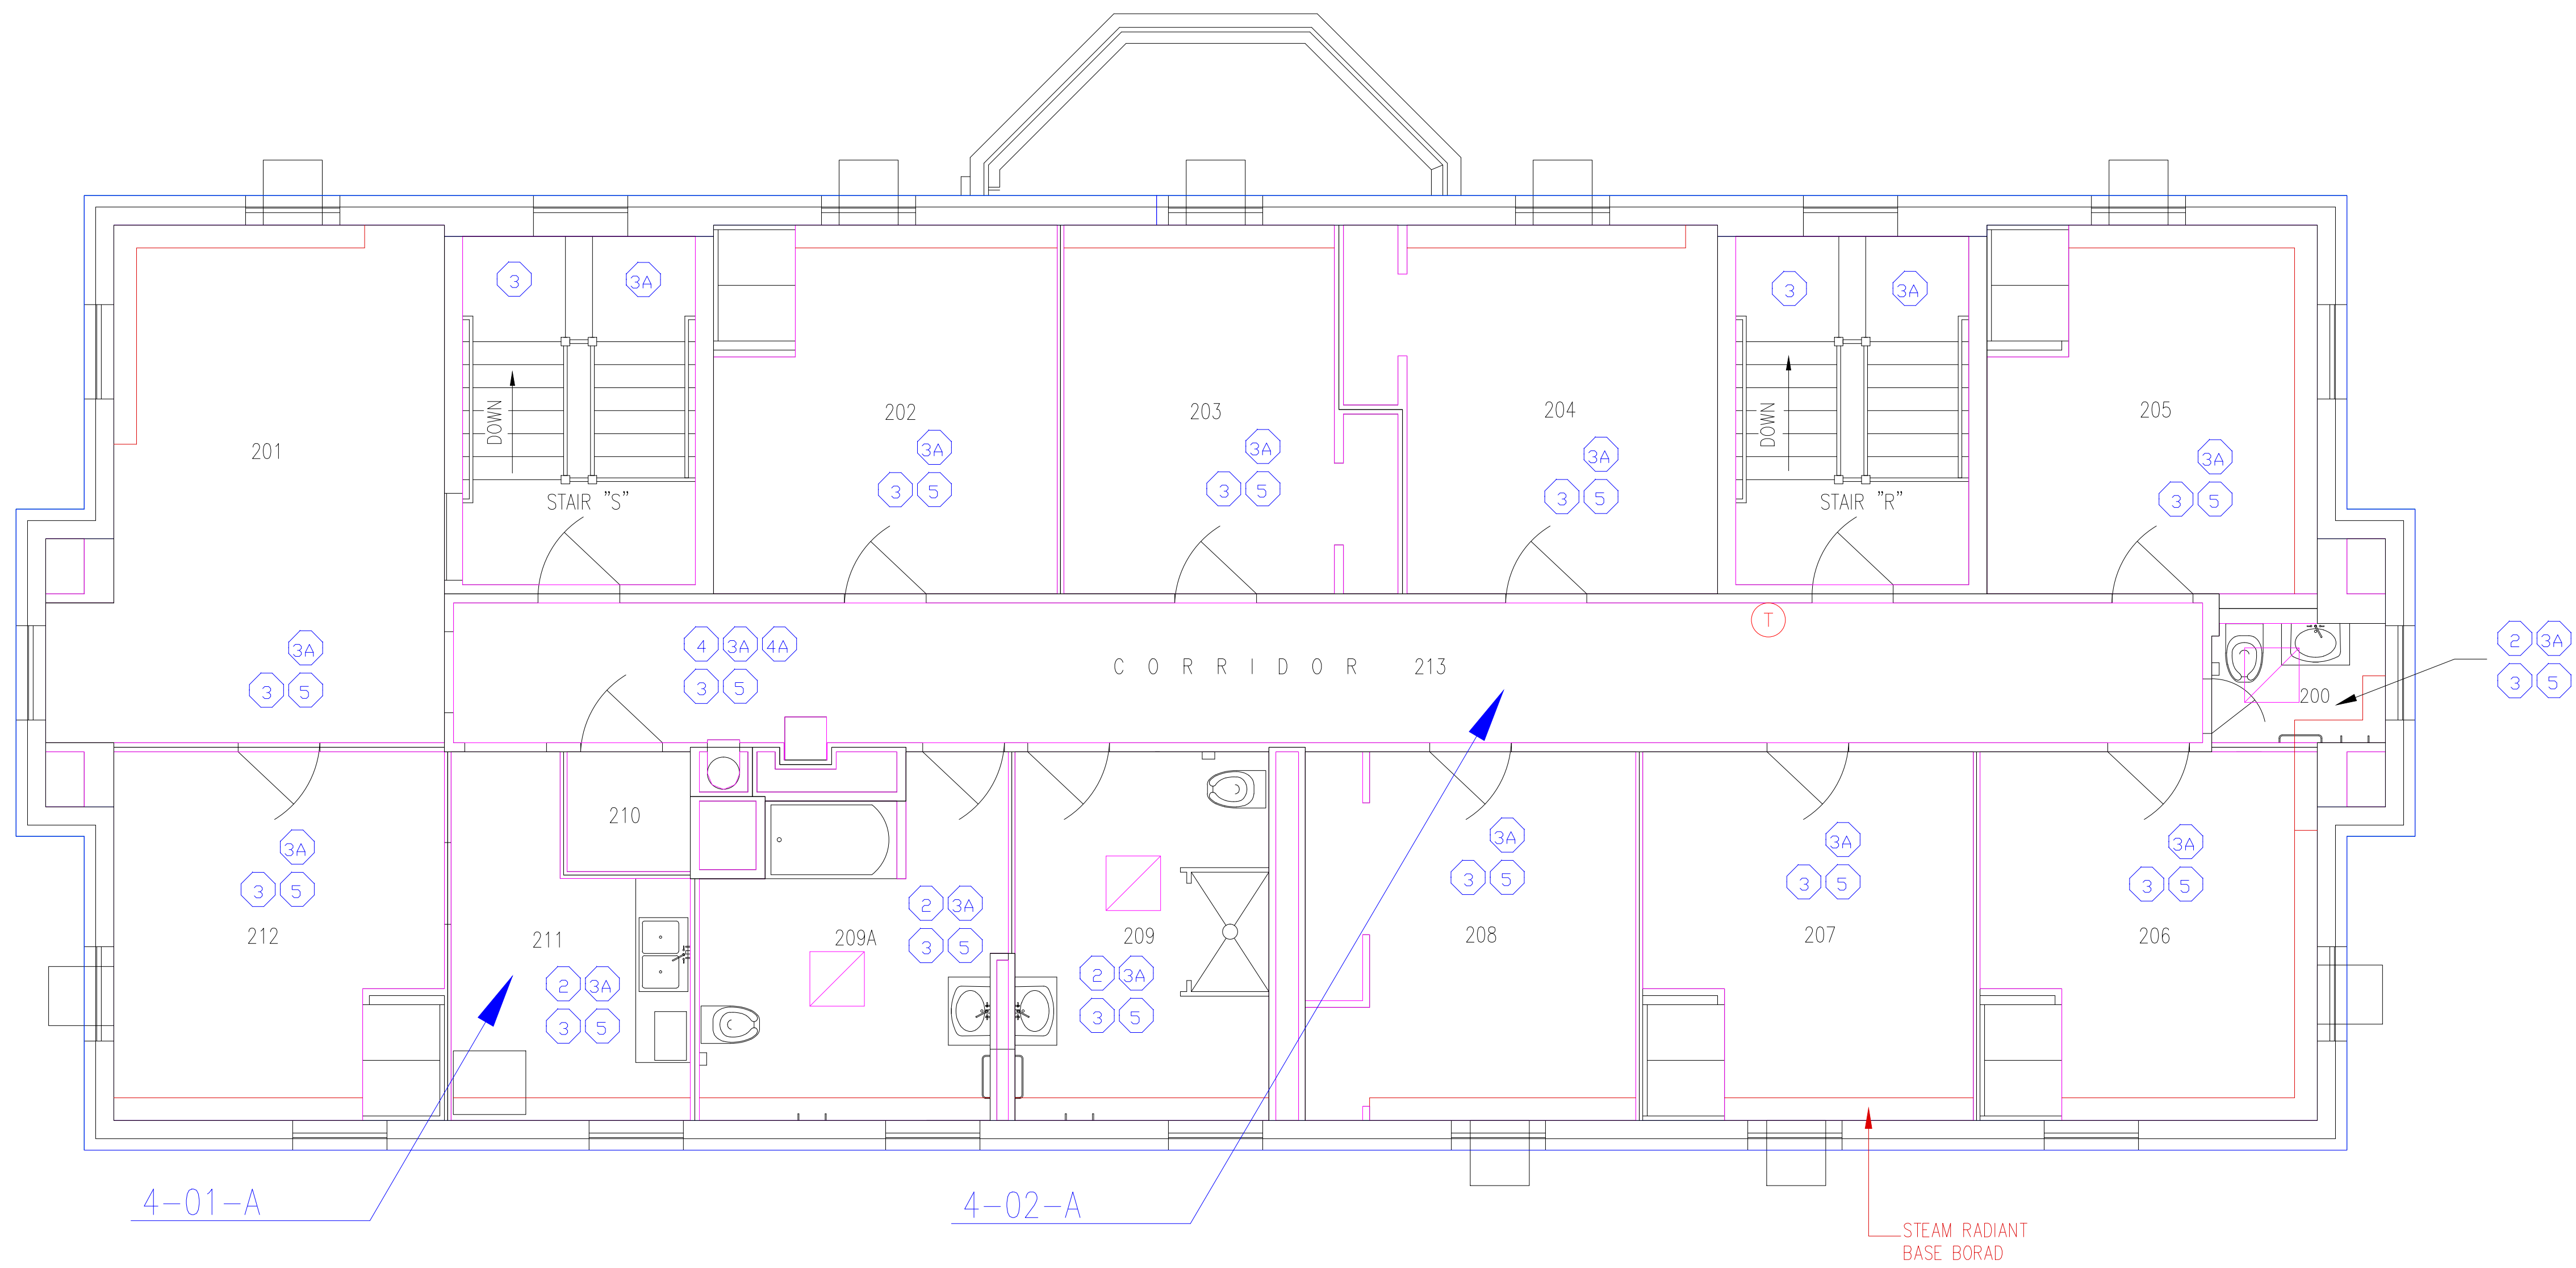

SPACE SURVEY - BUILDING 4 - SECOND FLOOR

SCALE: 1/4" = 1'-0"

AHRA RE-INSPECTION		02.28.2011						Drawing Title SECOND FLOOR PLAN MECHANICAL		Project Title AS-BUILT Drawings		Date 01-21-2008				VA Department of Veterans Affairs			
								Approved:		Building Number 04		Checked	Drawn					Project No.	
								Approved:		Location VA BUTLER		Drawing No.							
Revisions		Date				Professional Seal													