

BENCHMARKS

BENCHMARK A
706 BOLL 22.5 ABOVE GROUND NORTH SIDE SARGENT
ELEV=934.59
SIDE OF OLD ROAD SOUTH SIDE SEE MARKS



BENCHMARK B
FIELD NORTH SIDE OF BELLOD ROAD BETWEEN HOUSE NO.
ELEV=933.19

BENCHMARK C
FIELD NORTH SIDE OF BELLOD ROAD BETWEEN HOUSE NO.
ELEV=944.87

LEGEND

SPRING LOCATION
SPRING 1.0 NUMBER
SPRING DEPTH

B-16
12 ft.

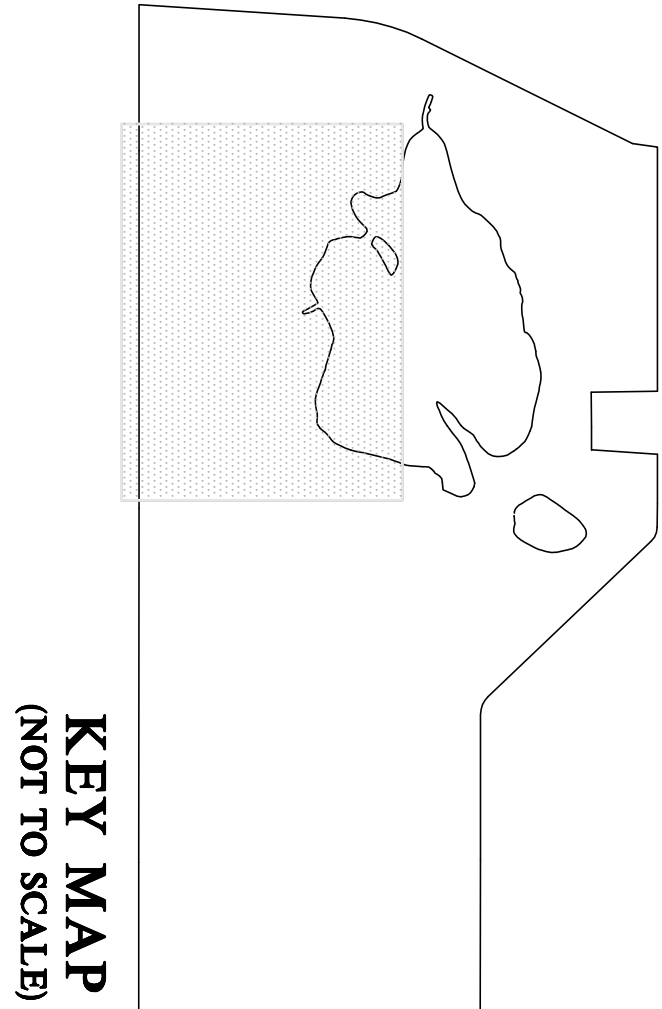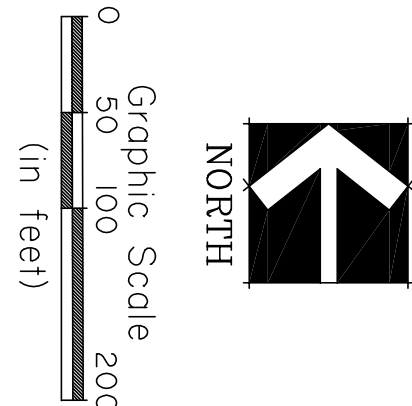

RECORD DRAWINGS		07/08/2011	
AS-BUILT NOTE: THE INFORMATION REPRESENTED ON THIS PLAN/DETAIL SHEET IS FROM CONTRACTORS' RESIDENT ENGINEERS' AS-BUILT PROVIDED INFORMATION ALONG WITH COMPLETED INFORMATION FROM A/E SITE VISIT REPORTS, PHOTOGRAPHS AND INFORMATION AND IS NOT DEEMED TO BE ACCURATE, NOT COMPLETE BUT AN ASSUMED CONSTRUCTED CONDITION AT THE SITE. SEE CONTRACTOR PROVIDED AS-BUILT DRAWINGS FOR ADDITIONAL INFORMATION.			
CONSULTANTS:			
the LA group Landscape Architecture and Engineering, P.C. 40 Long Alley Saratoga Springs, NY 12866 518/587-8100 Telefax 518/587-0180			
ARCHITECT/ENGINEERS:			
URS SOUTHFIELD, MI 48034 27777 FLY 248-204-5900 TELEFAX 248-204-5901			
Drawing Title PHASE 1B SUBSURFACE INVESTIGATION SURVEY		Project Title GREAT LAKES NATIONAL CEMETERY PHASE 1B EXPANSION	
Approved: David C. Sharkey, Acting NCA Team Leader 		Location HOLLY, MICHIGAN	
Date FEB. 29, 2008		Checked CD	
Contracted By: Kevin W. Dik, NCA Project Manager		Drawing Number B-301	
		Building Number	
		Drawing Number B-301	
		Dwg. 8 of 73	
		Department of Veterans Affairs	