


three inches = one foot
 one and one half inches = one foot
 one inch = one foot
 three quarters inch = one foot
 one half inch = one foot
 three eighths inch = one foot
 one quarter inch = one foot
 one eighth inch = one foot

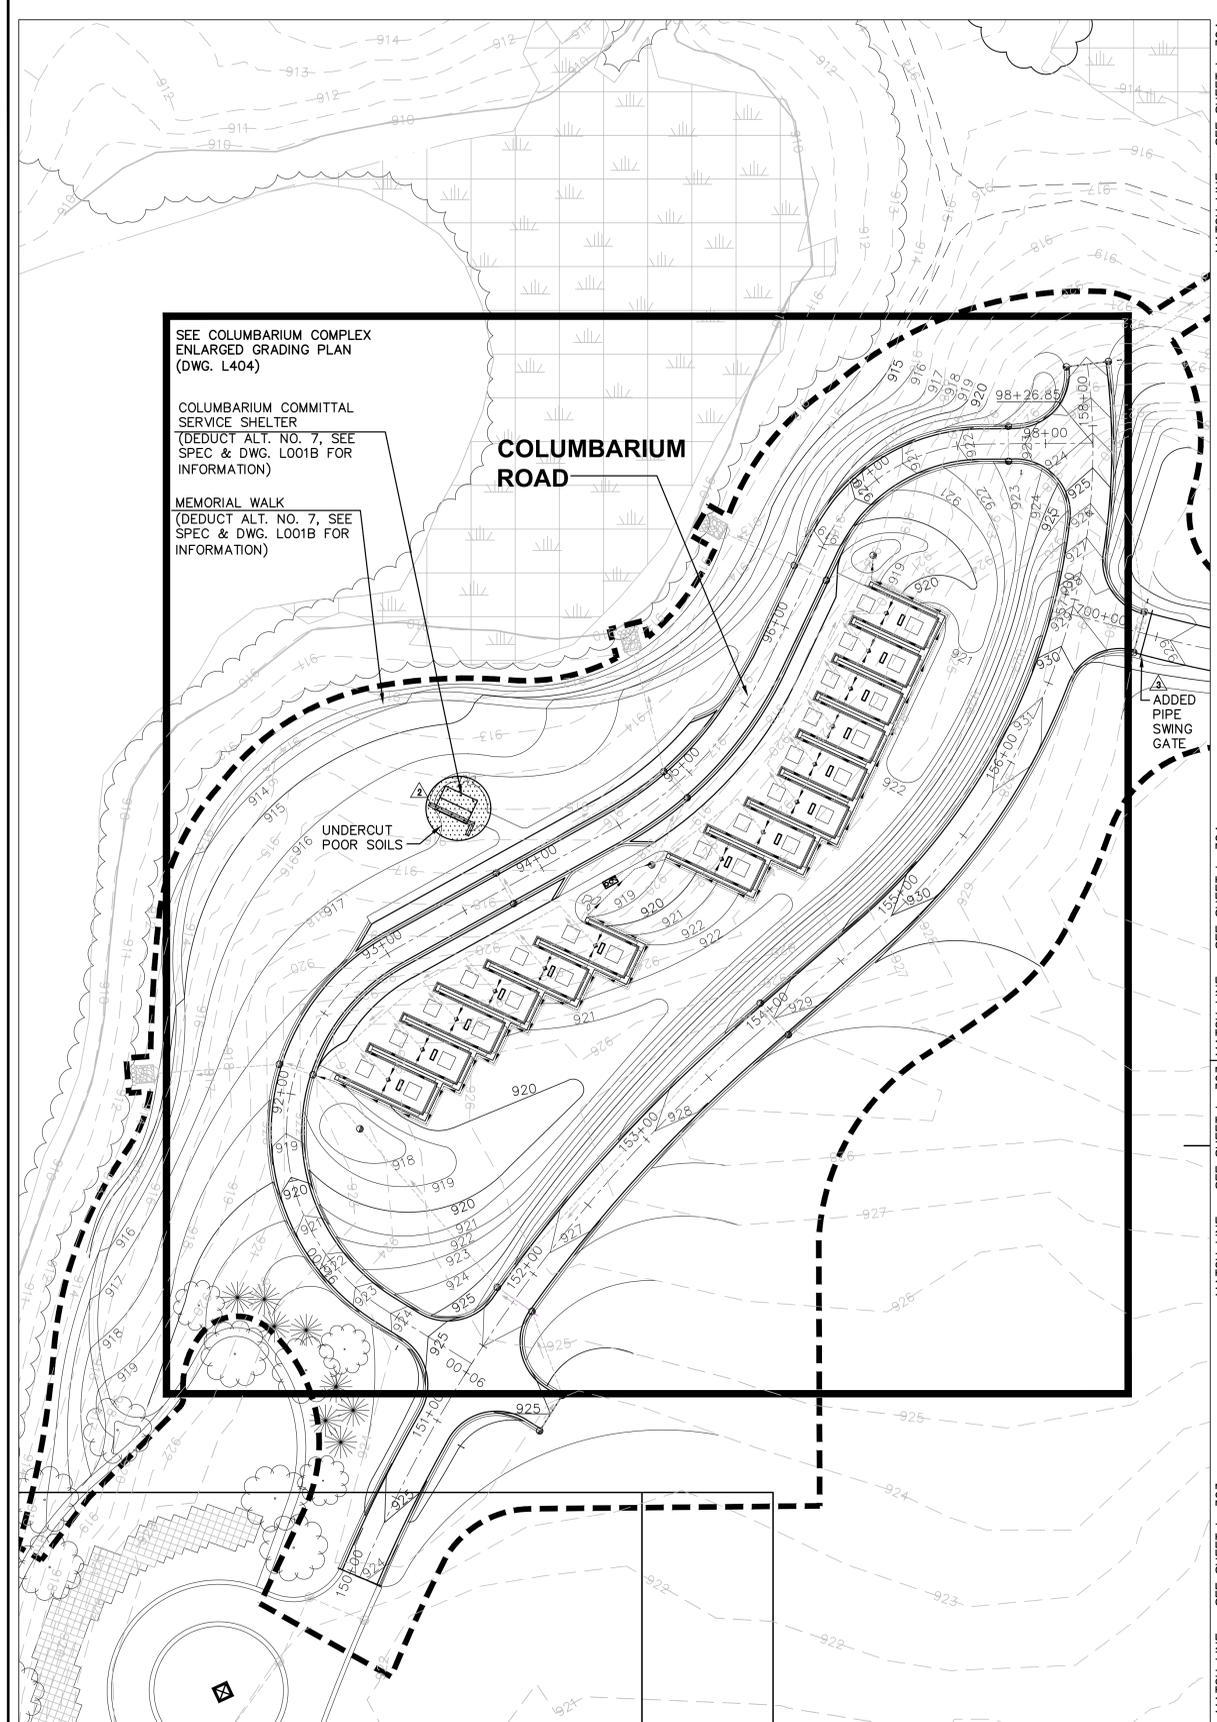

GRADING PLAN - AREA 5

RECORD DRAWINGS	07/08/2011
SA-063 Addition of Pipe Swing Gate	07/19/2010
SA-011 Columbarium Comm. Shelter - Undercutting	07/09/2009
SA-009 Address Poor Soils - Maint. Service Dr.	07/09/2009
Revisions:	Date

AS-BUILT NOTE:
 THE INFORMATION REPRESENTED ON THIS PLAN/DETAIL SHEET IS FROM CONTRACTORS, RESIDENT ENGINEERS AS-BUILT PROVIDED INFORMATION ALONG WITH COMPLETED INFORMATION FROM A/E SITE VISIT REPORTS, PHOTOGRAPHS AND INFORMATION AND IS NOT DEEMED TO BE ACCURATE NOR COMPLETE BUT AN ASSUMED CONSTRUCTED CONDITION AT THE SITE. SEE CONTRACTOR PROVIDED AS-BUILT DRAWINGS FOR ADDITIONAL INFORMATION.

CONSULTANTS:

the LA group
 Landscape Architecture and Engineering, P.C.
 40 Long Alley
 Saratoga Springs, NY 12866
 518/587-8100
 Telefax 518/587-0180

ARCHITECT/ENGINEERS:

URS
 SOUTHFIELD, MI. 48034
 27777 FRANKLIN RD., SUITE 2000
 PH. 248-204-5900
 TELEFAX 248-204-5901

GRADING PLAN AREAS 5, 6, & 7

Approved: David C. Starkie, Acting NCA Team Leader

Contracted By: Kevin W. Dix, NCA Project Manager

Project Title: GREAT LAKES NATIONAL CEMETERY PHASE 1B EXPANSION

Location: HOLLY, MICHIGAN

Date: FEB. 29, 2008

Checked: JGS/DLM

Drawn: TRL

Project Number: 923CM2003


Buidling Number:

Drawing Number: **L-305**


Dwg. 36 of 173

Office of Construction and Facilities Management



Department of Veterans Affairs

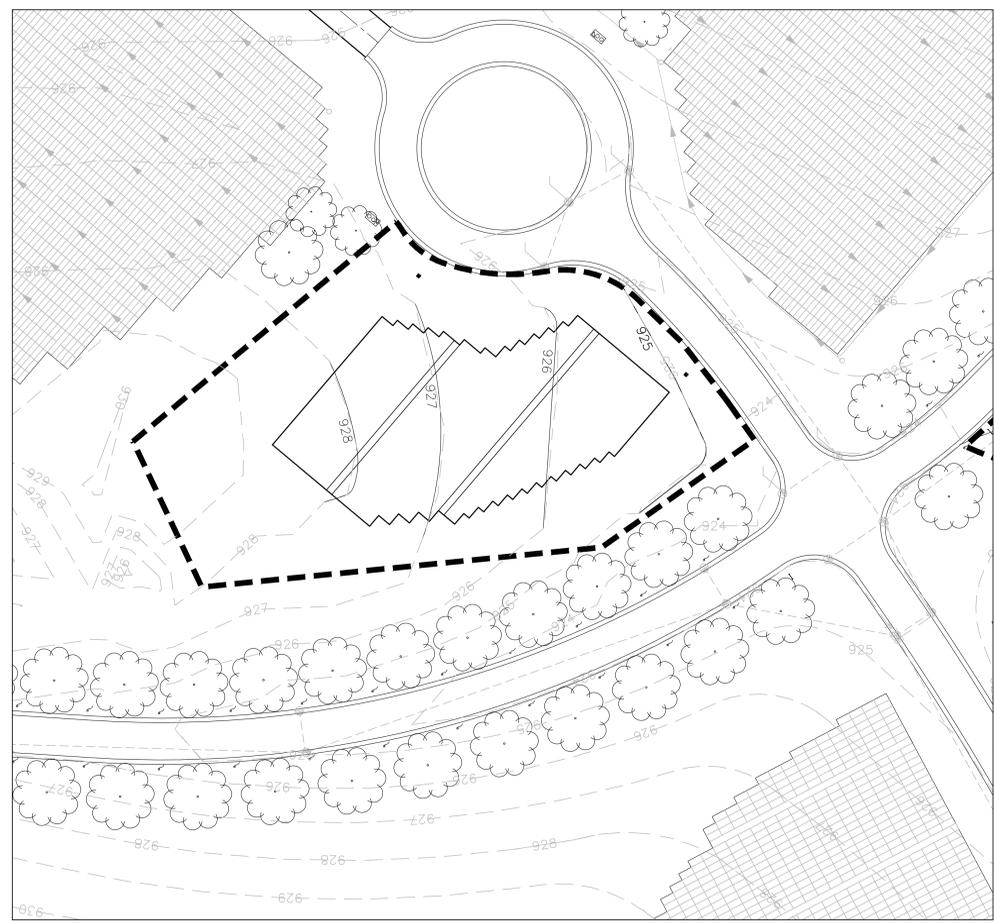

GRADING PLAN - AREA 6

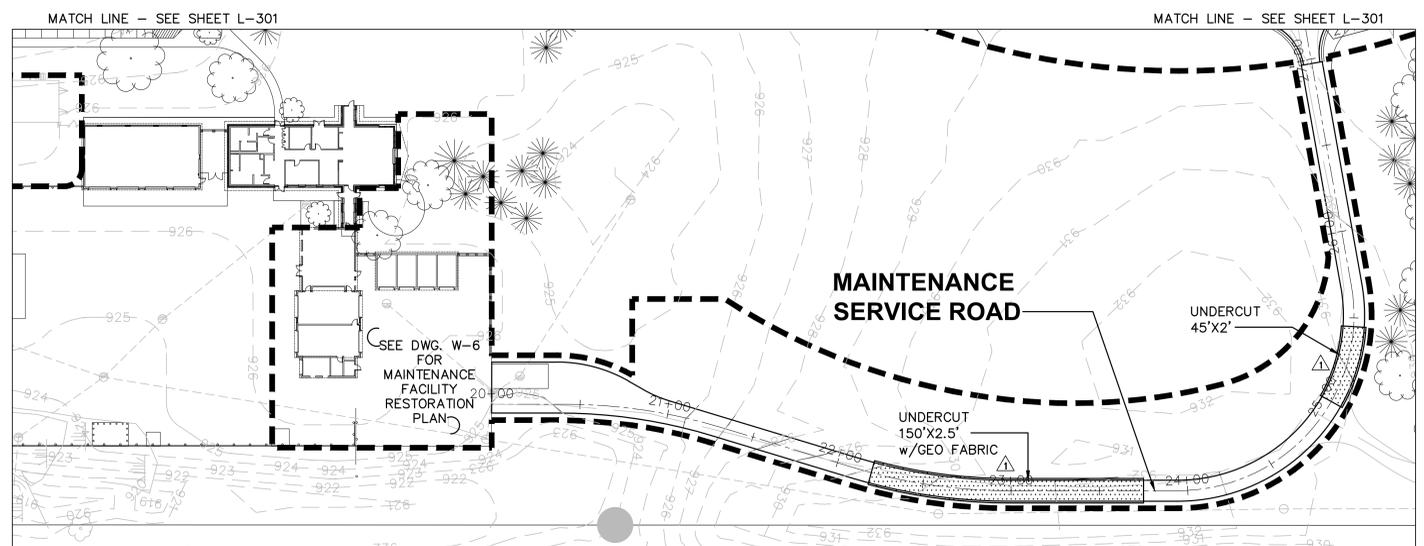

GRADING PLAN - AREA 7

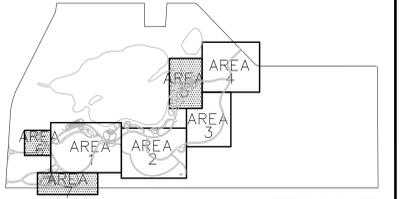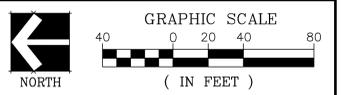

LEGEND:

--- 9.30	EXISTING CONTOUR
--- 1260	PROPOSED CONTOUR
--- (with symbol)	DRAINAGE STRUCTURE & PIPE (SEE NOTE BELOW)
--- (with symbol)	UNDERDRAIN PIPE
--- (dashed)	LIMIT OF CONSTRUCTION
+HP	HIGH POINT
+LP	LOW POINT
+1260.00	PROPOSED SPOT GRADE
(with symbol)	RIP-RAP
(with symbol)	SECTION MARKER
(with symbol)	FLOWER WATERING STATION

- NOTES:**
- SEE DWGS. L301A - L305A FOR STORM DRAINAGE INFORMATION.
 - RIPRAP AND GEOTEXTILE INSTALLATION SHALL BE PER OAKLAND COUNTY STANDARD DETAIL E-7 OR AS DIRECTED BY THE ENGINEER.
 - SEE DWG. L101 & L102 FOR EROSION CONTROL INFORMATION.
 - SEE DWG. L402 FOR PROJECT GRADING NOTES.
 - ANY FILL REQUIRED SHALL BE PROVIDED & OWNED BY THE CONTRACTOR.