



SHEET TITLE		REVISIONS:	
NO.	DATE	DESCRIPTION	
1	1/20/76	AS BUILT D.P. DATE	
MECHANICAL ROOM PLAN 8 SECTIONS			
BUDG NO	PROJECT TITLE	RBT	CHECKED
1	AMBULATORY CARE ADDITION TO BUILDING N81		
DRAWN	DATE	RHS	DATE
	5/14/76		
The Drake Partnership Architects		DRAWING NUMBER	
10425 Old Orchard Road St. Louis, MO 63141		DWG NO. OF TO	
Comm. No. 7556		PROJECT NUMBER	
APPROVED: PROJECT DIRECTOR		657-020	
VETERANS ADMINISTRATION			


1-7-1-1031

SEE SHEET J-H7  
FOR GENERAL  
NOTES


LOCATION		ONE EIGHTY INCH EQUALS ONE FOOT		ONE QUARTER INCH EQUALS ONE FOOT		ONE HALF INCH EQUALS ONE FOOT		THREE EIGHTH INCH EQUALS ONE FOOT		ONE INCH EQUALS ONE FOOT	
VAH, ST. LOUIS (JCD), MISSOURI		0 1 2 3 4 5 6 7 8 9 10 11 12 13 14 15 16	0 1 2 3 4 5 6 7 8 9 10 11 12 13 14 15 16	0 1 2 3 4 5 6 7 8 9 10 11 12 13 14 15 16	0 1 2 3 4 5 6 7 8 9 10 11 12 13 14 15 16	0 1 2 3 4 5 6 7 8 9 10 11 12 13 14 15 16	0 1 2 3 4 5 6 7 8 9 10 11 12 13 14 15 16	0 1 2 3 4 5 6 7 8 9 10 11 12 13 14 15 16	0 1 2 3 4 5 6 7 8 9 10 11 12 13 14 15 16	0 1 2 3 4 5 6 7 8 9 10 11 12 13 14 15 16	0 1 2 3 4 5 6 7 8 9 10 11 12 13 14 15 16

RETURN TO PLAN LIBRARY


FILE FOLDER NO. 20

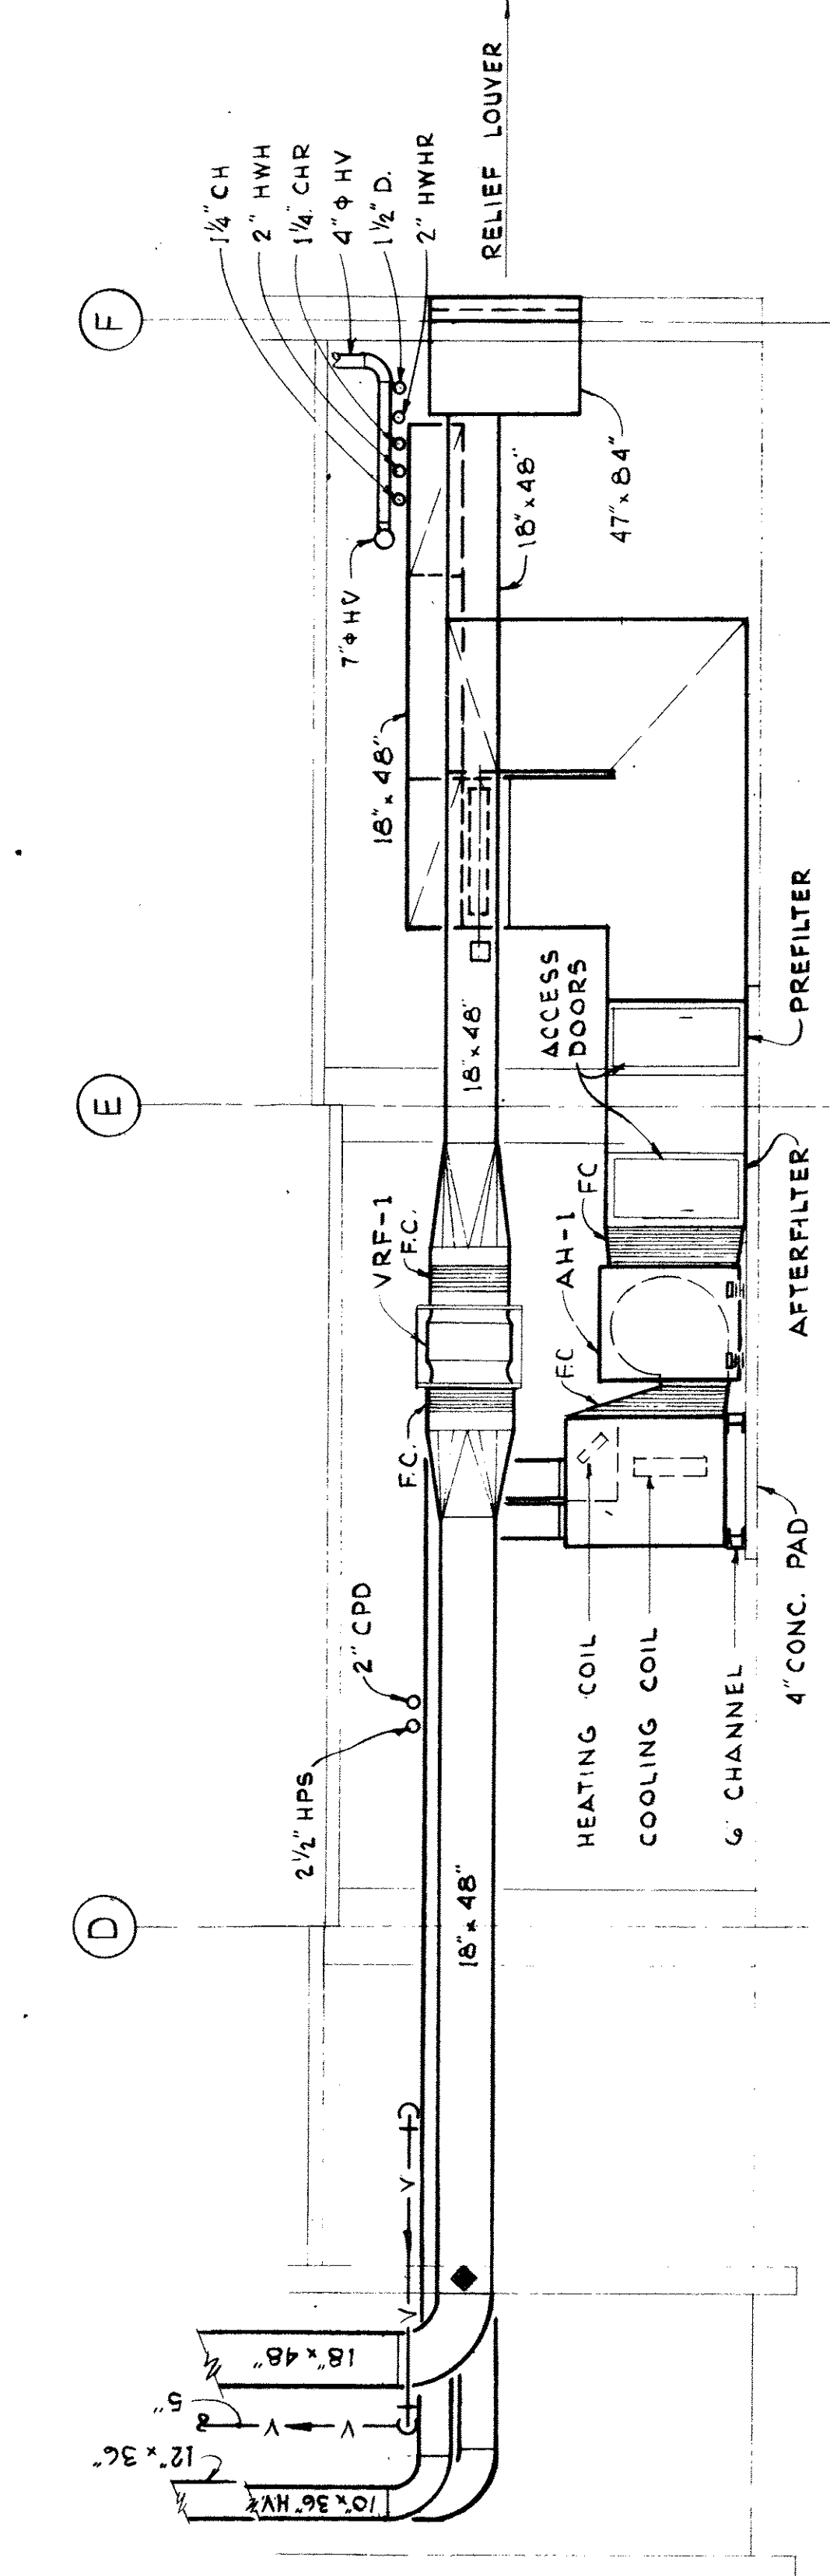


SECTION A-A  
SCALE 1/4"=1'-0"

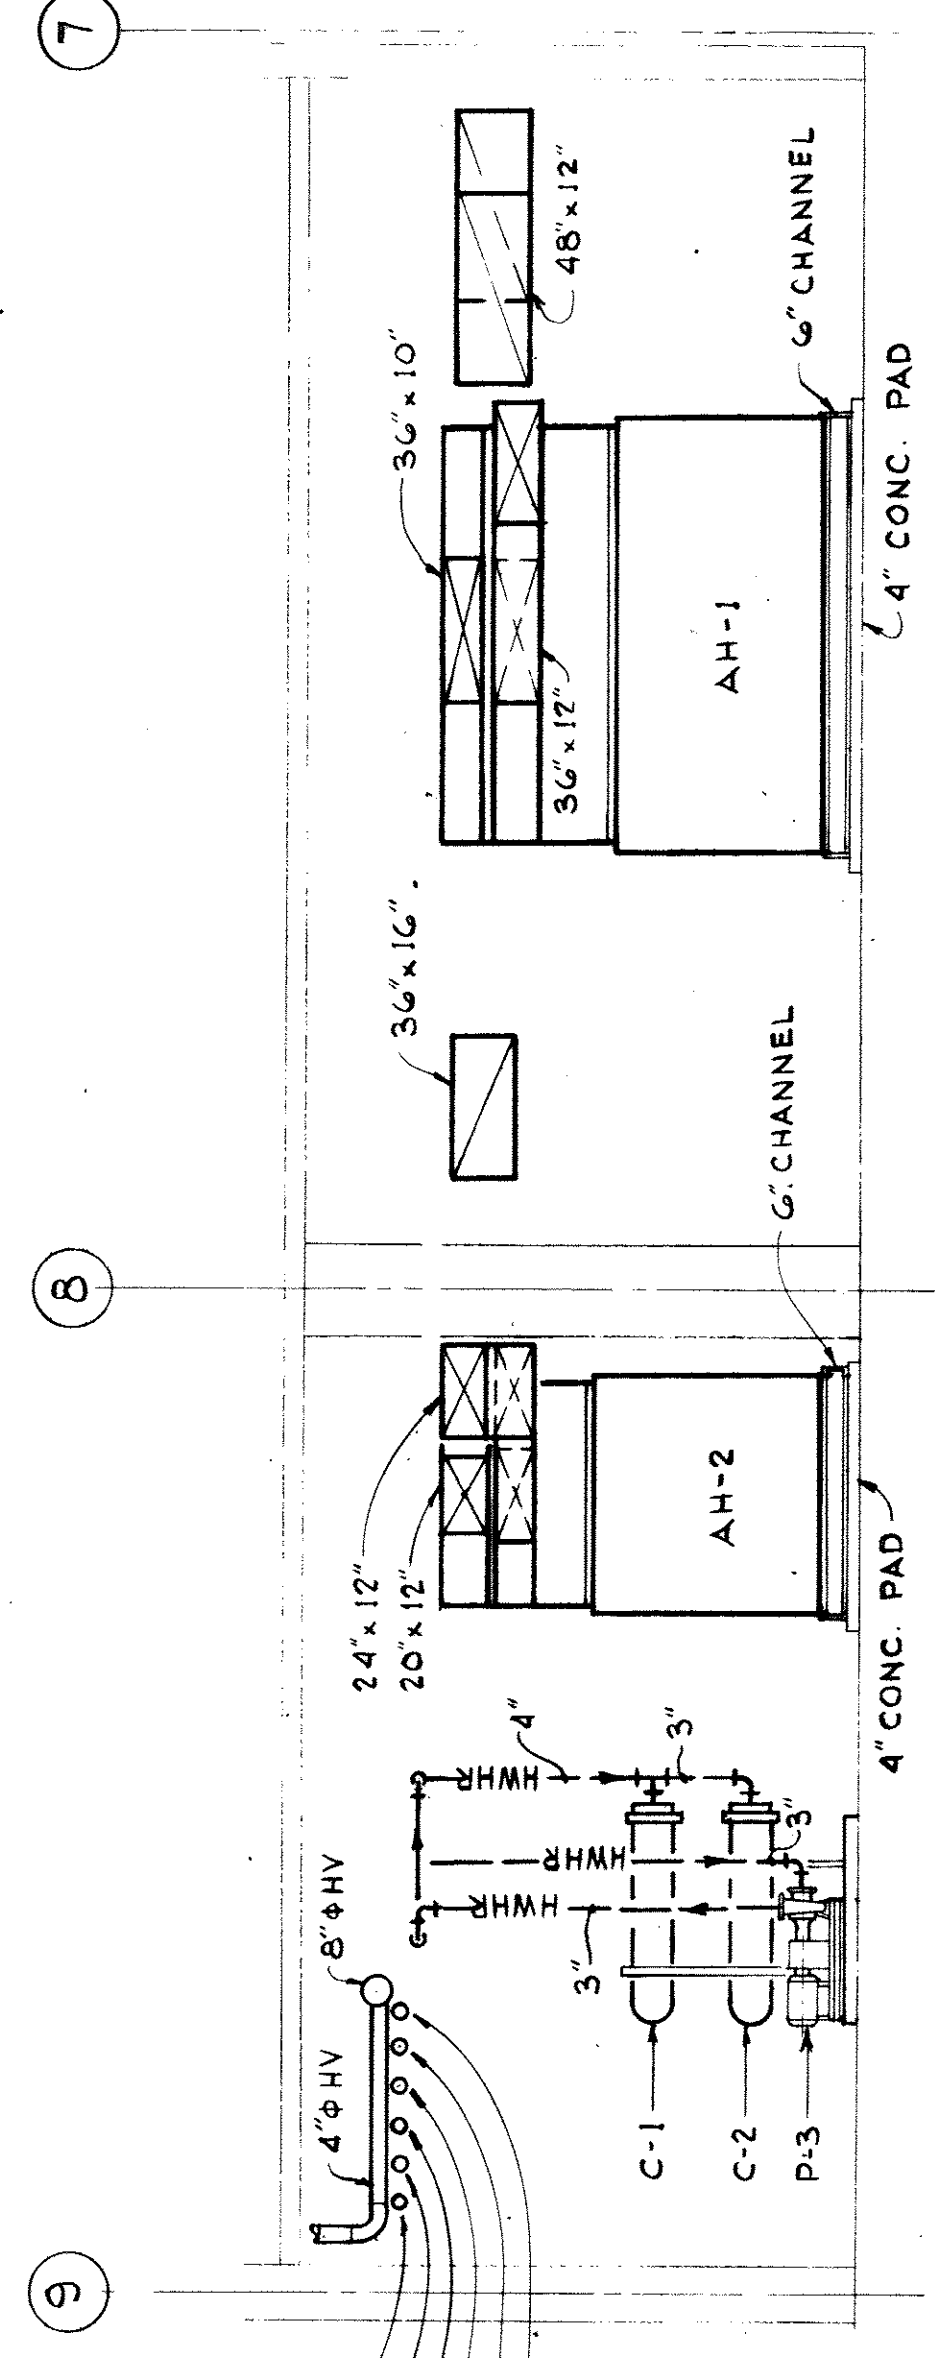

SECTION B-B  
SCALE 1/4"=1'-0"

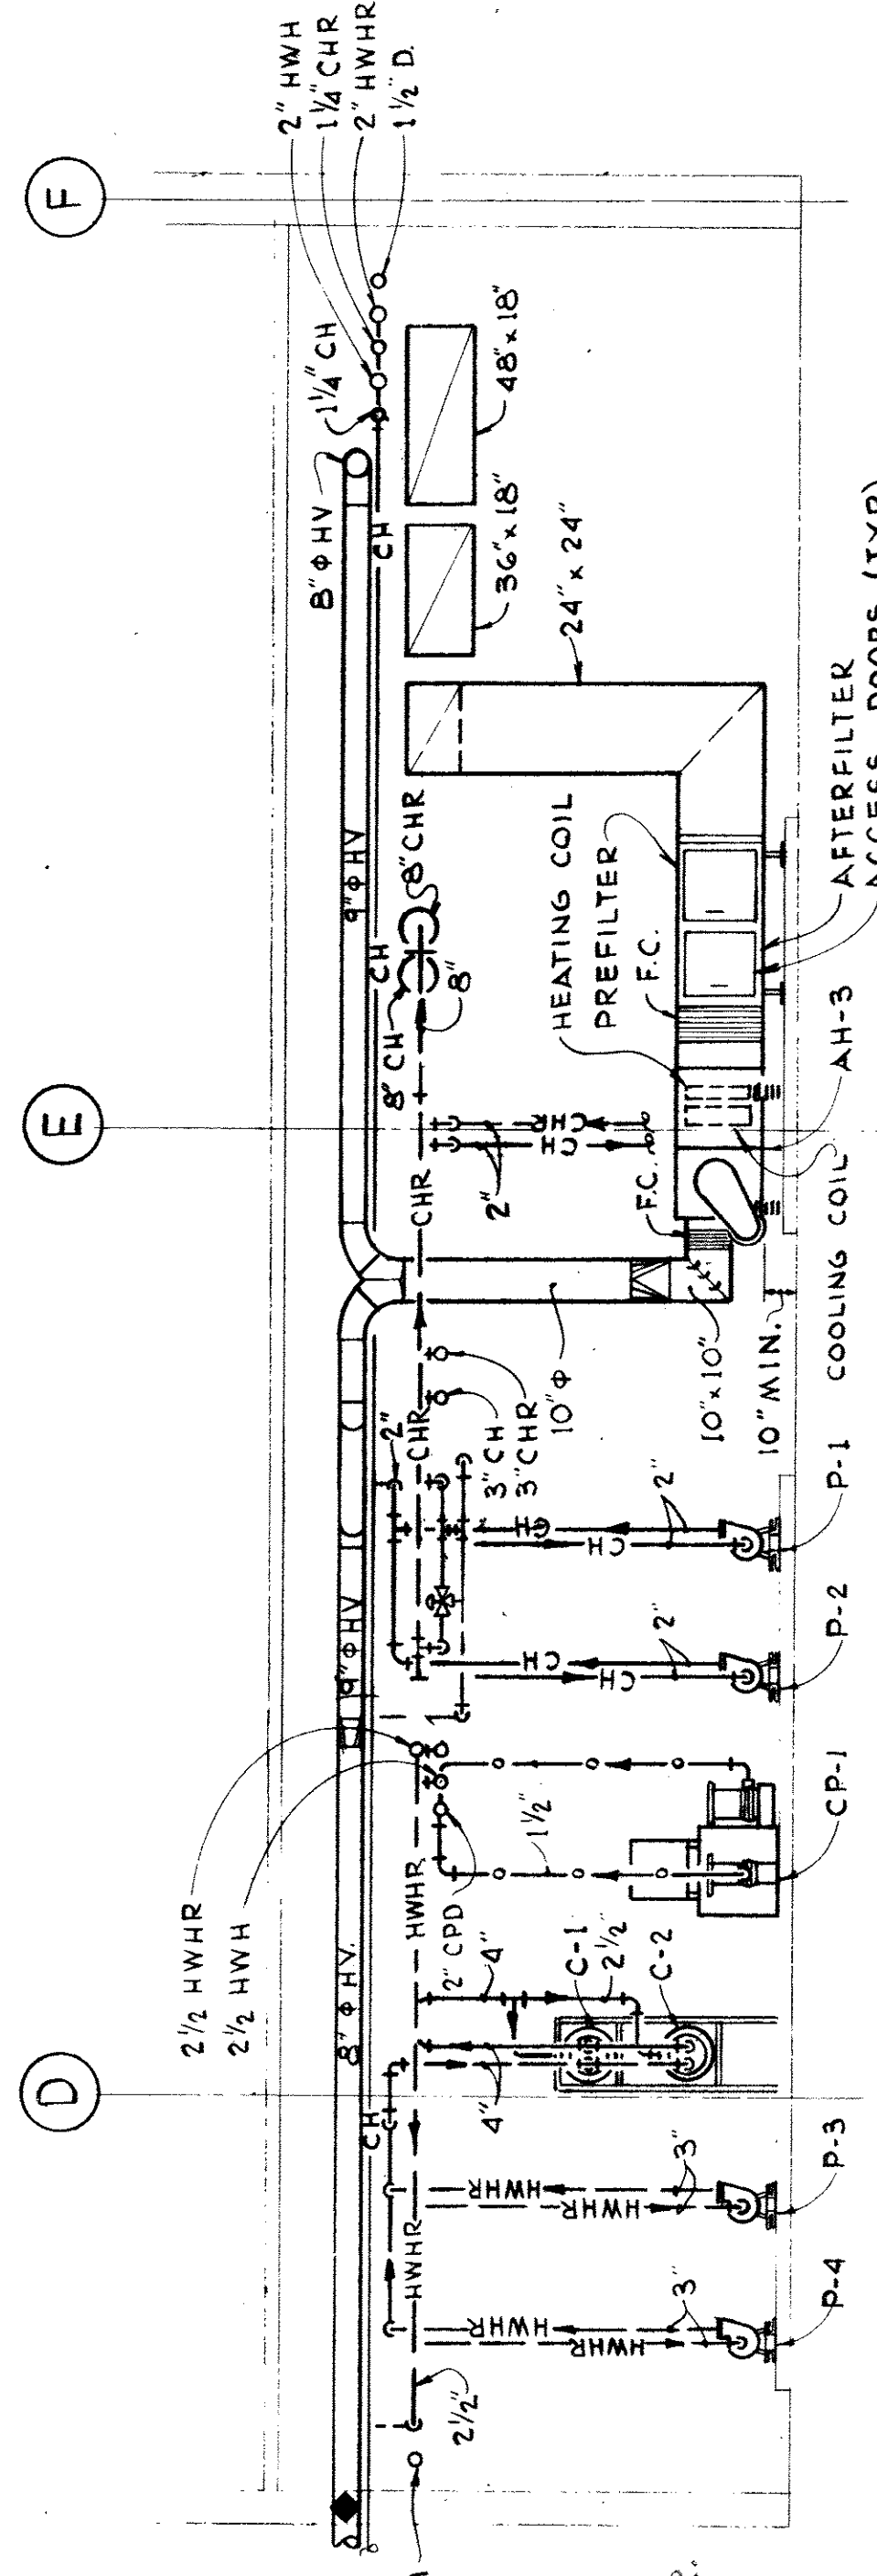

SECTION C-C  
SCALE 1/4"=1'-0"

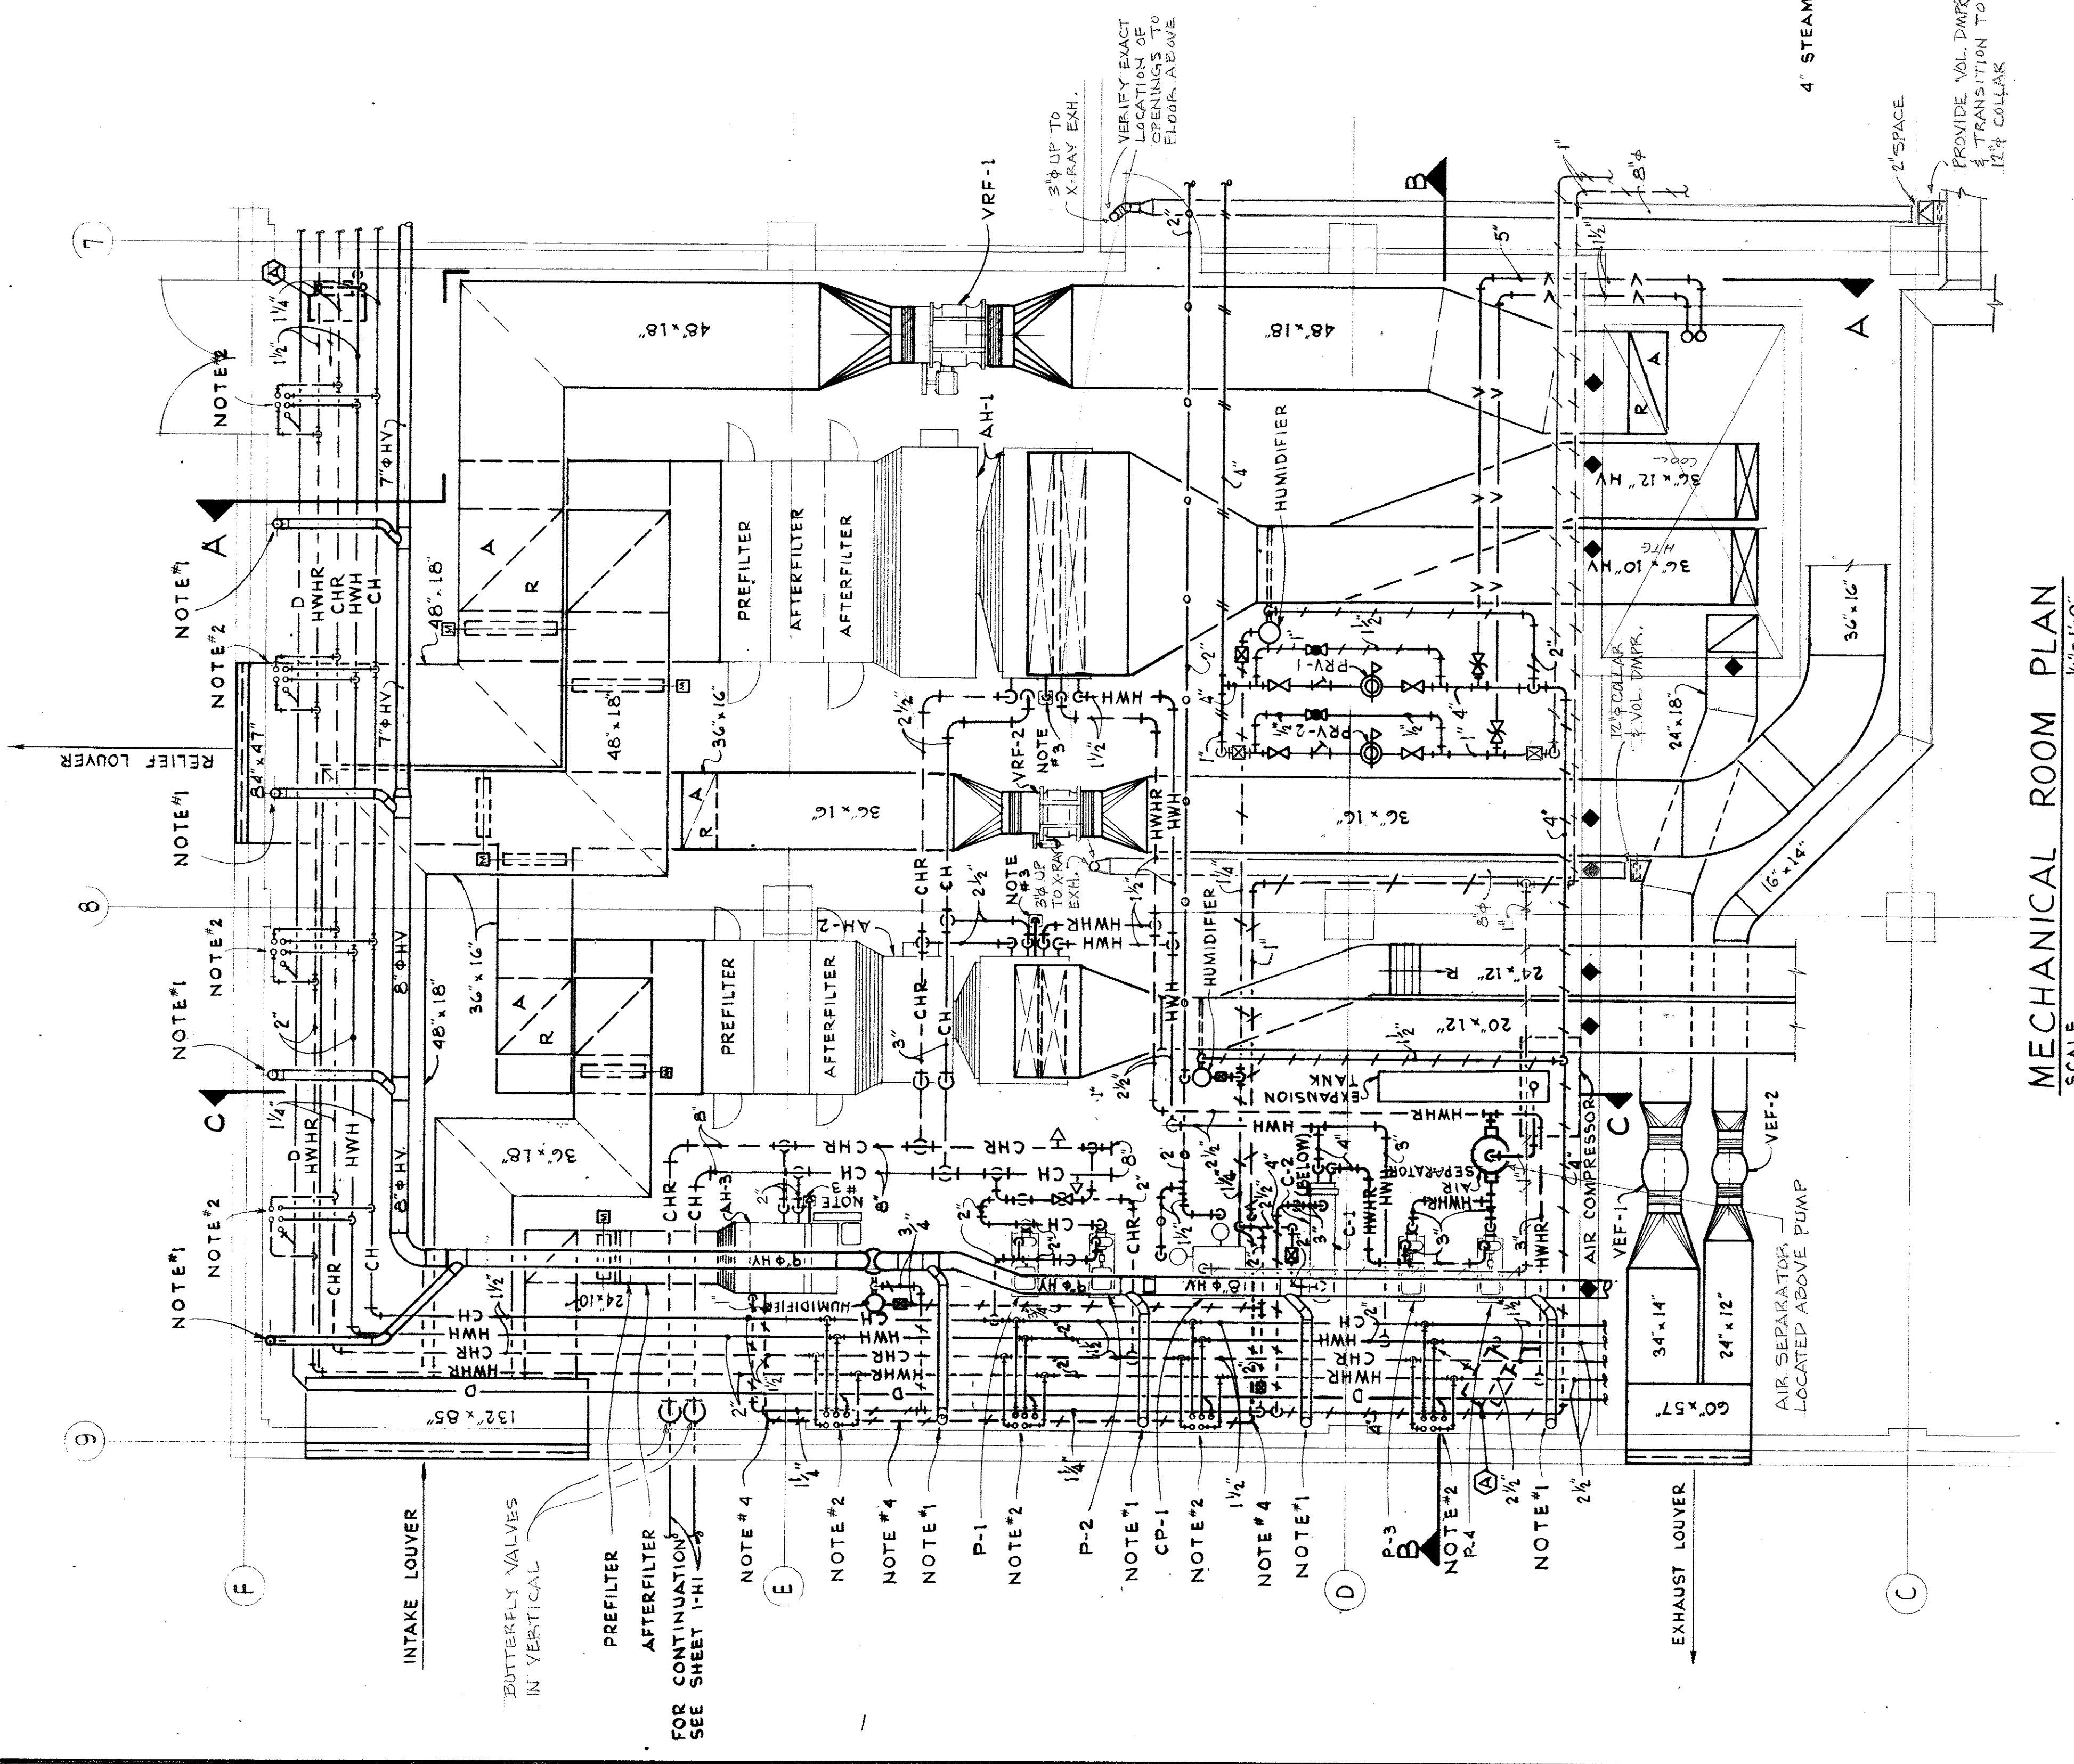

MECHANICAL ROOM PLAN  
SCALE 1/4"=1'-0"

- NOTES: (THIS SHEET ONLY)
- 1- 4" H.V. UP TO INDUCTION UNIT ABOVE
  - 2- HOT WATER, CHILLED WATER, & DRAIN PIPING UP TO INDUCTION UNIT ABOVE. SEE FLOW DIAGRAM FOR SIZES.
  - 3- 1/2" DRAIN LINE FROM UNIT TO FLOOR DRAIN.
  - 4- 1" MEDIUM PRESSURE RETURN LINE FROM STEAM HEATING COIL IN AH-3. RUN LINE LOW ALONG MECH. ROOM WALL.