

AS BUILT

ORIENTATION **APPROVED FOR CONSTRUCTION**


Approved By: *[Signature]*


Date Approved: 3-3-06

NOTE:

SEE DETAILS ON SHEET "IN1".

ORIGINAL

| Rev. | Rev. By | Rev. Date | Description |
|--|---------|---------------------|---|
| 1 | JB | 02/24/06 | REVISED PIPE DETAILS |
| THIS DRAWING IS THE PROPERTY OF PITTSBURG TANK & TOWER CO. INC. NEITHER THIS DRAWING NOR ANY DATA OR INFORMATION HEREIN MAY BE COPIED, REPRODUCED, OR USED FOR ANY PURPOSE WHATSOEVER, WITHOUT THE PRIOR WRITTEN PERMISSION FROM PITTSBURG TANK & TOWER CO. INC. | | | |
| PITTSBURG TANK & TOWER CO. ELEVATED TANK DIVISION, INC. P.O. Box 40 1329 Hwy. 41 North Sebree, KY. 42455 PH. 270-835-2600 FAX 270-835-9732 | | |  SINCE 1919 www.watertank.com |
| 12"Ø INLET PIPE ELEVATION | | | |
| 500,000 GALLON WATERSPHERE | | | |
| V A MEDICAL CENTER WEST PALM BEACH, FL | | | |
| Drawn By <i>Jeremy Binkley</i> | | Date: Nov. 15, 2005 | Job No.: 5977 |

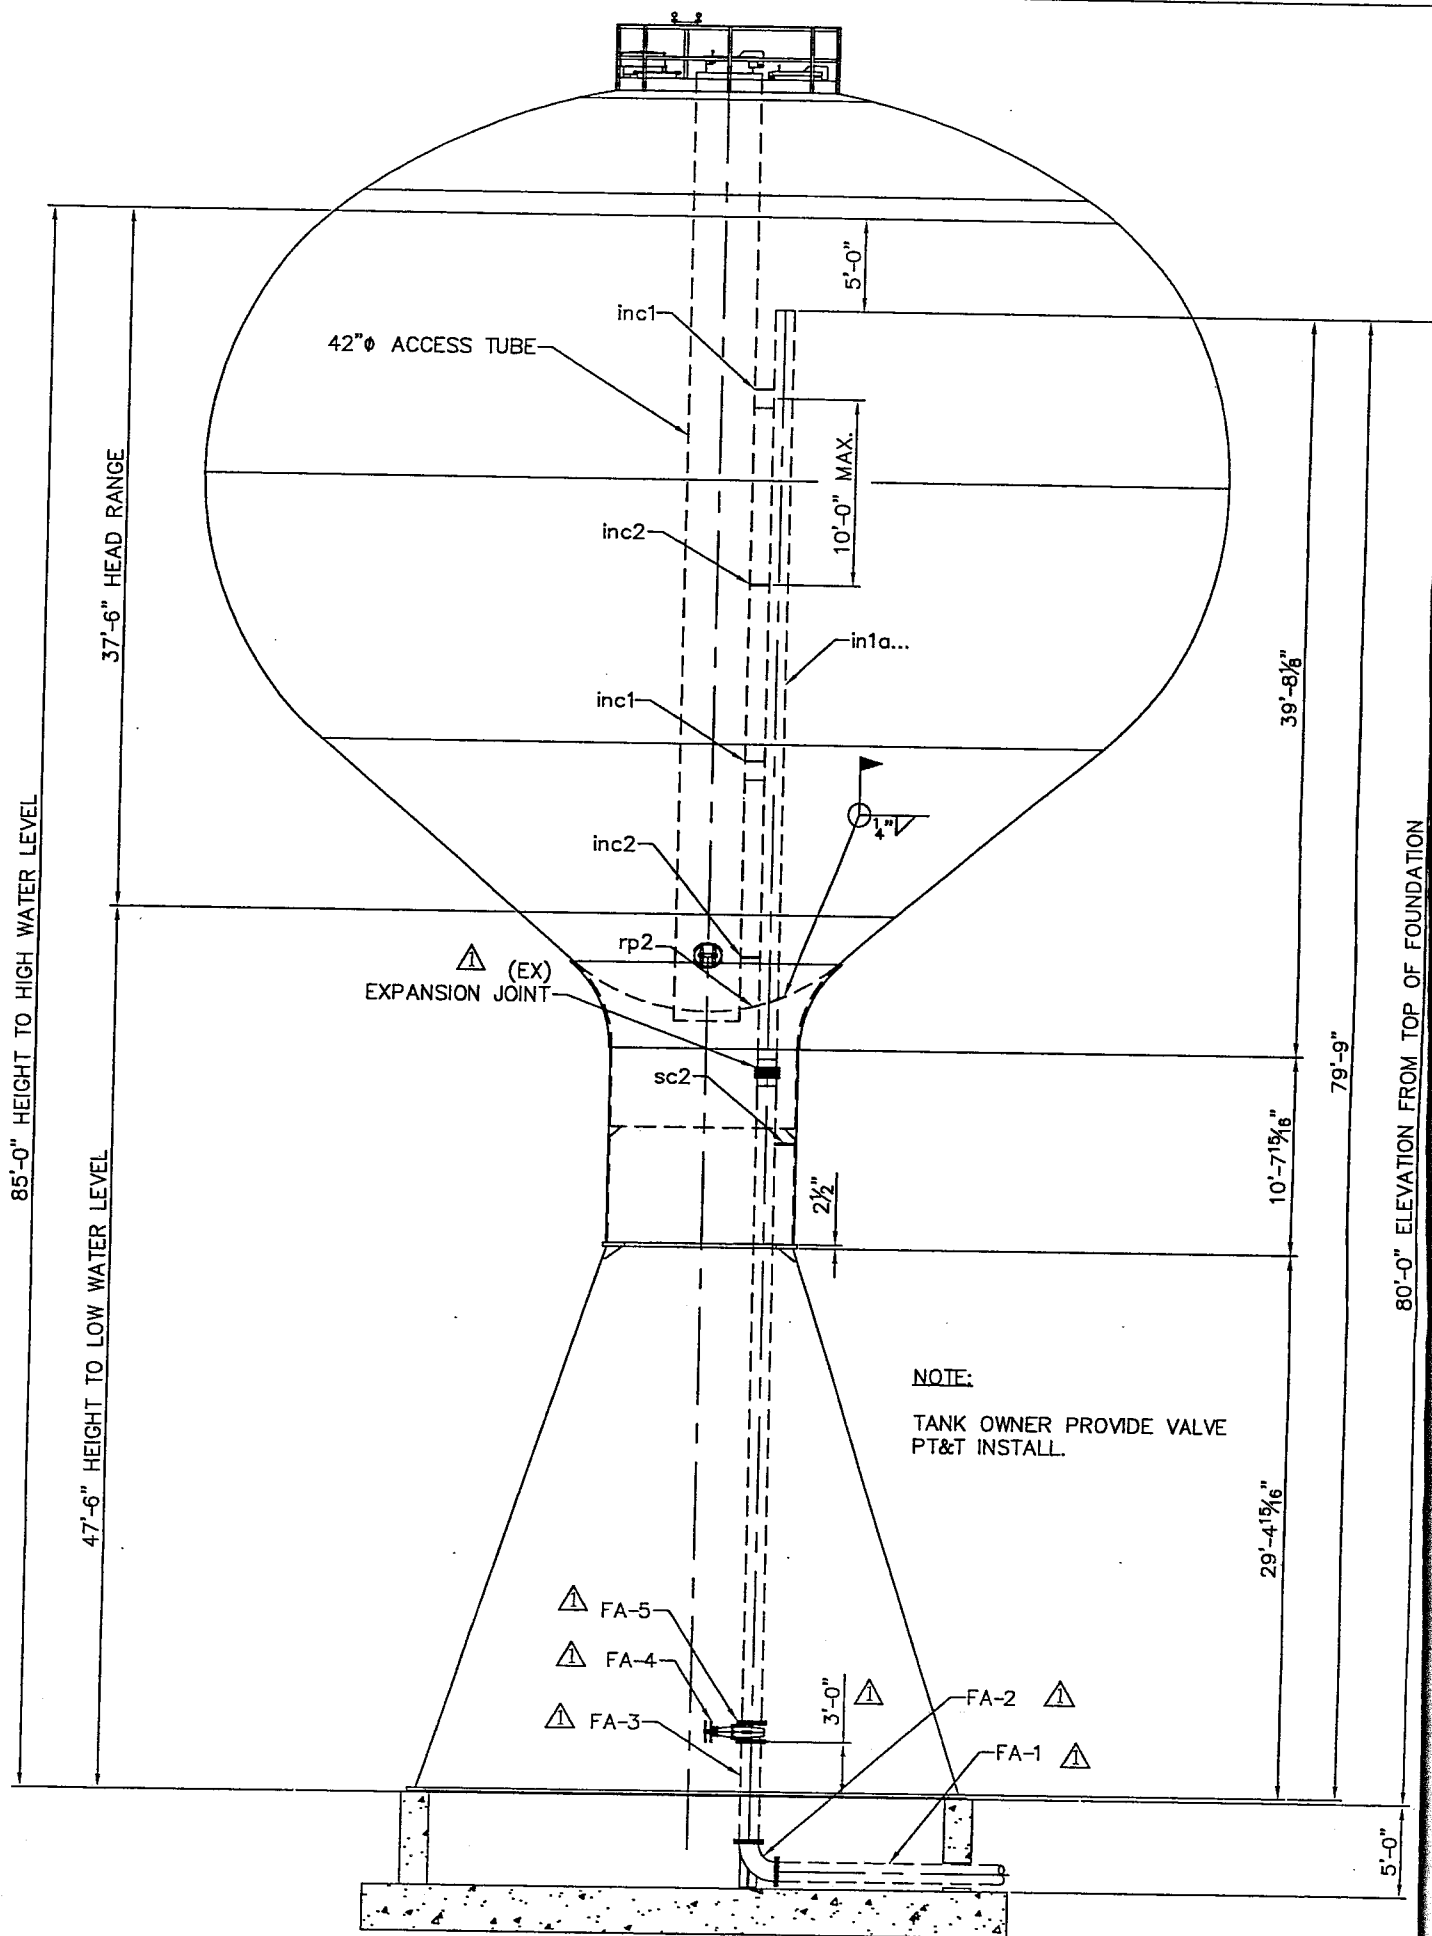

12" ϕ INLET ELEVATION