




A BUILDING SECTION
CC-ELEV 1/4"=1'-0"

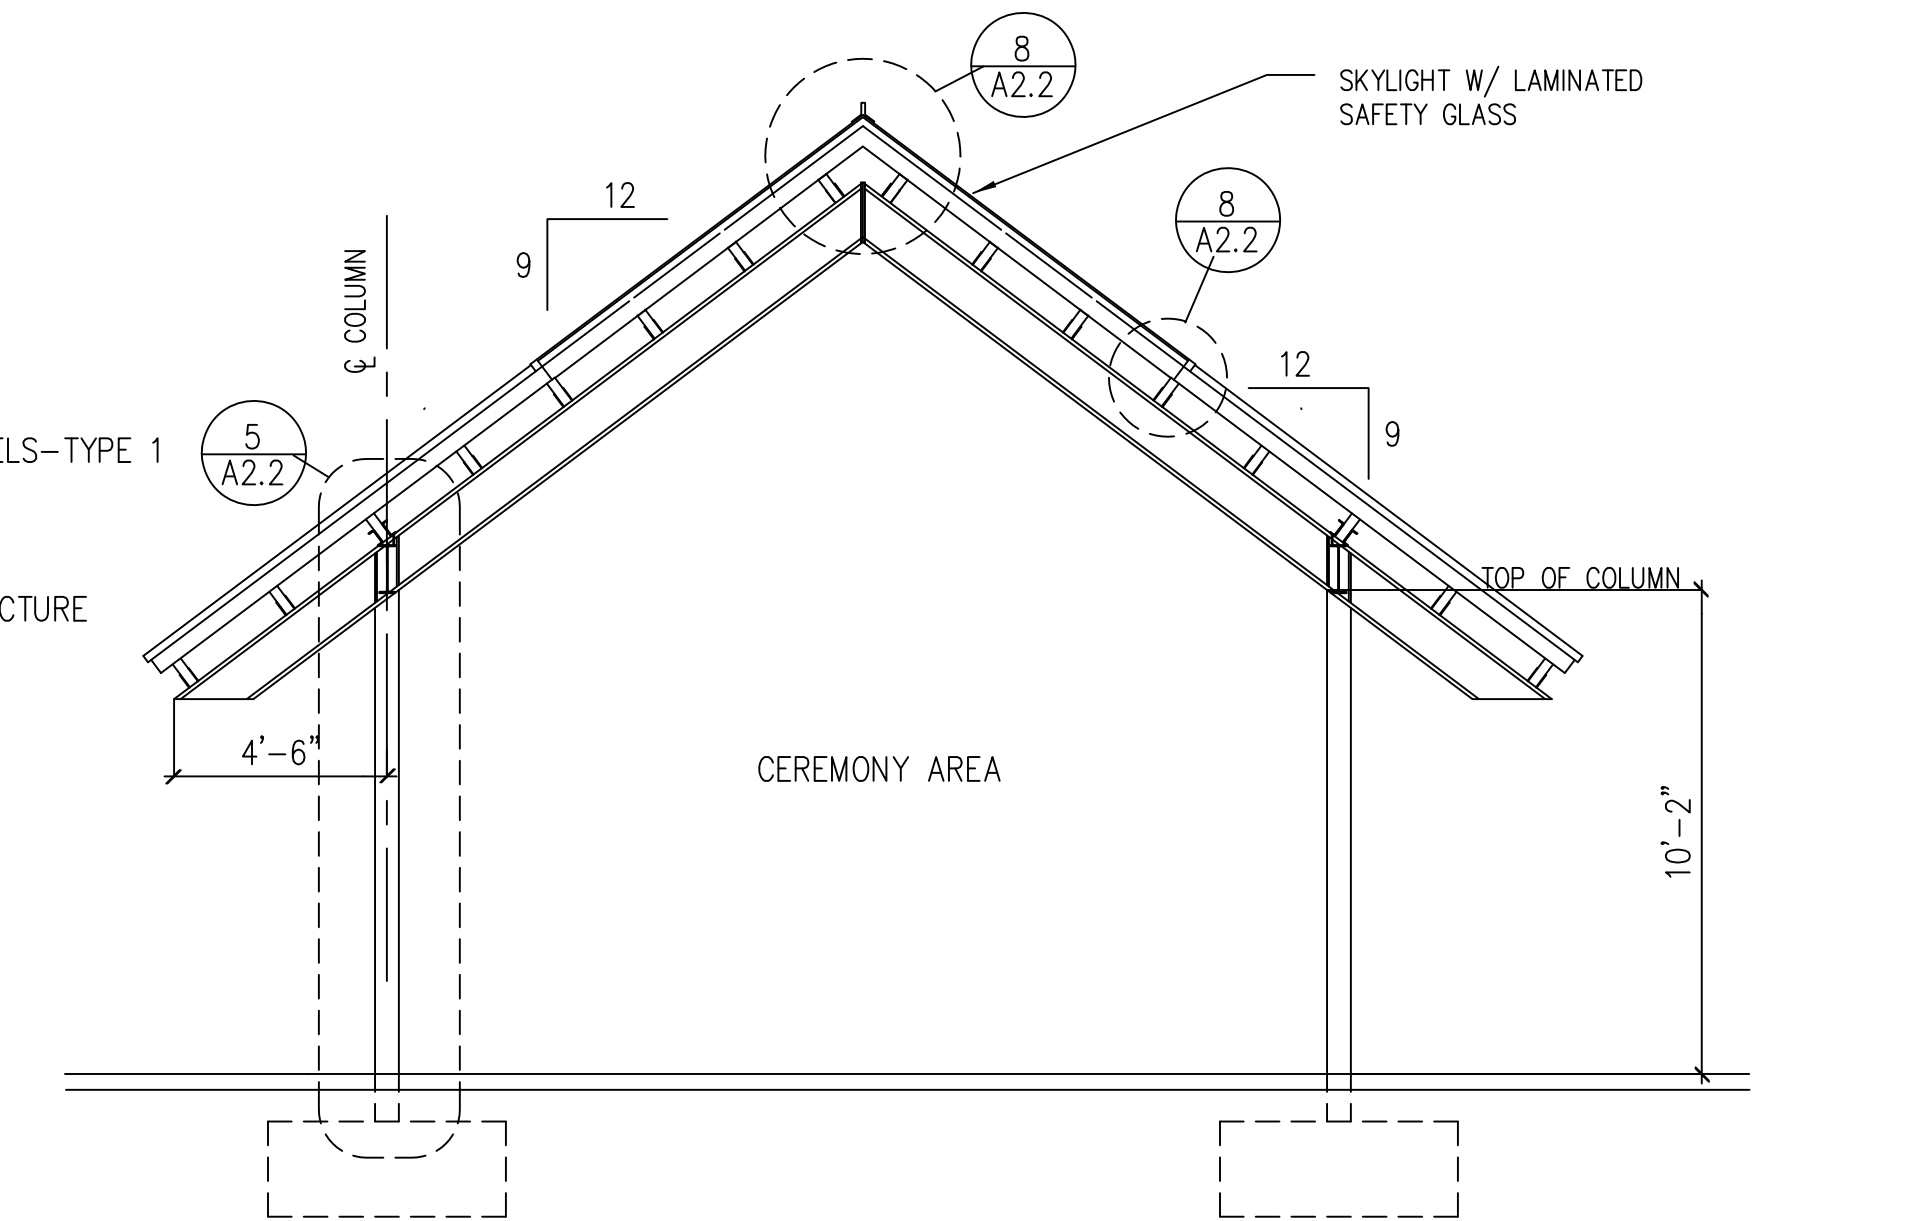


B BUILDING SECTION
CC-ELEV 1/4"=1'-0"

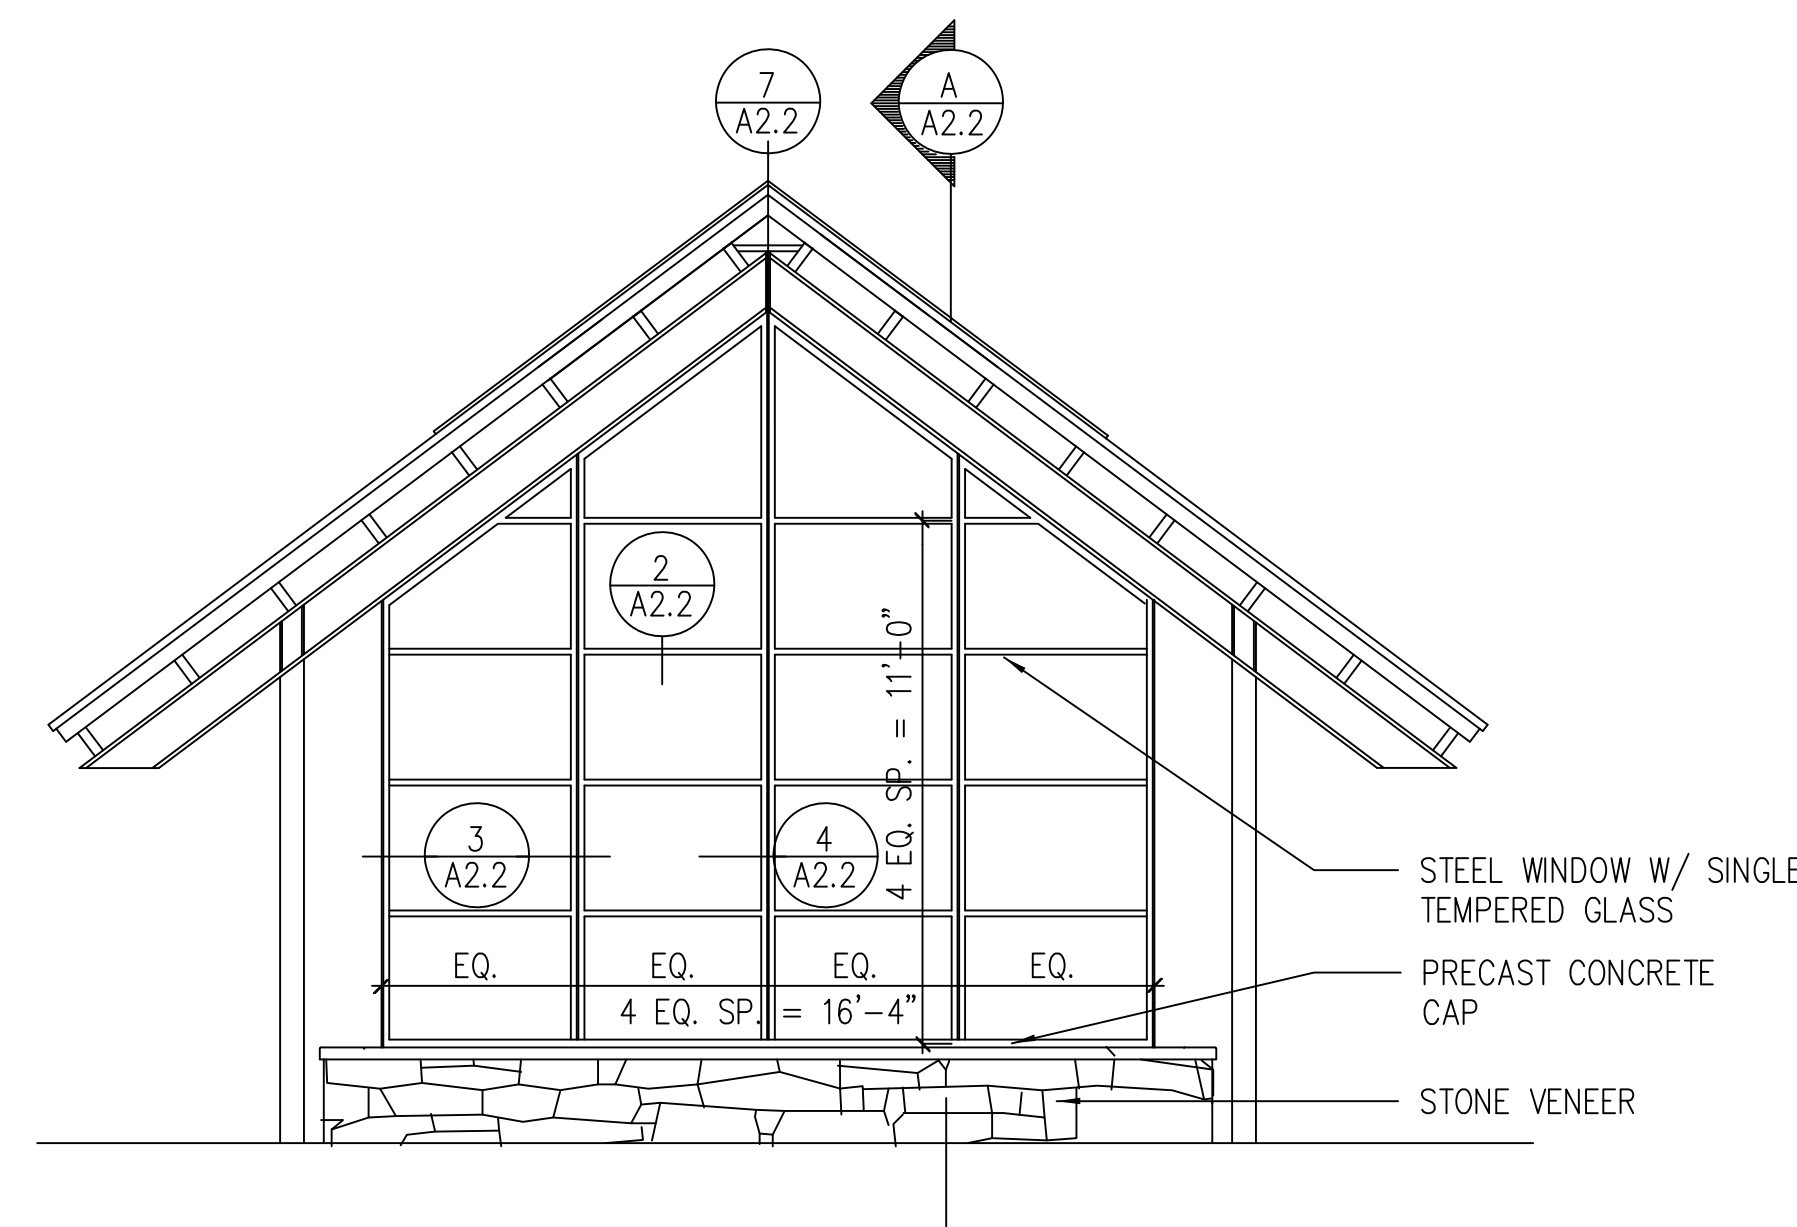


SOUTH ELEVATION
CC-ELEV 1/4"=1'-0"

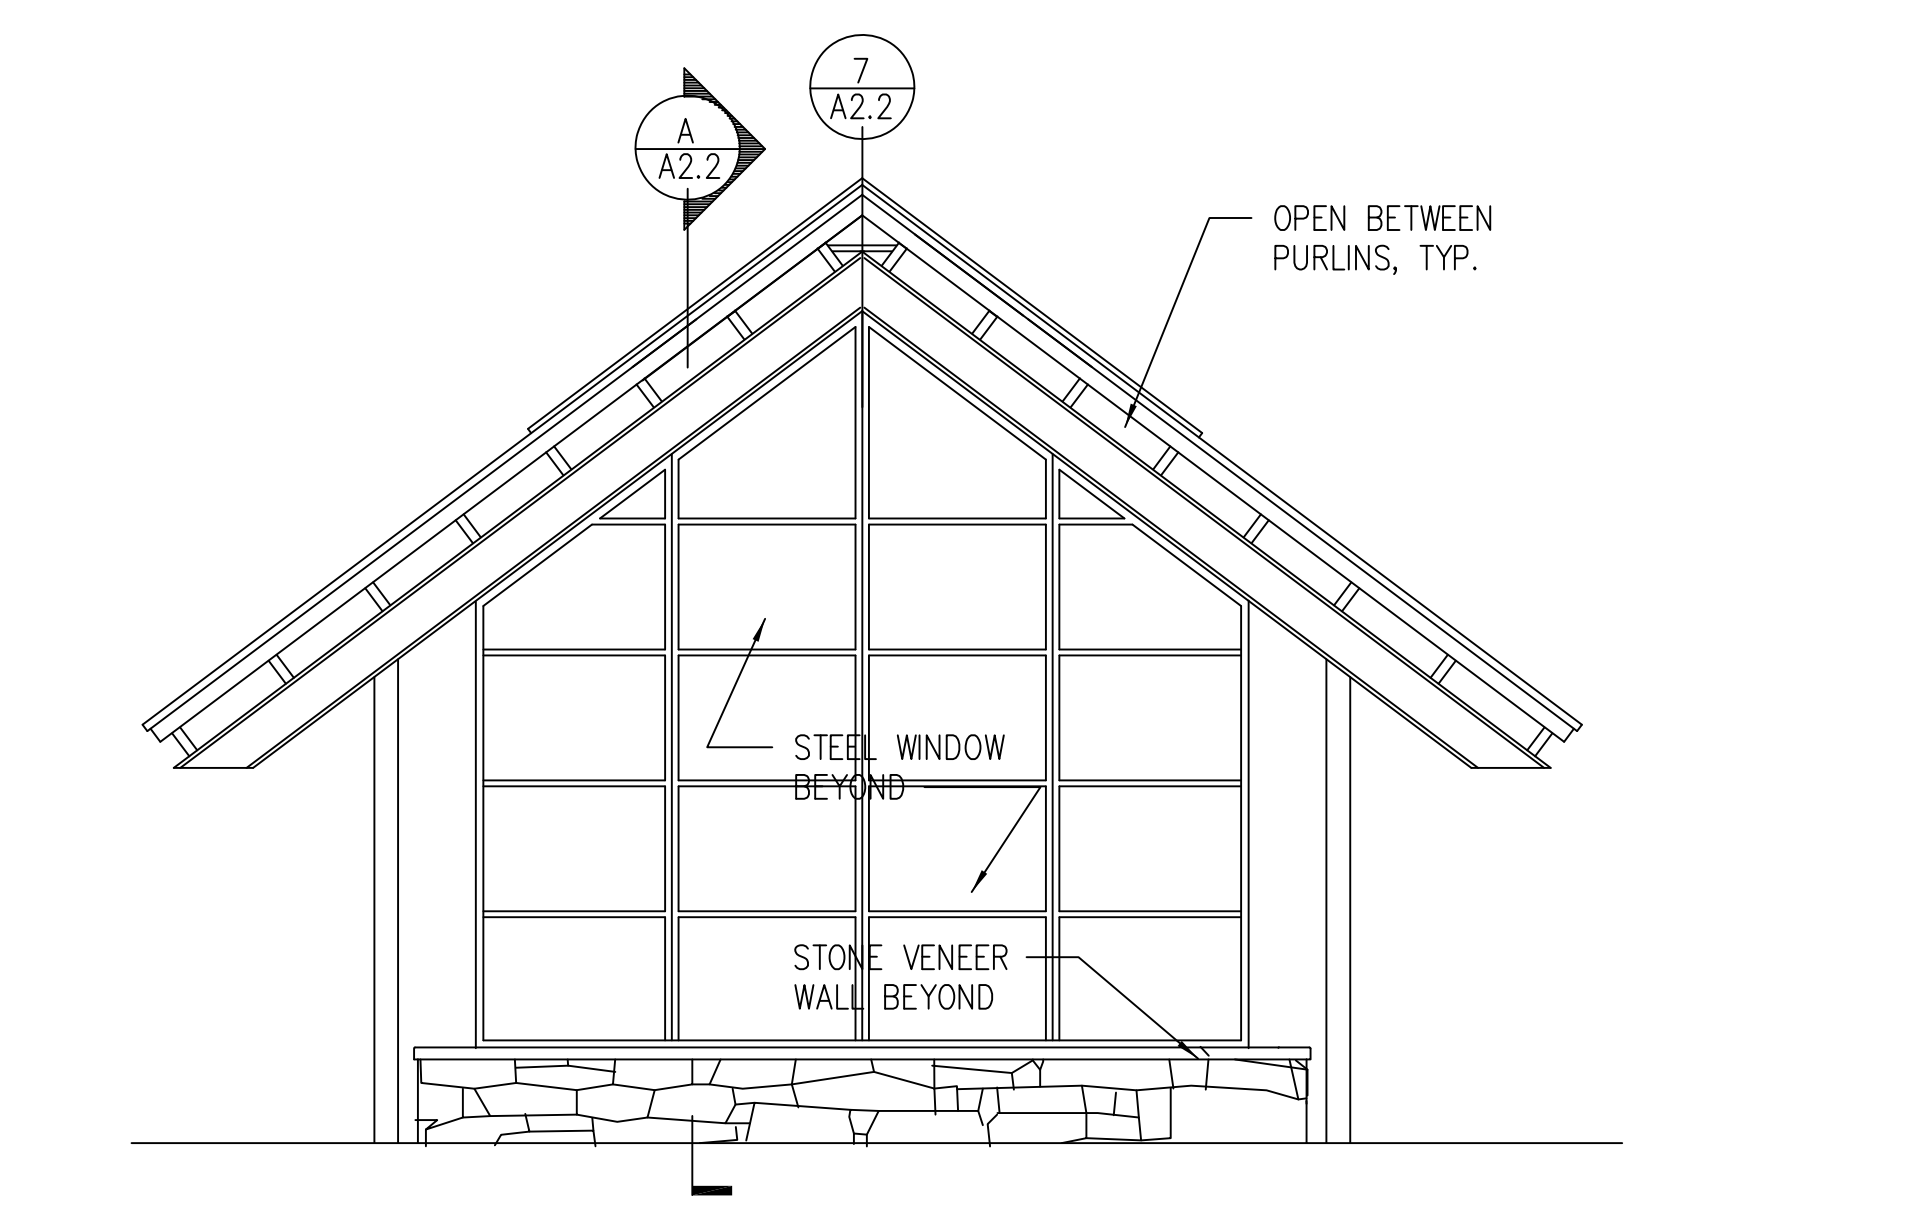

NORTH ELEVATION
CC-ELEV 1/4"=1'-0"

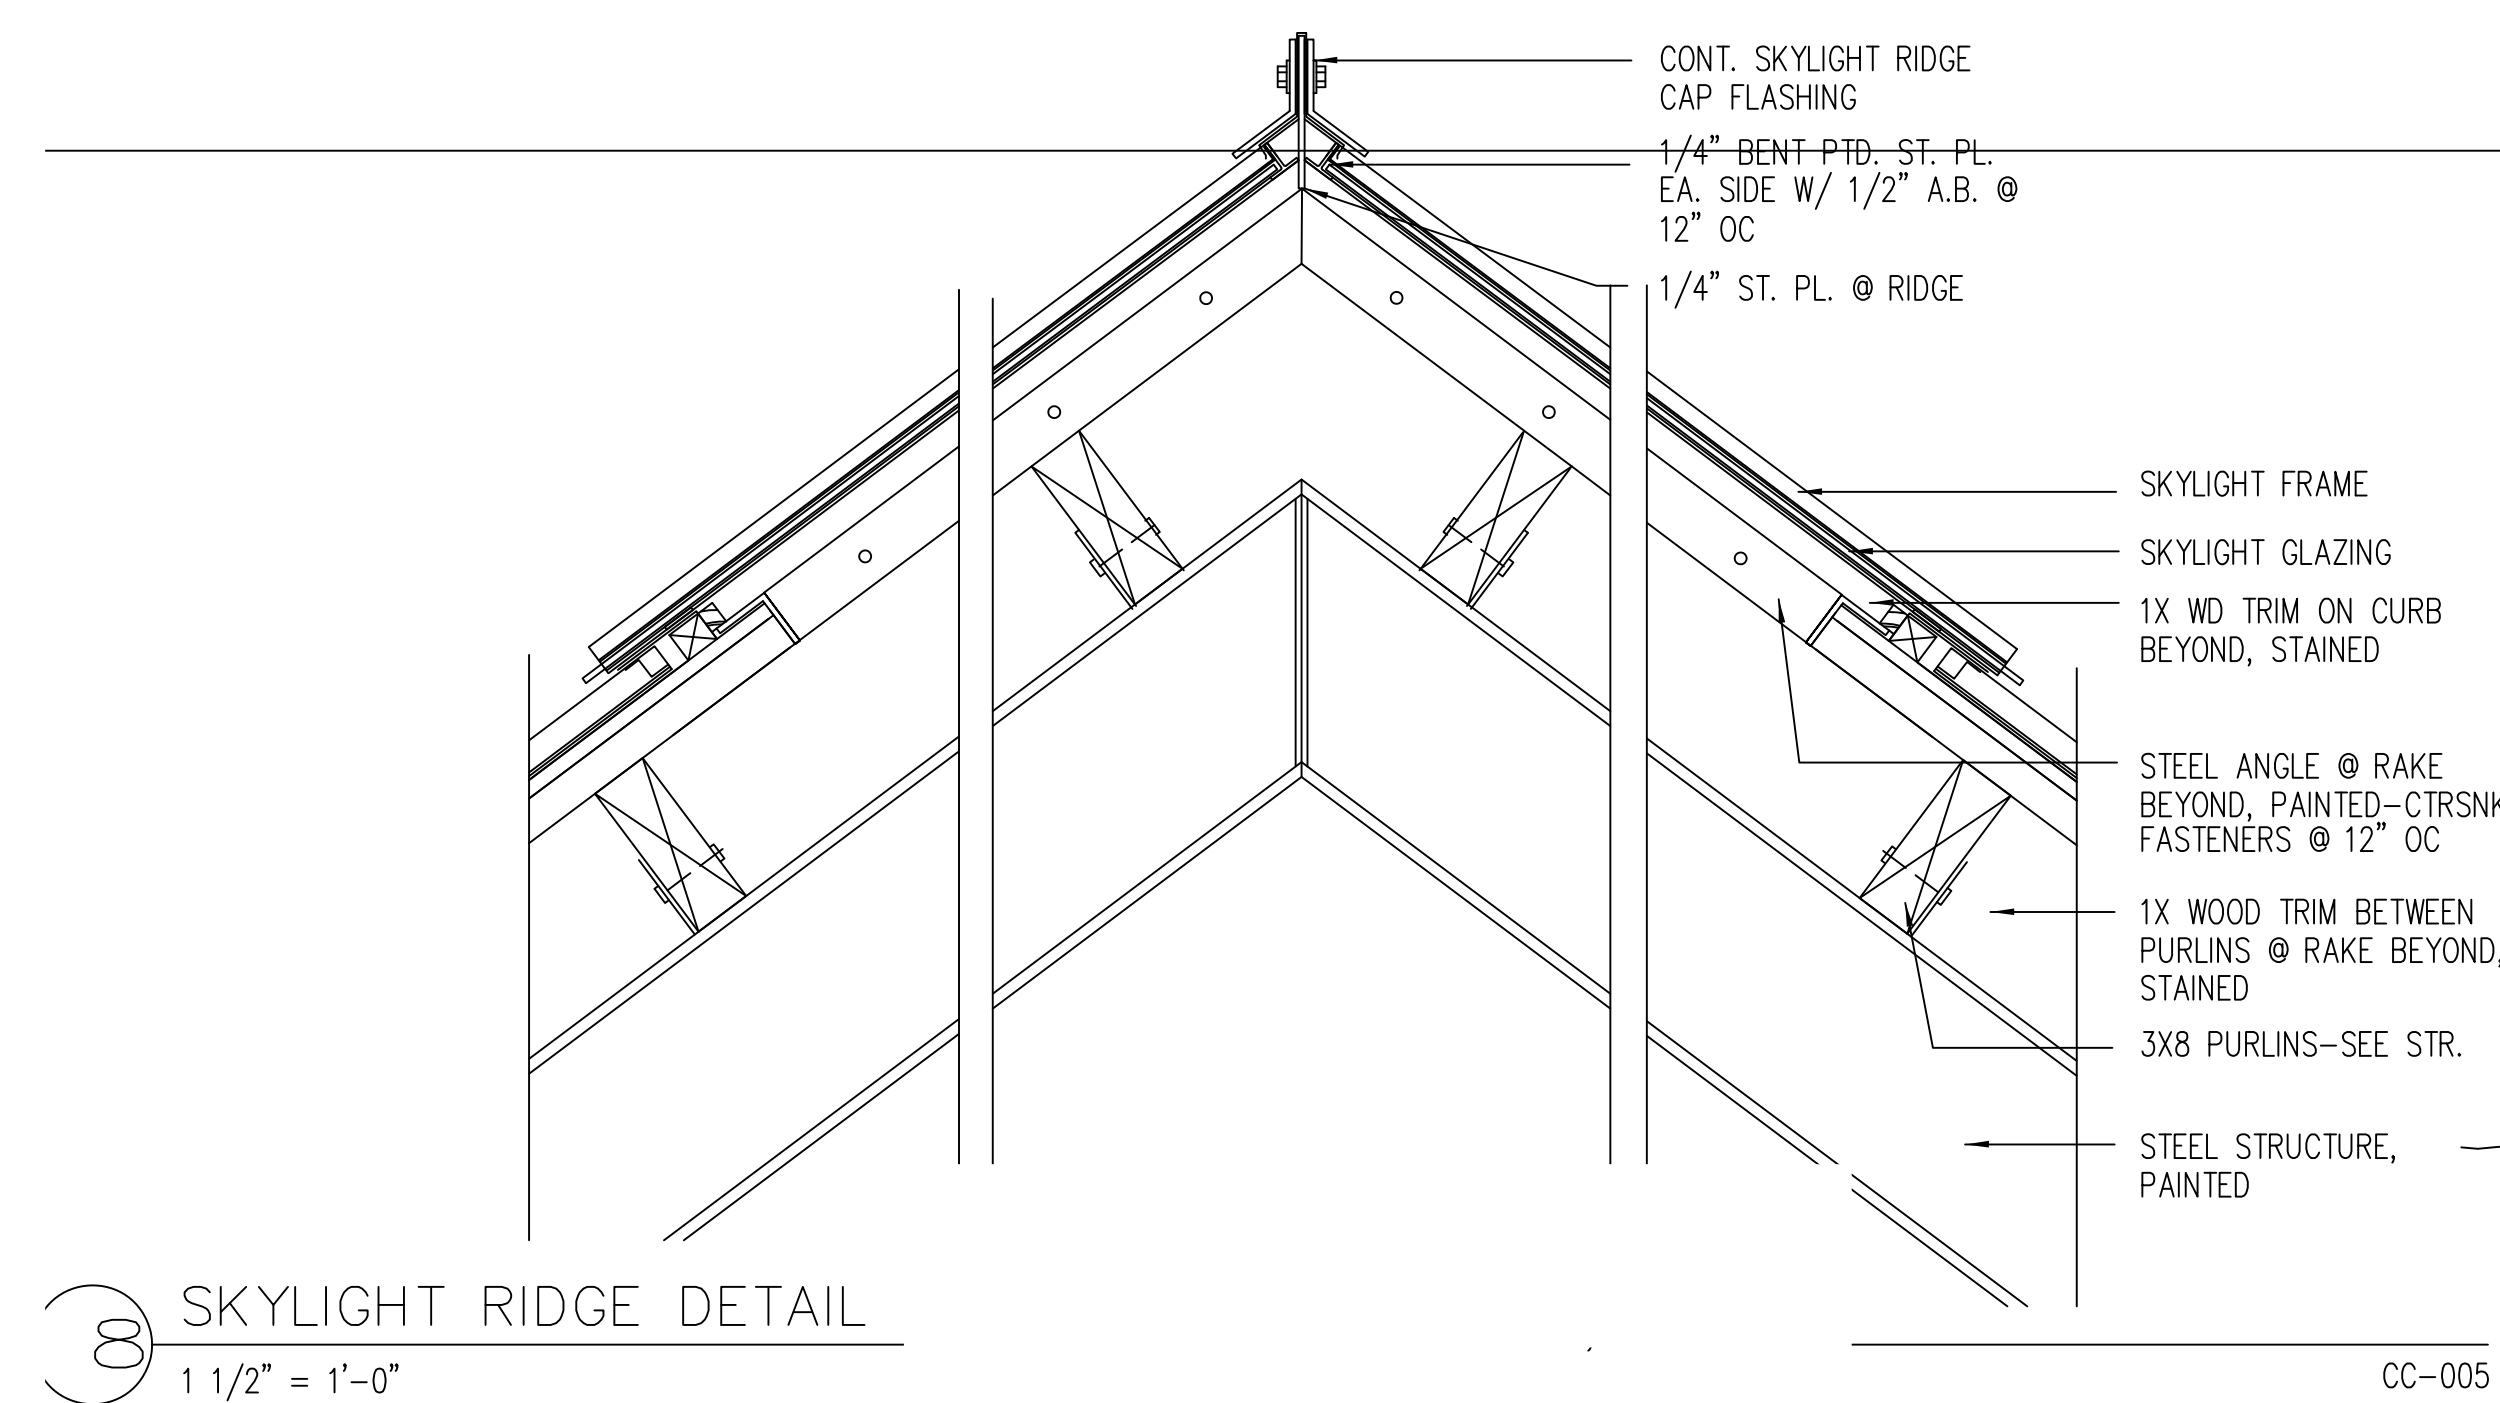

SKYLIGHT RIDGE DETAIL
1 1/2"=1'-0"

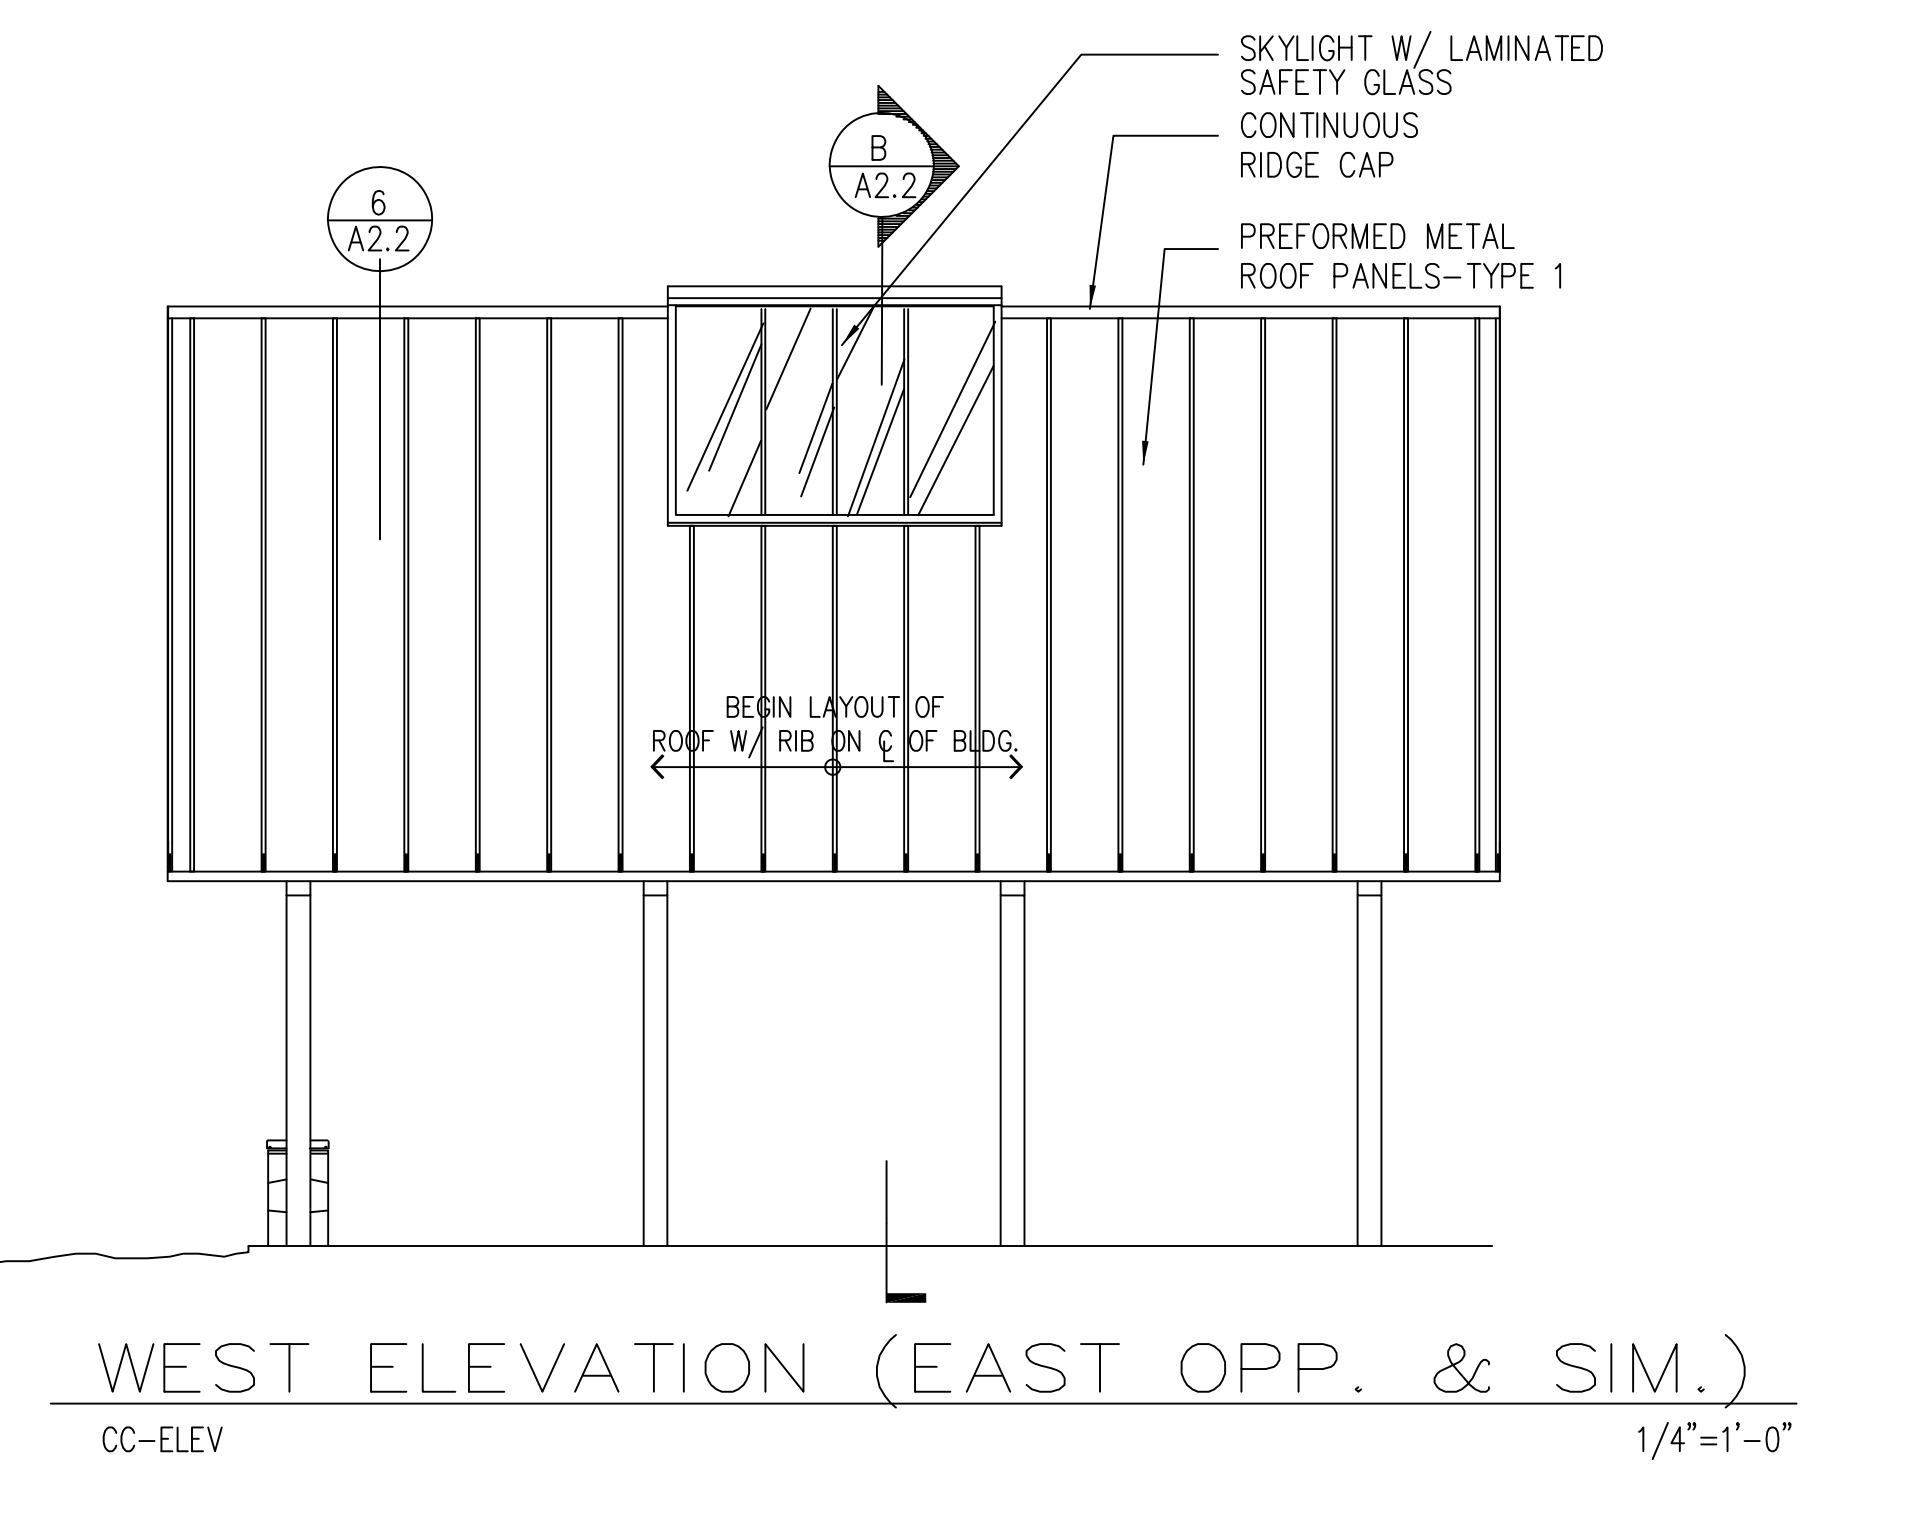

WEST ELEVATION (EAST OPP. & SIM.)
CC-ELEV 1/4"=1'-0"

RECORD DRAWING	12/31/97					Drawing Title COMMITAL SERVICE SHELTER- ELEVATIONS, SECTIONS, DETAILS		Project Title VA TAHOMA NATIONAL CEMETERY PHASE 1 DEVELOPMENT		Project Number 919-001		Department of Veterans Affairs
						Approved: VBA/NCS Team Director		Location SEATTLE, WASHINGTON		Building Number 4801 & 4802		
						Date 8/08/95		Checked VC		Drawing Number A2.2		
								Brown VC,PW		Dwg. 16 of 161		

VA FORM 08-6231A, JAN 1990

#U.S. GOVERNMENT PRINTING OFFICE: 1991-442-407