
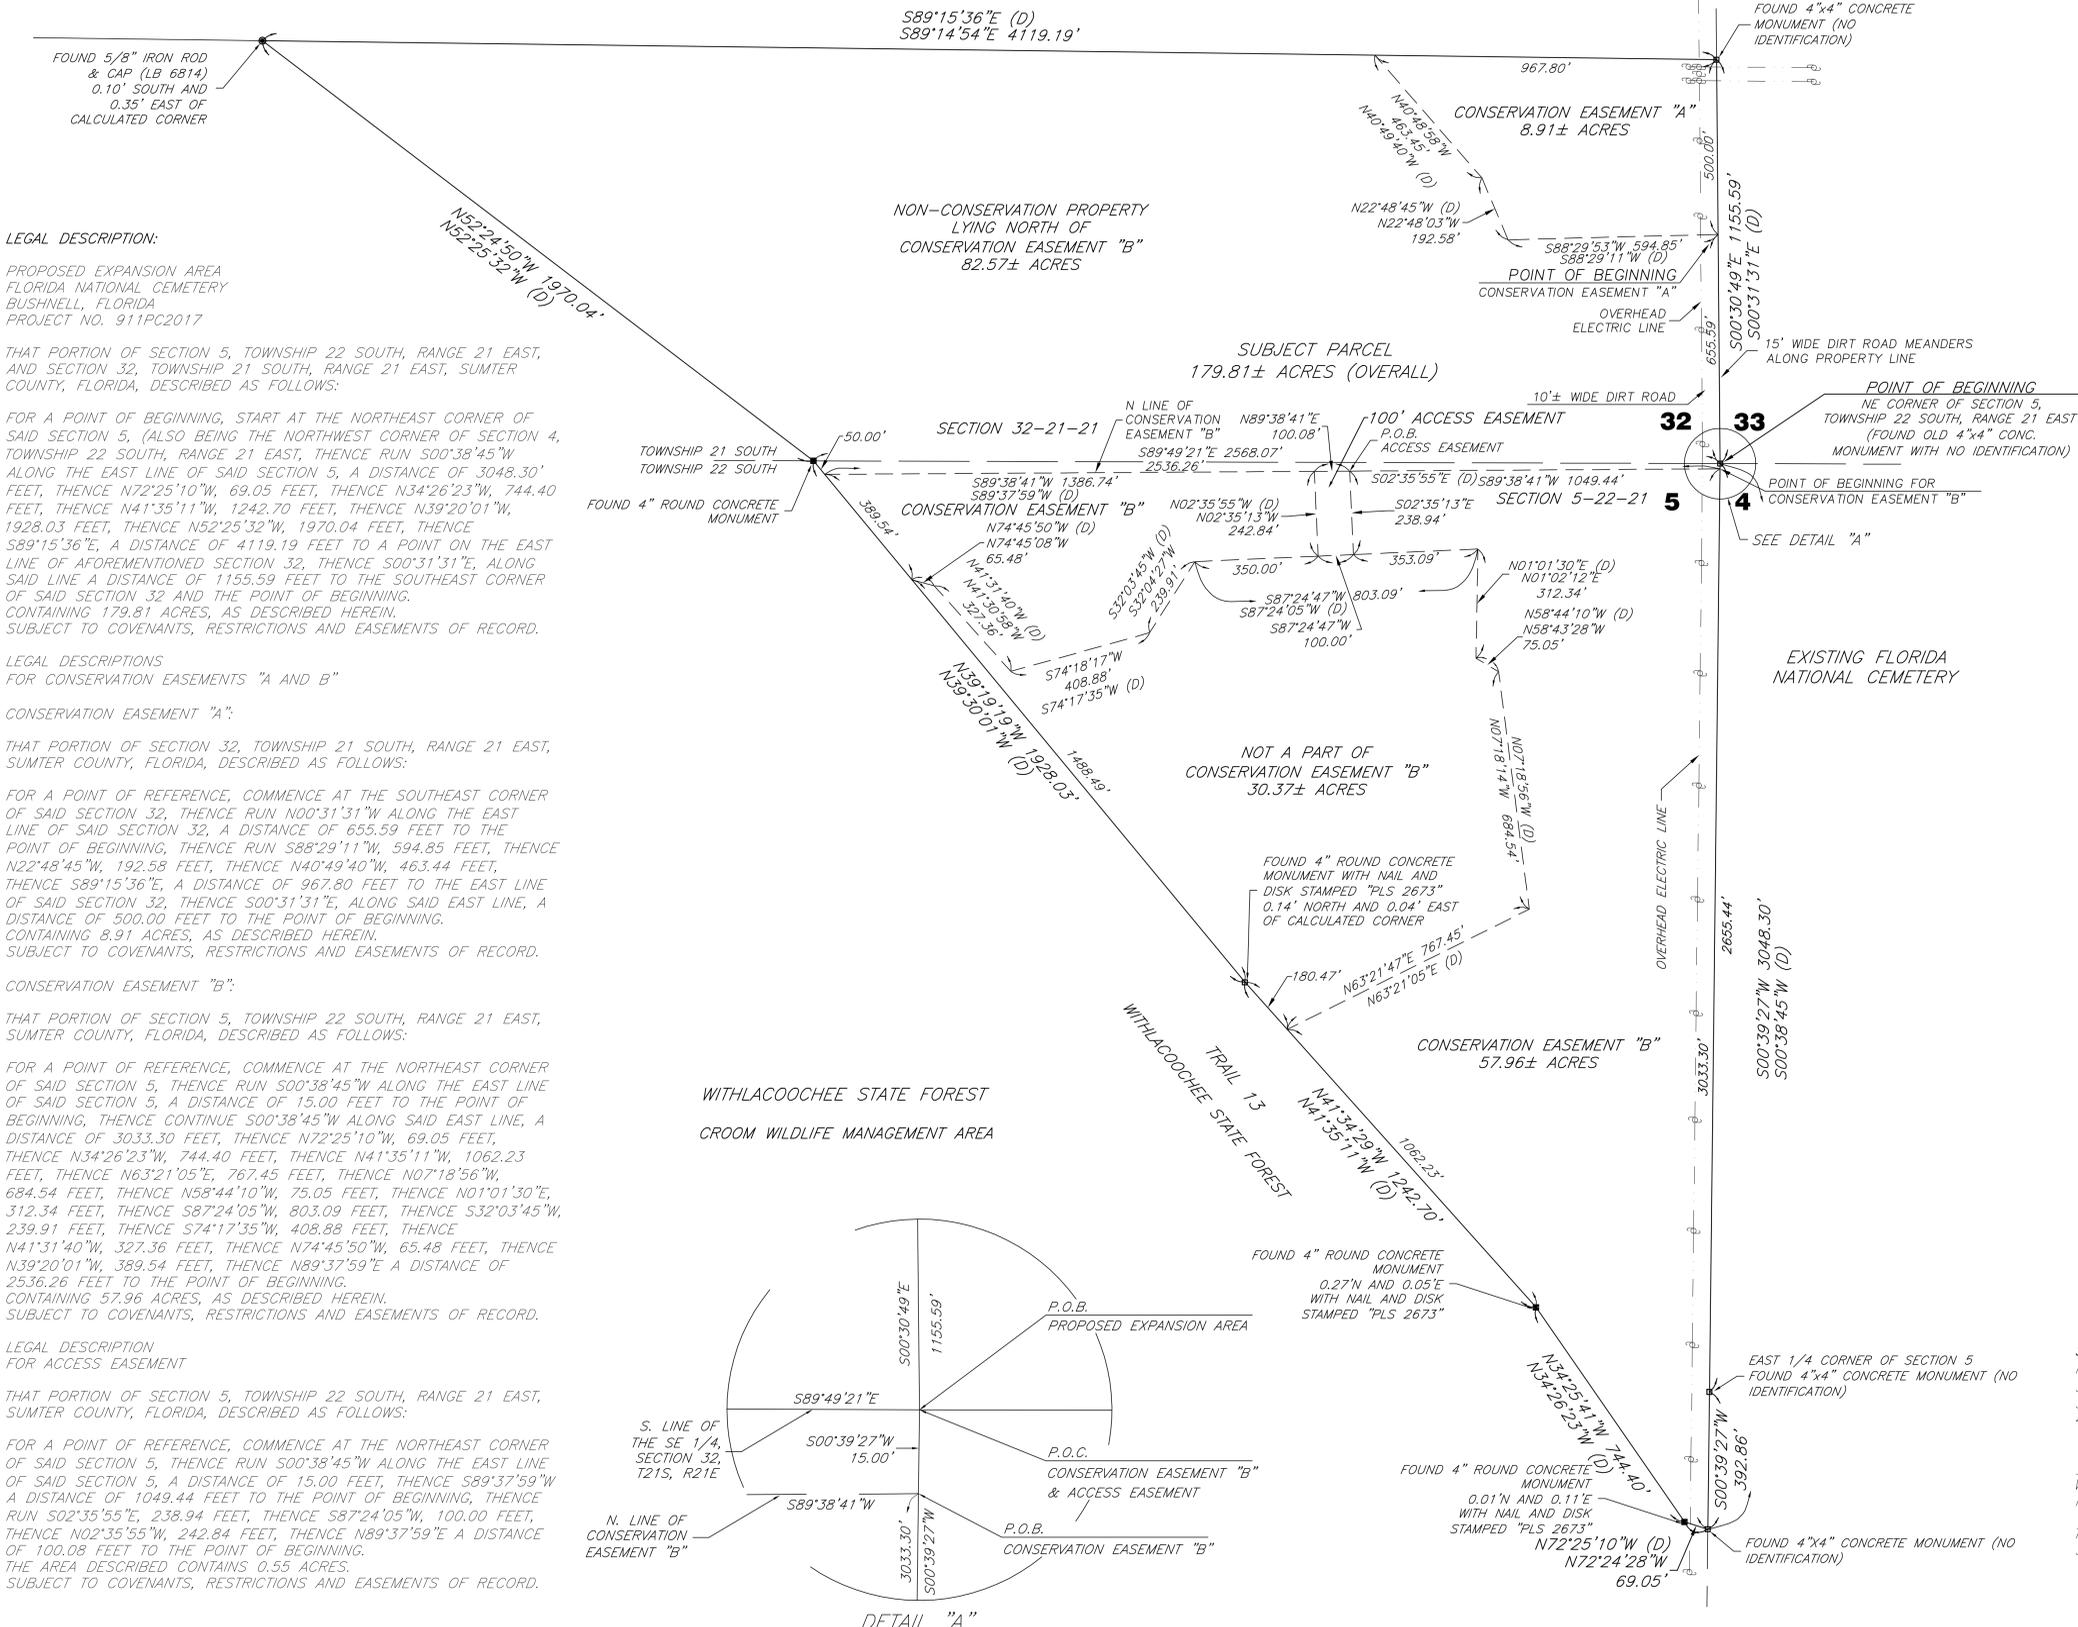
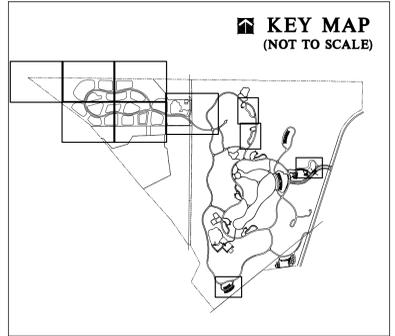


BOUNDARY AND TOPOGRAPHIC SURVEY

OF A PARCEL OF LAND LYING IN SECTION 5,
TOWNSHIP 22 SOUTH, RANGE 21 EAST AND SECTION
32, TOWNSHIP 21 SOUTH, RANGE 21 EAST,
SUMTER COUNTY, FLORIDA

WITHLACOOCHEE STATE FOREST
CROOM WILDLIFE MANAGEMENT AREA

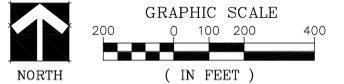

LEGAL DESCRIPTION:

PROPOSED EXPANSION AREA
FLORIDA NATIONAL CEMETERY
BUSHNELL, FLORIDA
PROJECT NO. 911PC2017

THAT PORTION OF SECTION 5, TOWNSHIP 22 SOUTH, RANGE 21 EAST,
AND SECTION 32, TOWNSHIP 21 SOUTH, RANGE 21 EAST, SUMTER
COUNTY, FLORIDA, DESCRIBED AS FOLLOWS:

FOR A POINT OF BEGINNING, START AT THE NORTHEAST CORNER OF
SAID SECTION 5, (ALSO BEING THE NORTHWEST CORNER OF SECTION 4,
TOWNSHIP 22 SOUTH, RANGE 21 EAST, THENCE RUN S00°38'45"W
ALONG THE EAST LINE OF SAID SECTION 5, A DISTANCE OF 3048.30'
FEET, THENCE N72°25'10"W, 69.05 FEET, THENCE N34°26'23"W, 744.40
FEET, THENCE N41°35'11"W, 1242.70 FEET, THENCE N39°20'01"W,
1928.03 FEET, THENCE N52°25'32"W, 1970.04 FEET, THENCE
S89°15'36"E, A DISTANCE OF 4119.19 FEET TO A POINT ON THE EAST
LINE OF AFOREMENTIONED SECTION 32, THENCE S00°31'31"E, ALONG
SAID LINE A DISTANCE OF 1155.59 FEET TO THE SOUTHEAST CORNER
OF SAID SECTION 32 AND THE POINT OF BEGINNING.
CONTAINING 179.81 ACRES, AS DESCRIBED HEREIN.
SUBJECT TO COVENANTS, RESTRICTIONS AND EASEMENTS OF RECORD.

LEGAL DESCRIPTIONS
FOR CONSERVATION EASEMENTS "A AND B"

CONSERVATION EASEMENT "A":

THAT PORTION OF SECTION 32, TOWNSHIP 21 SOUTH, RANGE 21 EAST,
SUMTER COUNTY, FLORIDA, DESCRIBED AS FOLLOWS:

FOR A POINT OF REFERENCE, COMMENCE AT THE SOUTHEAST CORNER
OF SAID SECTION 32, THENCE RUN N00°31'31"W ALONG THE EAST
LINE OF SAID SECTION 32, A DISTANCE OF 655.59 FEET TO THE
POINT OF BEGINNING, THENCE RUN S88°29'11"W, 594.85 FEET, THENCE
N22°48'45"W, 192.58 FEET, THENCE N40°49'40"W, 463.44 FEET,
THENCE S89°15'36"E, A DISTANCE OF 967.80 FEET TO THE EAST LINE
OF SAID SECTION 32, THENCE S00°31'31"E, ALONG SAID EAST LINE,
A DISTANCE OF 500.00 FEET TO THE POINT OF BEGINNING.
CONTAINING 8.91 ACRES, AS DESCRIBED HEREIN.
SUBJECT TO COVENANTS, RESTRICTIONS AND EASEMENTS OF RECORD.

CONSERVATION EASEMENT "B":

THAT PORTION OF SECTION 5, TOWNSHIP 22 SOUTH, RANGE 21 EAST,
SUMTER COUNTY, FLORIDA, DESCRIBED AS FOLLOWS:


FOR A POINT OF REFERENCE, COMMENCE AT THE NORTHEAST CORNER
OF SAID SECTION 5, THENCE RUN S00°38'45"W ALONG THE EAST LINE
OF SAID SECTION 5, A DISTANCE OF 15.00 FEET TO THE POINT OF
BEGINNING, THENCE CONTINUE S00°38'45"W ALONG SAID EAST LINE,
A DISTANCE OF 3033.30 FEET, THENCE N72°25'10"W, 69.05 FEET,
THENCE N34°26'23"W, 744.40 FEET, THENCE N41°35'11"W, 1062.23
FEET, THENCE N63°21'05"E, 767.45 FEET, THENCE N07°18'56"W,
684.54 FEET, THENCE N58°44'10"W, 75.05 FEET, THENCE N01°01'30"E,
312.34 FEET, THENCE S87°24'05"W, 803.09 FEET, THENCE S32°03'45"W,
239.91 FEET, THENCE S74°17'35"W, 408.88 FEET, THENCE
N41°31'40"W, 327.36 FEET, THENCE N74°45'50"W, 65.48 FEET, THENCE
N39°20'01"W, 389.54 FEET, THENCE N89°37'59"E A DISTANCE OF
2536.26 FEET TO THE POINT OF BEGINNING.
CONTAINING 57.96 ACRES, AS DESCRIBED HEREIN.
SUBJECT TO COVENANTS, RESTRICTIONS AND EASEMENTS OF RECORD.

LEGAL DESCRIPTION
FOR ACCESS EASEMENT

THAT PORTION OF SECTION 5, TOWNSHIP 22 SOUTH, RANGE 21 EAST,
SUMTER COUNTY, FLORIDA, DESCRIBED AS FOLLOWS:

FOR A POINT OF REFERENCE, COMMENCE AT THE NORTHEAST CORNER
OF SAID SECTION 5, THENCE RUN S00°38'45"W ALONG THE EAST LINE
OF SAID SECTION 5, A DISTANCE OF 15.00 FEET, THENCE S89°37'59"E
A DISTANCE OF 1049.44 FEET TO THE POINT OF BEGINNING, THENCE
RUN S02°35'55"E, 238.94 FEET, THENCE S87°24'05"W, 100.00 FEET,
THENCE N02°35'55"W, 242.84 FEET, THENCE N89°37'59"E A DISTANCE
OF 100.08 FEET TO THE POINT OF BEGINNING.
THE AREA DESCRIBED CONTAINS 0.55 ACRES.
SUBJECT TO COVENANTS, RESTRICTIONS AND EASEMENTS OF RECORD.

WITHLACOOCHEE STATE FOREST
CROOM WILDLIFE MANAGEMENT AREA

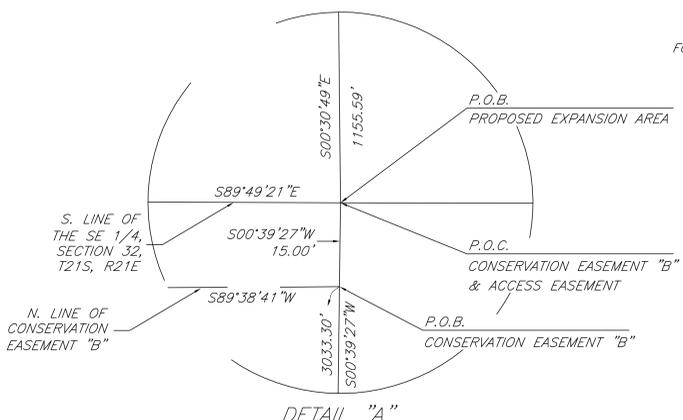

NOTES:

- BEARINGS SHOWN HEREON ARE BASED ON THE STATE PLANE
COORDINATE SYSTEM, ZONE 0902 FLORIDA WEST, 1927 NORTH
AMERICAN DATUM, AS ESTABLISHED FROM THE PUBLISHED NATIONAL
GEODETIC SURVEY DATA NETWORK SYSTEM, HOLDING THE FOLLOWING
PUBLISHED NGS CONTROL POINTS:

175 73 DO1, PID# AL6868 = NORTHING 1551542.06832, EASTING
434613.53264
HERNCO H10, PID# AL7313 = NORTHING 1548632.55081, EASTING
423725.27522

BASED ON THE CONTROL MONUMENT'S RELATIONSHIP AS DETERMINED
FROM A FIELD SURVEY, A BEARING OF S00°39'27"E HAS BEEN DERIVED
FOR THE EAST LINE OF THE NORTHEAST 1/4, OF SECTION 5,
TOWNSHIP 22 SOUTH, RANGE 21 EAST, SUMTER COUNTY, FLORIDA AS
SHOWN HEREON.

VERTICAL CONTROL AS SHOWN HEREON IS BASED ON NGVD 1929
DATUM, AS ESTABLISHED FROM THE PUBLISHED NATIONAL GEODETIC
SURVEY DATA NETWORK SYSTEM, HOLDING FIXED THE FOLLOWING
PUBLISHED NGS CONTROL POINTS:

175 73 DO1, PID# AL6868, ELEVATION = 82.28 (NGVD29)
CROOM, PID# AL7033, ELEVATION = 82.08 (NGVD29)
- ALL NONVISIBLE AND SUBSURFACE IMPROVEMENTS NOT LOCATED
UNLESS NOTED OTHERWISE.
- THE PROPERTY DESCRIPTION AS DEPICTED HEREON WAS FURNISHED BY
THE CLIENT. THE MAP OF BOUNDARY SURVEY SHOWN HEREON
REPRESENTS THE BOUNDARIES OF THE LANDS ENCOMPASSED BY SAID
DESCRIPTION. THIS MAP OF BOUNDARY SURVEY MAKES NO CLAIMS
REGARDING OWNERSHIP OR RIGHTS OF POSSESSION.
- THIS SURVEY WAS PERFORMED WITHOUT THE BENEFIT OF A CERTIFIED
TITLE REPORT. THIS PROPERTY MAY BE SUBJECT TO ADDITIONAL
EASEMENTS, COVENANTS AND RESTRICTIONS NOT SHOWN HEREON BUT
FOUND IN THE PUBLIC RECORDS OF THIS COUNTY.
- THE PROPERTY DESCRIPTION AS DEPICTED HEREON WAS FIELD
SURVEYED JULY 15, 2005 AND WAS VACANT WITHOUT STRUCTURAL
IMPROVEMENT AS OF SAID DATE.
- WETLAND AND OTHER JURISDICTIONAL AREAS WERE NOT ADDRESSED
AS PART OF THIS SURVEY, UNLESS NOTED OTHERWISE.
- THIS SURVEYOR HAS NOT FOUND OR BEEN FURNISHED ANY RECORDED
DOCUMENTATION OF ADJOINING ACCESS TO AND FROM SAID PROPERTY
TO THE PUBLIC ROAD SYSTEM.
- NO RECORDED EASEMENT DOCUMENTS FOR THE EXISTING OVERHEAD
ELECTRICAL SERVICE LINE OVER THE EASTERLY PORTION OF THE
SUBJECT PROPERTY HAS BEEN FOUND BY OR FURNISHED TO THIS
SURVEYOR.
- ACCORDING TO THE FEDERAL EMERGENCY MANAGEMENT AGENCY (FIRM)
PANEL NO. 120296 0200 B, SUMTER COUNTY, FLORIDA, WITH AN
EFFECTIVE DATE OF MARCH 15, 1982, THE PROPERTY DESCRIBED
HEREON LIES WITHIN ZONE "c" AND OUTSIDE THE 100 YEAR FLOOD
HAZARD AREA.

SURVEYOR'S CERTIFICATE:
I HEREBY CERTIFY THIS SURVEY MEETS THE APPLICABLE "MINIMUM TECHNICAL
STANDARDS" AS SET FORTH BY THE FLORIDA BOARD OF PROFESSIONAL
SURVEYORS AND MAPPERS IN CHAPTER 61G17-6, PURSUANT TO SECTION
472.027, FLORIDA STATUTES.

WILLIAM D. DONLEY
FLORIDA LICENSED SURVEYOR & MAPPER NO. 5381

THIS SURVEY IS NOT VALID WITHOUT THE SIGNATURE AND ORIGINAL RAISED
SEAL OF A FLORIDA LICENSED SURVEYOR AND MAPPER.

<p>PREPARED BY:</p> <p>CONSULTANTS:</p> <p>the LA group Landscape Architecture and Engineering, P.C. 40 Long Alley Saratoga Springs, NY 12866 518/687-8100 Telefax 518/587-0180 Web: www.thelagroup.com</p>	<p>BOWYER-SINGLETON & ASSOCIATES, INCORPORATED</p> <p>ENGINEERING • PLANNING • SURVEYING • ENVIRONMENTAL</p> <p>520 SOUTH MAGNOLIA AVENUE • ORLANDO, FLORIDA 32801 407-843-0125 • FAX 407-848-9854 ENGINEERING BUSINESS #1221</p>	<p>Aqua Engineering, Inc.</p> <p>Irrigation System Design, Water Management, and Water Feature Engineering</p> <p>4803 Innovation Drive Fort Collins, Colorado 80525 Phone (970) 229-9668 FAX (970) 226-3855</p>	<p>C.T. HSU + ASSOCIATES, P.A.</p> <p>ARCHITECTURE • PLANNING • INTERIOR DESIGN</p> <p>FL. LIC. # AA-C001322 820 Irma Avenue Orlando, FL 32803 Tel 407.423.0098 Fax 407.423.4793</p>	<p>NATIONAL CEMETERY ADMINISTRATION</p>	<p>Drawing Title</p> <p>BOUNDARY AND TOPOGRAPHIC SURVEY</p>	<p>Project Title</p> <p>FLORIDA NATIONAL CEMETERY PHASE 4B EXPANSION</p>	<p>Submital</p> <p>RECORD DRAWINGS</p>
					<p>Approved: David Stankic, Acting NCA Team Leader</p>	<p>Building Number</p> <p>Checked</p> <p>WDD</p>	<p>Drawn</p> <p>GLG</p>