

(typ) Elec.Outlet

116.00'

(typ) Light

109.00'

155.00'

LOW VOLTAGE
WIRING FOR
VEEDER-ROOT
LEAK SENSORS
(6) CONDUITS

TANK 1
TANK 2

TANK 3

TANK 4


TANK 5

40.00'

FUEL DISPENSER
ISLAND

30.00'

BUILDING # 7

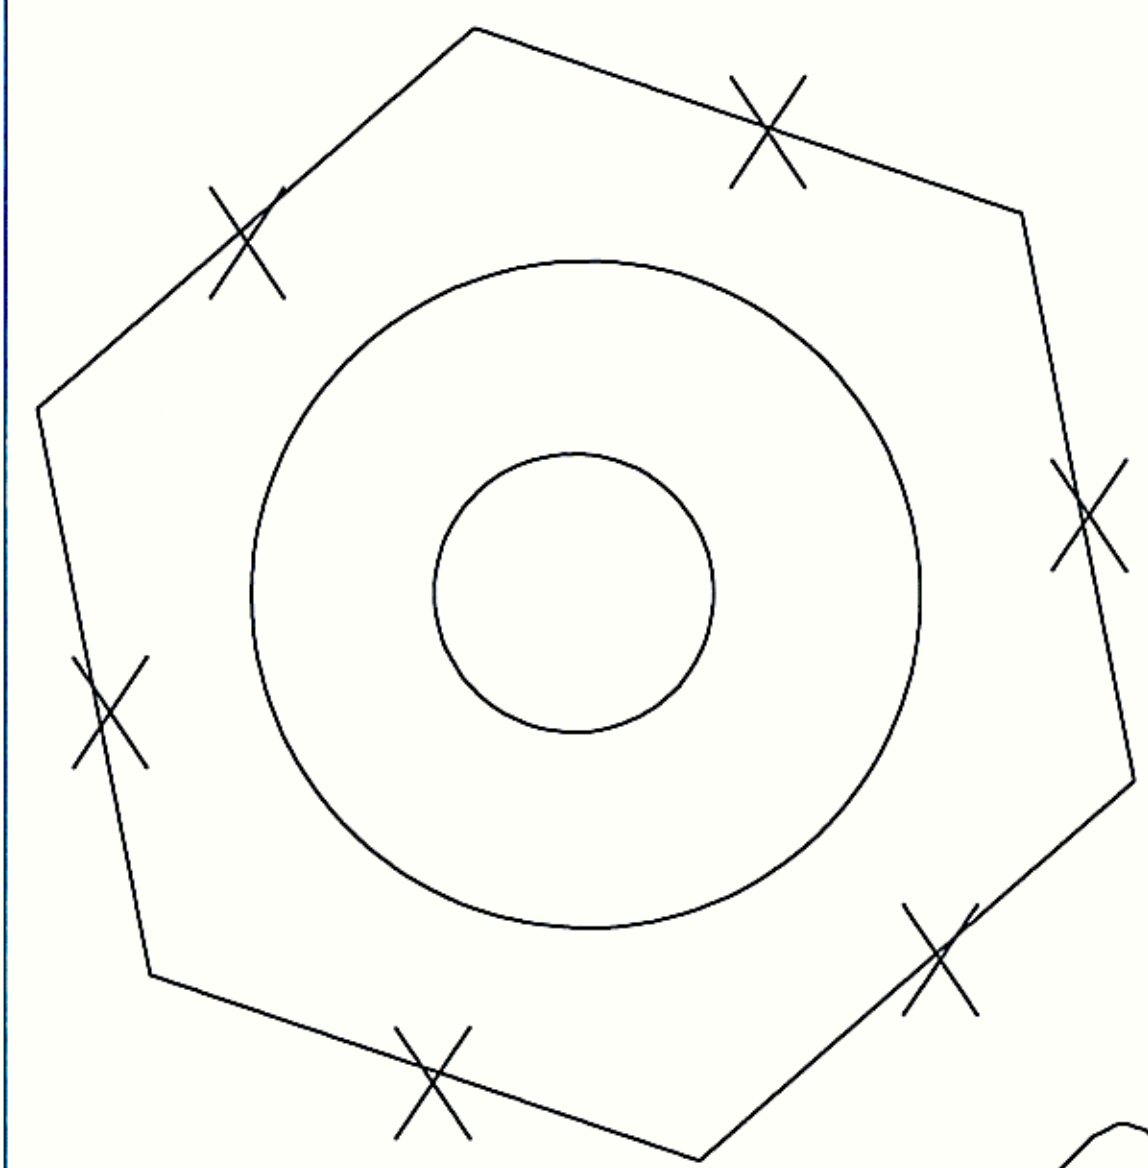

PARKING
LOT C

3							
2							
1							
NO.	DATE	REVISION	BY				
AS-BUILT OF UNDERGROUND CONTROL WIRING VA MEDICAL CENTER - BUILDING 7 718 SMYTH ROAD PREPARED FOR: VETERANS AFFAIRS DEPARTMENT OF VETERANS AFFAIRS 718 SMYTH ROAD NOVEMBER 16, 1998							
 SCALE: 1" = 20'							
		FIELD BOOK:			DWG.NAME: AS-BLD7-CONTROL		
		DESIGNED BY: VETERAN AFFAIRS		DRAFTED BY: HEI		APPROVED BY: VA	
		JOB No.: 608-96-108		ACAD No.: VA608-96		SHEET 1 OF 1	

© 1998, HONG ENVIRONMENTAL