



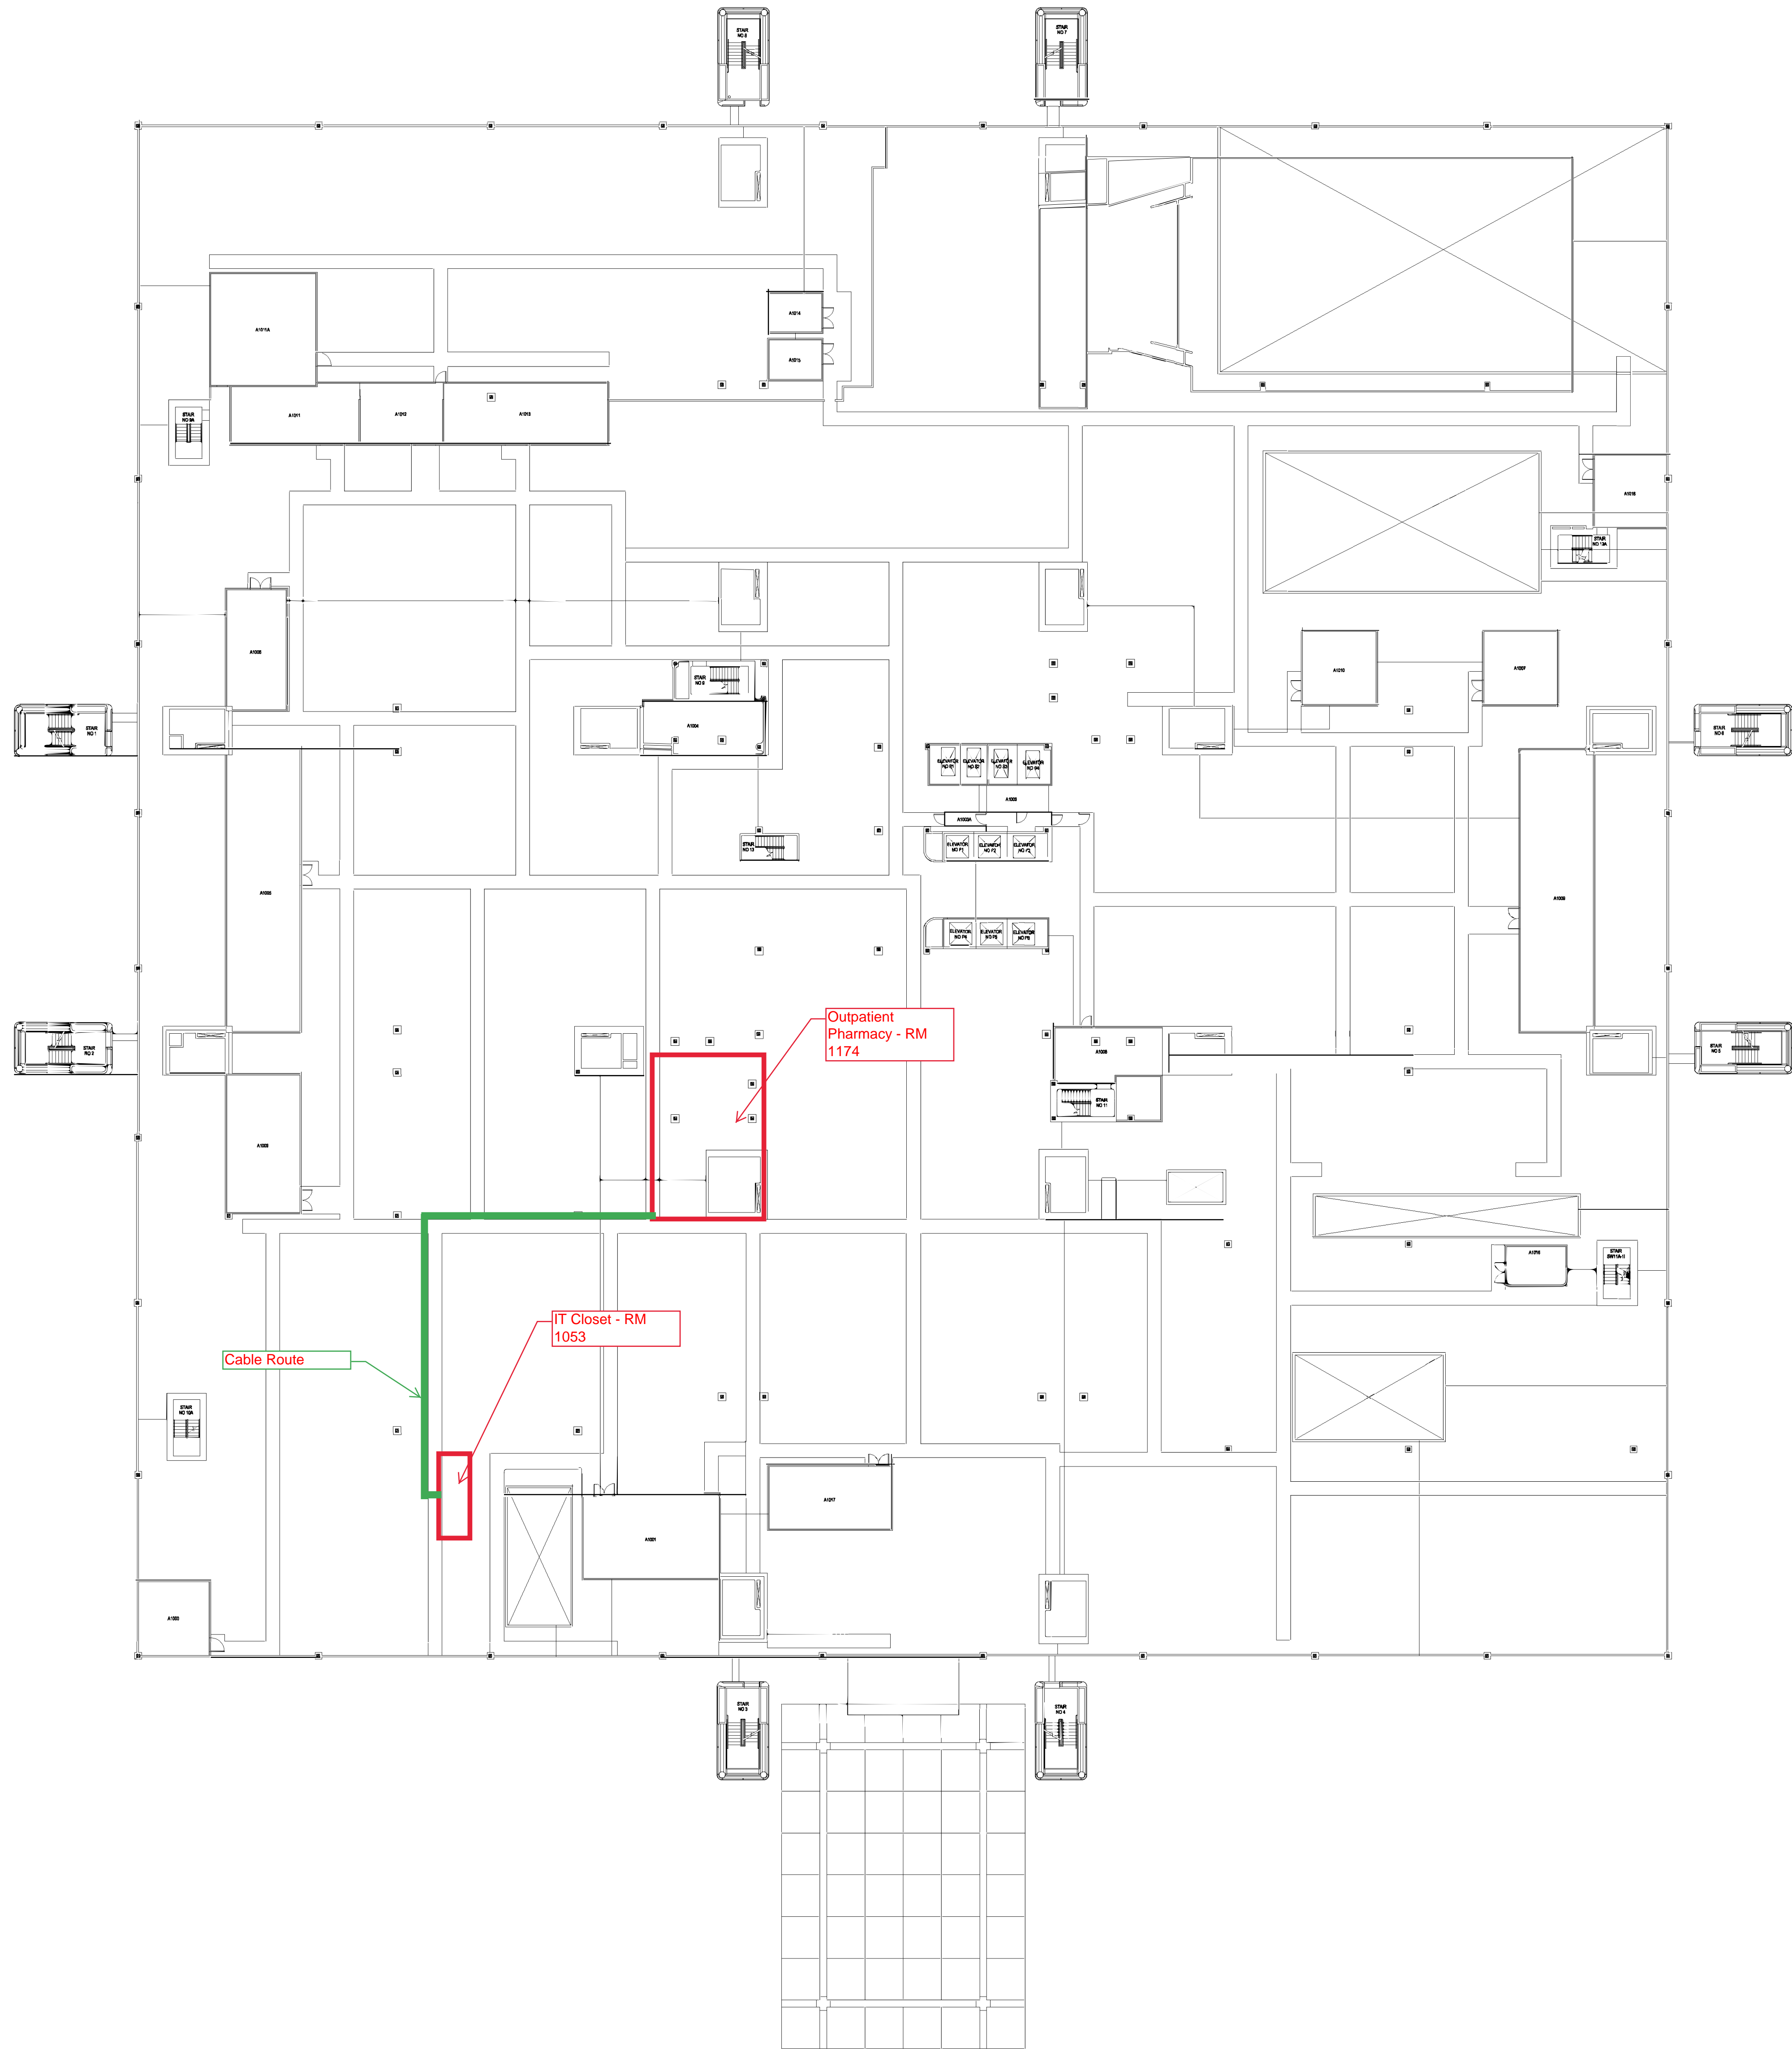

one eighth inch = one foot  
0 4 8  
one quarter inch = one foot  
0 4 8  
three eighths inch = one foot  
0 4 8  
one half inch = one foot  
0 4 8  
three quarters inch = one foot  
0 4 8  
one inch = one foot  
0 4 8  
one and one half inches = one foot  
0 4 8  
two inches = one foot  
0 4 8  
three inches = one foot  
0 4 8

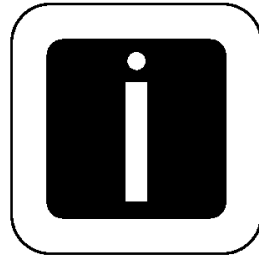

		Architects/Engineers/Consultants:		 <b>Indus Systems, Inc</b> 2352, Main Street, Concord MA 01742 Tel: 978-461-0555 www.indus-systems.com		Drawing Title <b>FIRST FLOOR INTERSTITIAL PLAN ARCHITECTURAL</b>		Project Title <b>AS-BUILT Drawings</b>		Project Number:		 <b>Office of Facilities Management</b>			
						Approved Project Director:		Location: <b>VA MEDICAL CENTER SAN DIEGO</b>		Building Number: <b>1</b>					
Revisions		Date		Professional Seal				Date: <b>02-21-2014</b>		Checked:		Drawn:		Drawing Number:	
										Dwg. of				 Department of Veterans Affairs	