

A

B

C

D

E

F

0  
Three inches = one foot

0  
one and one half inches = one foot

0  
one inch = one foot



0  
three quarters inch = one foot

0  
one half inch = one foot

0  
three eighths inch = one foot

0  
one quarter inch = one foot

0  
one eighth inch = one foot

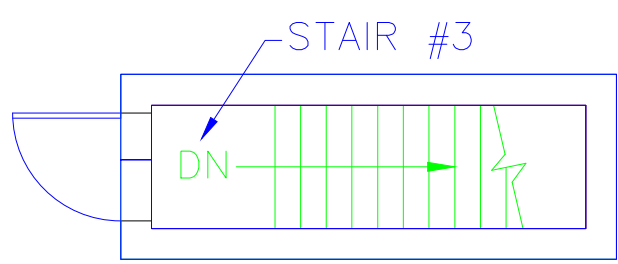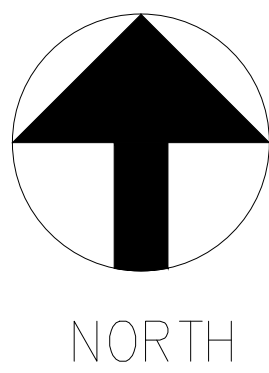

A



B

C

D

E

F

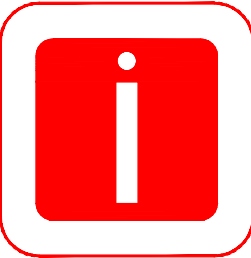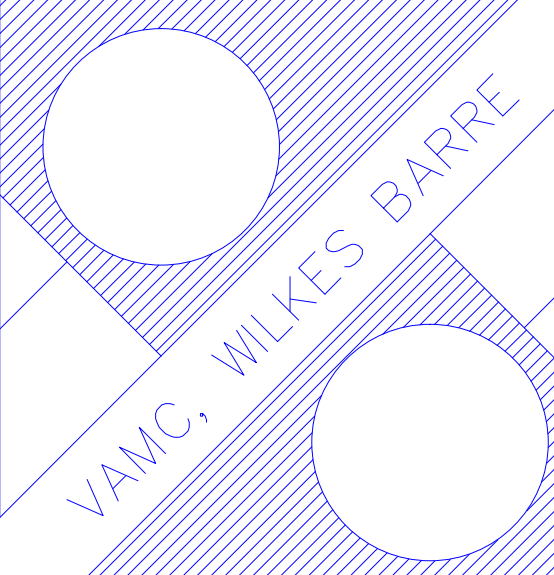Revisions		Date			 <div>Indus Systems, Inc. 2352, Main Street, Concord MA 01742 Tel: 978-461-0555 www.indus-systems.com</div>	Drawing Title PENT HOUSE FLOOR PLAN ARCHITECTURAL		Project Title AS-BUILT Drawings		Date 10-27-2010			VA Department of Veterans Affairs
						Approved:		Building Number 01		Checked	Drawn		
Revisions		Date				Approved:		Location VAMC, WILKES BARRE PENNSYLVANIA		Drawing No.			