

A

B

C

D

E

F

A

B

C

D

E

F

three eighths inch = one foot

one eighth inch = one foot

one quarter inch = one foot


three eighths inch = one foot

one half inch = one foot

one inch = one foot

one and one half inches = one foot

three inches = one foot

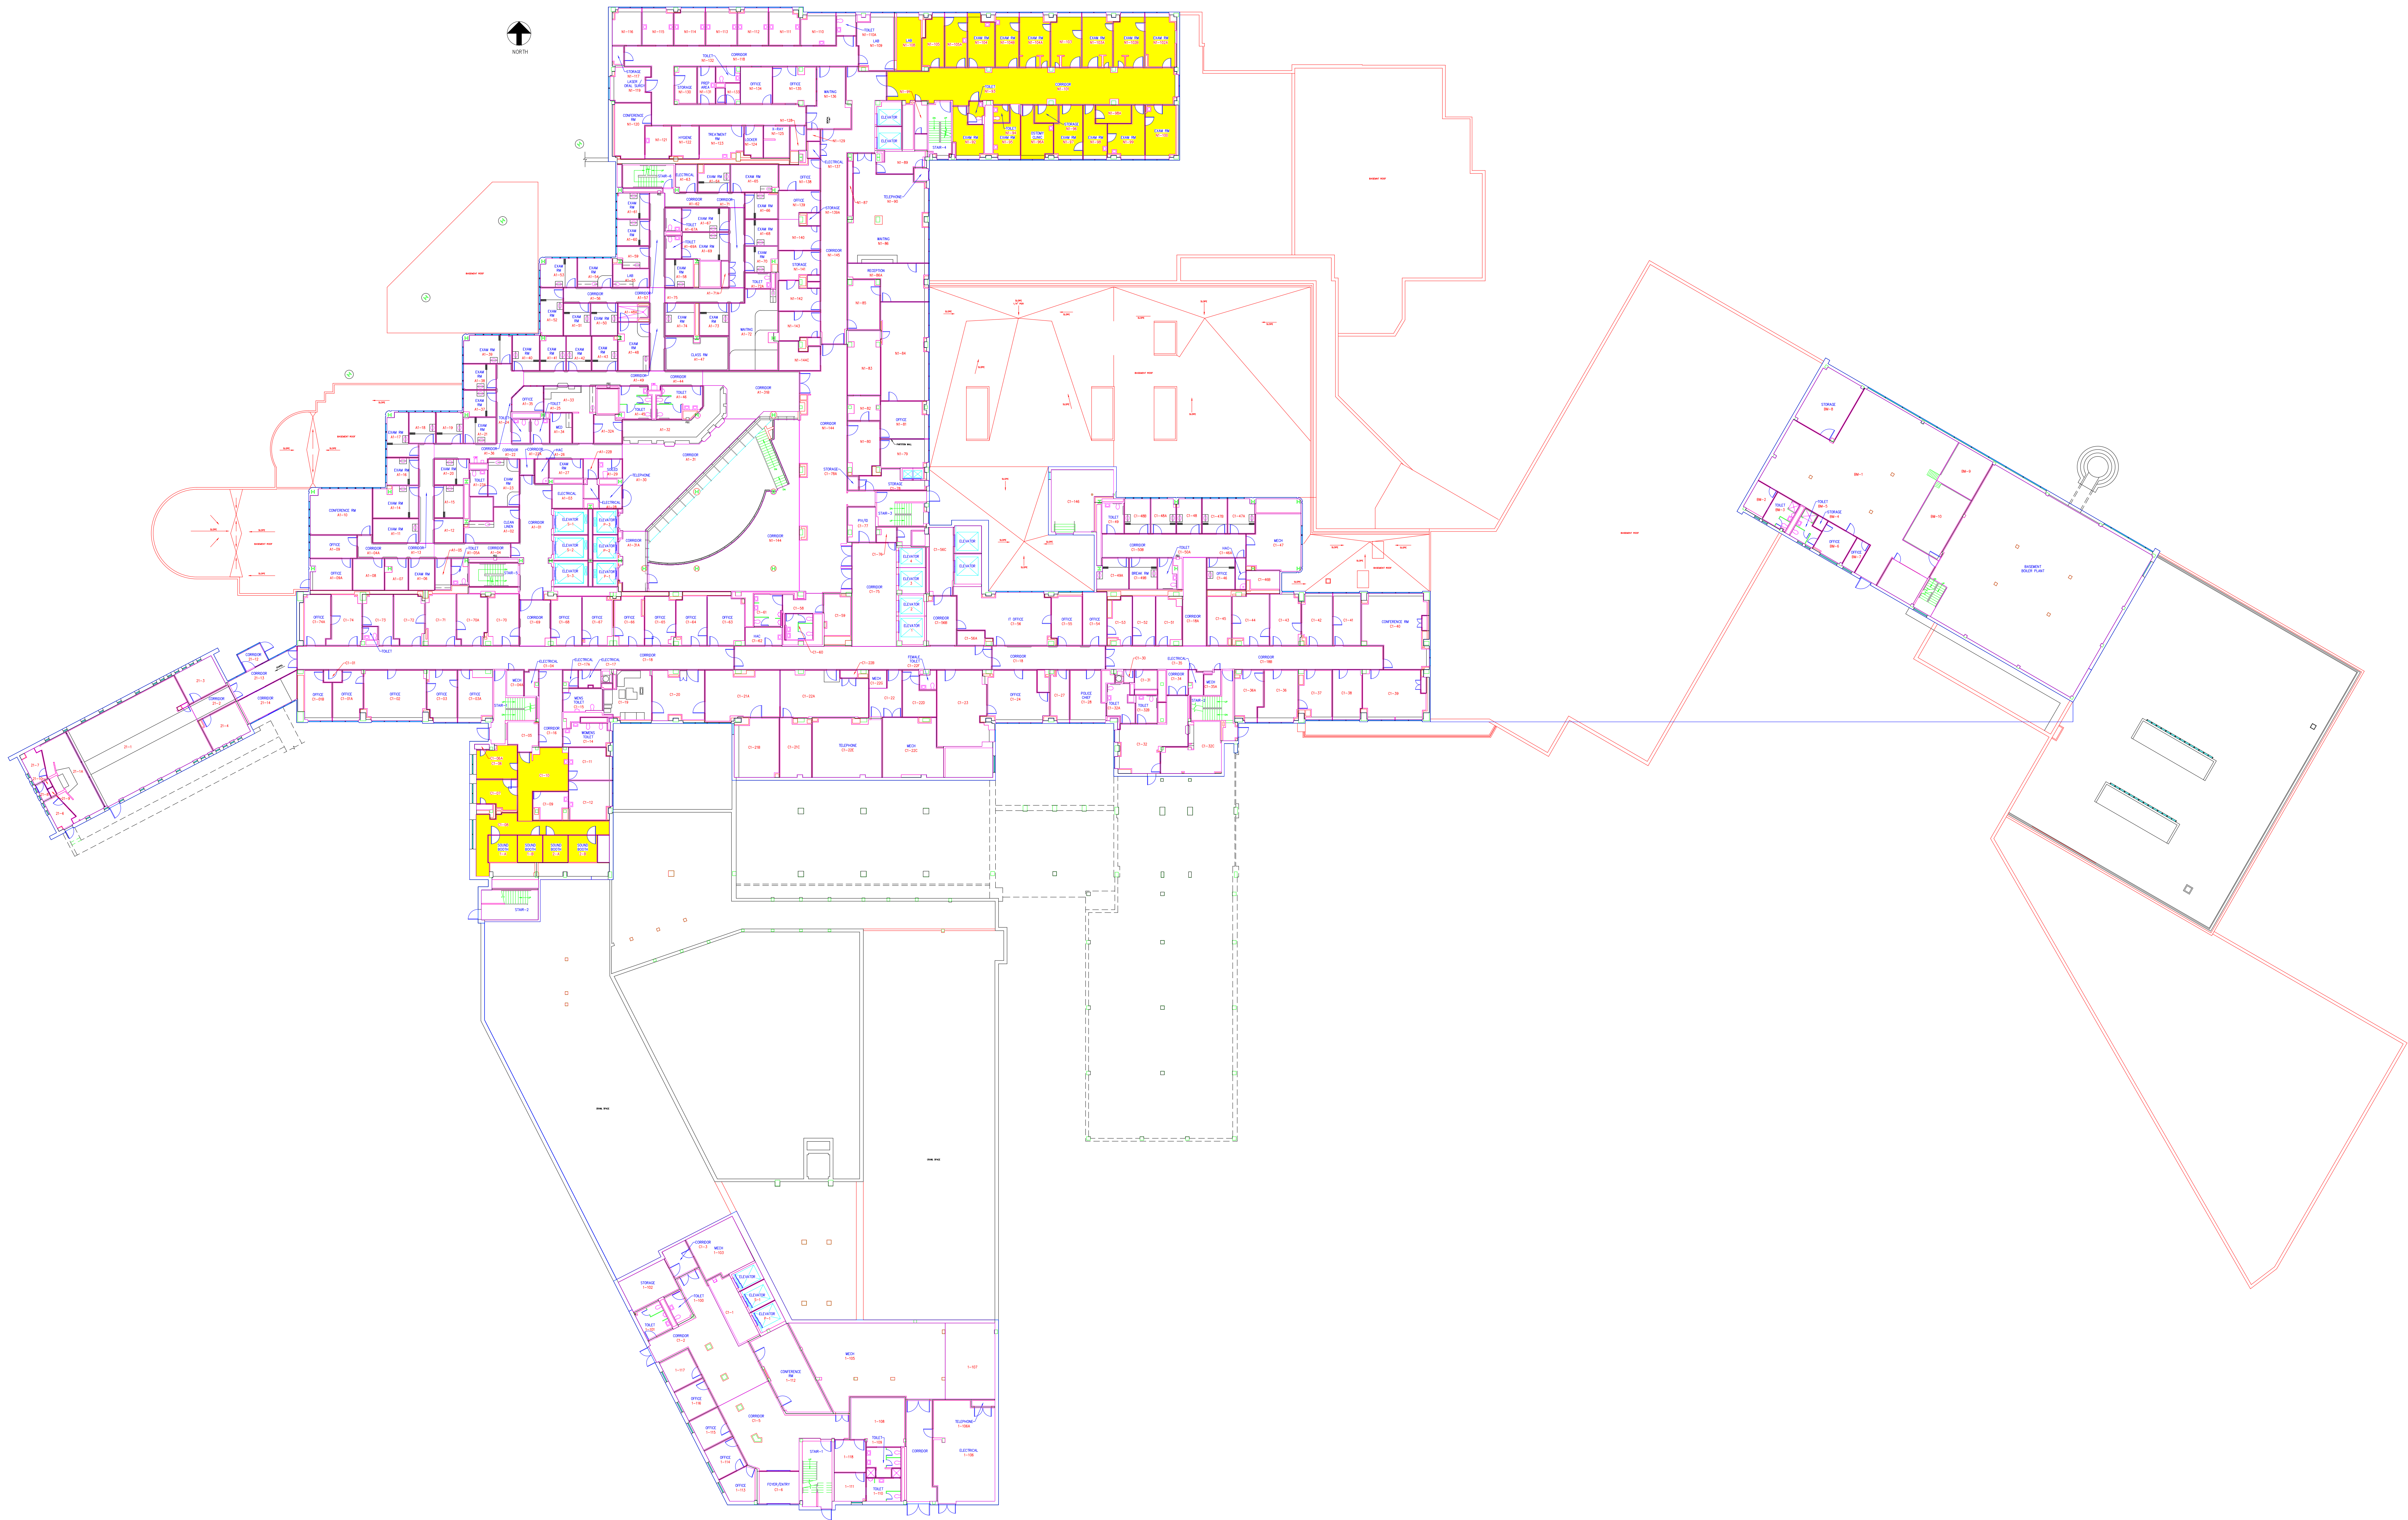

A

B

C

D

E

F

A

B

C

D

E

F

Revisions		Date		Professional Seal		Indus Systems, Inc. 2352, Main Street, Concord MA 01742 Tel: 978-461-0555 www.indus-systems.com		Drawing Title FIRST FLOOR PLAN ARCHITECTURAL		Project Title AS-BUILT Drawings		Date 11-09-2010		Project No.		Drawing No.		VAMC, WILKES BARRE		Department of Veterans Affairs	
Approved:		Approved:		Approved:		Approved:		Approved:		Building Number 01		Checked		Drawn		Drawing No.		VAMC, WILKES BARRE PENNSYLVANIA		VAMC, WILKES BARRE	