

A

B

C

D

E

F

VA

three sixteenths inch = one foot

one and one half inches = one foot

one inch = one foot

three quarters inch = one foot

one half inch = one foot

three eighths inch = one foot

one quarter inch = one foot

one eighth inch = one foot

A

B

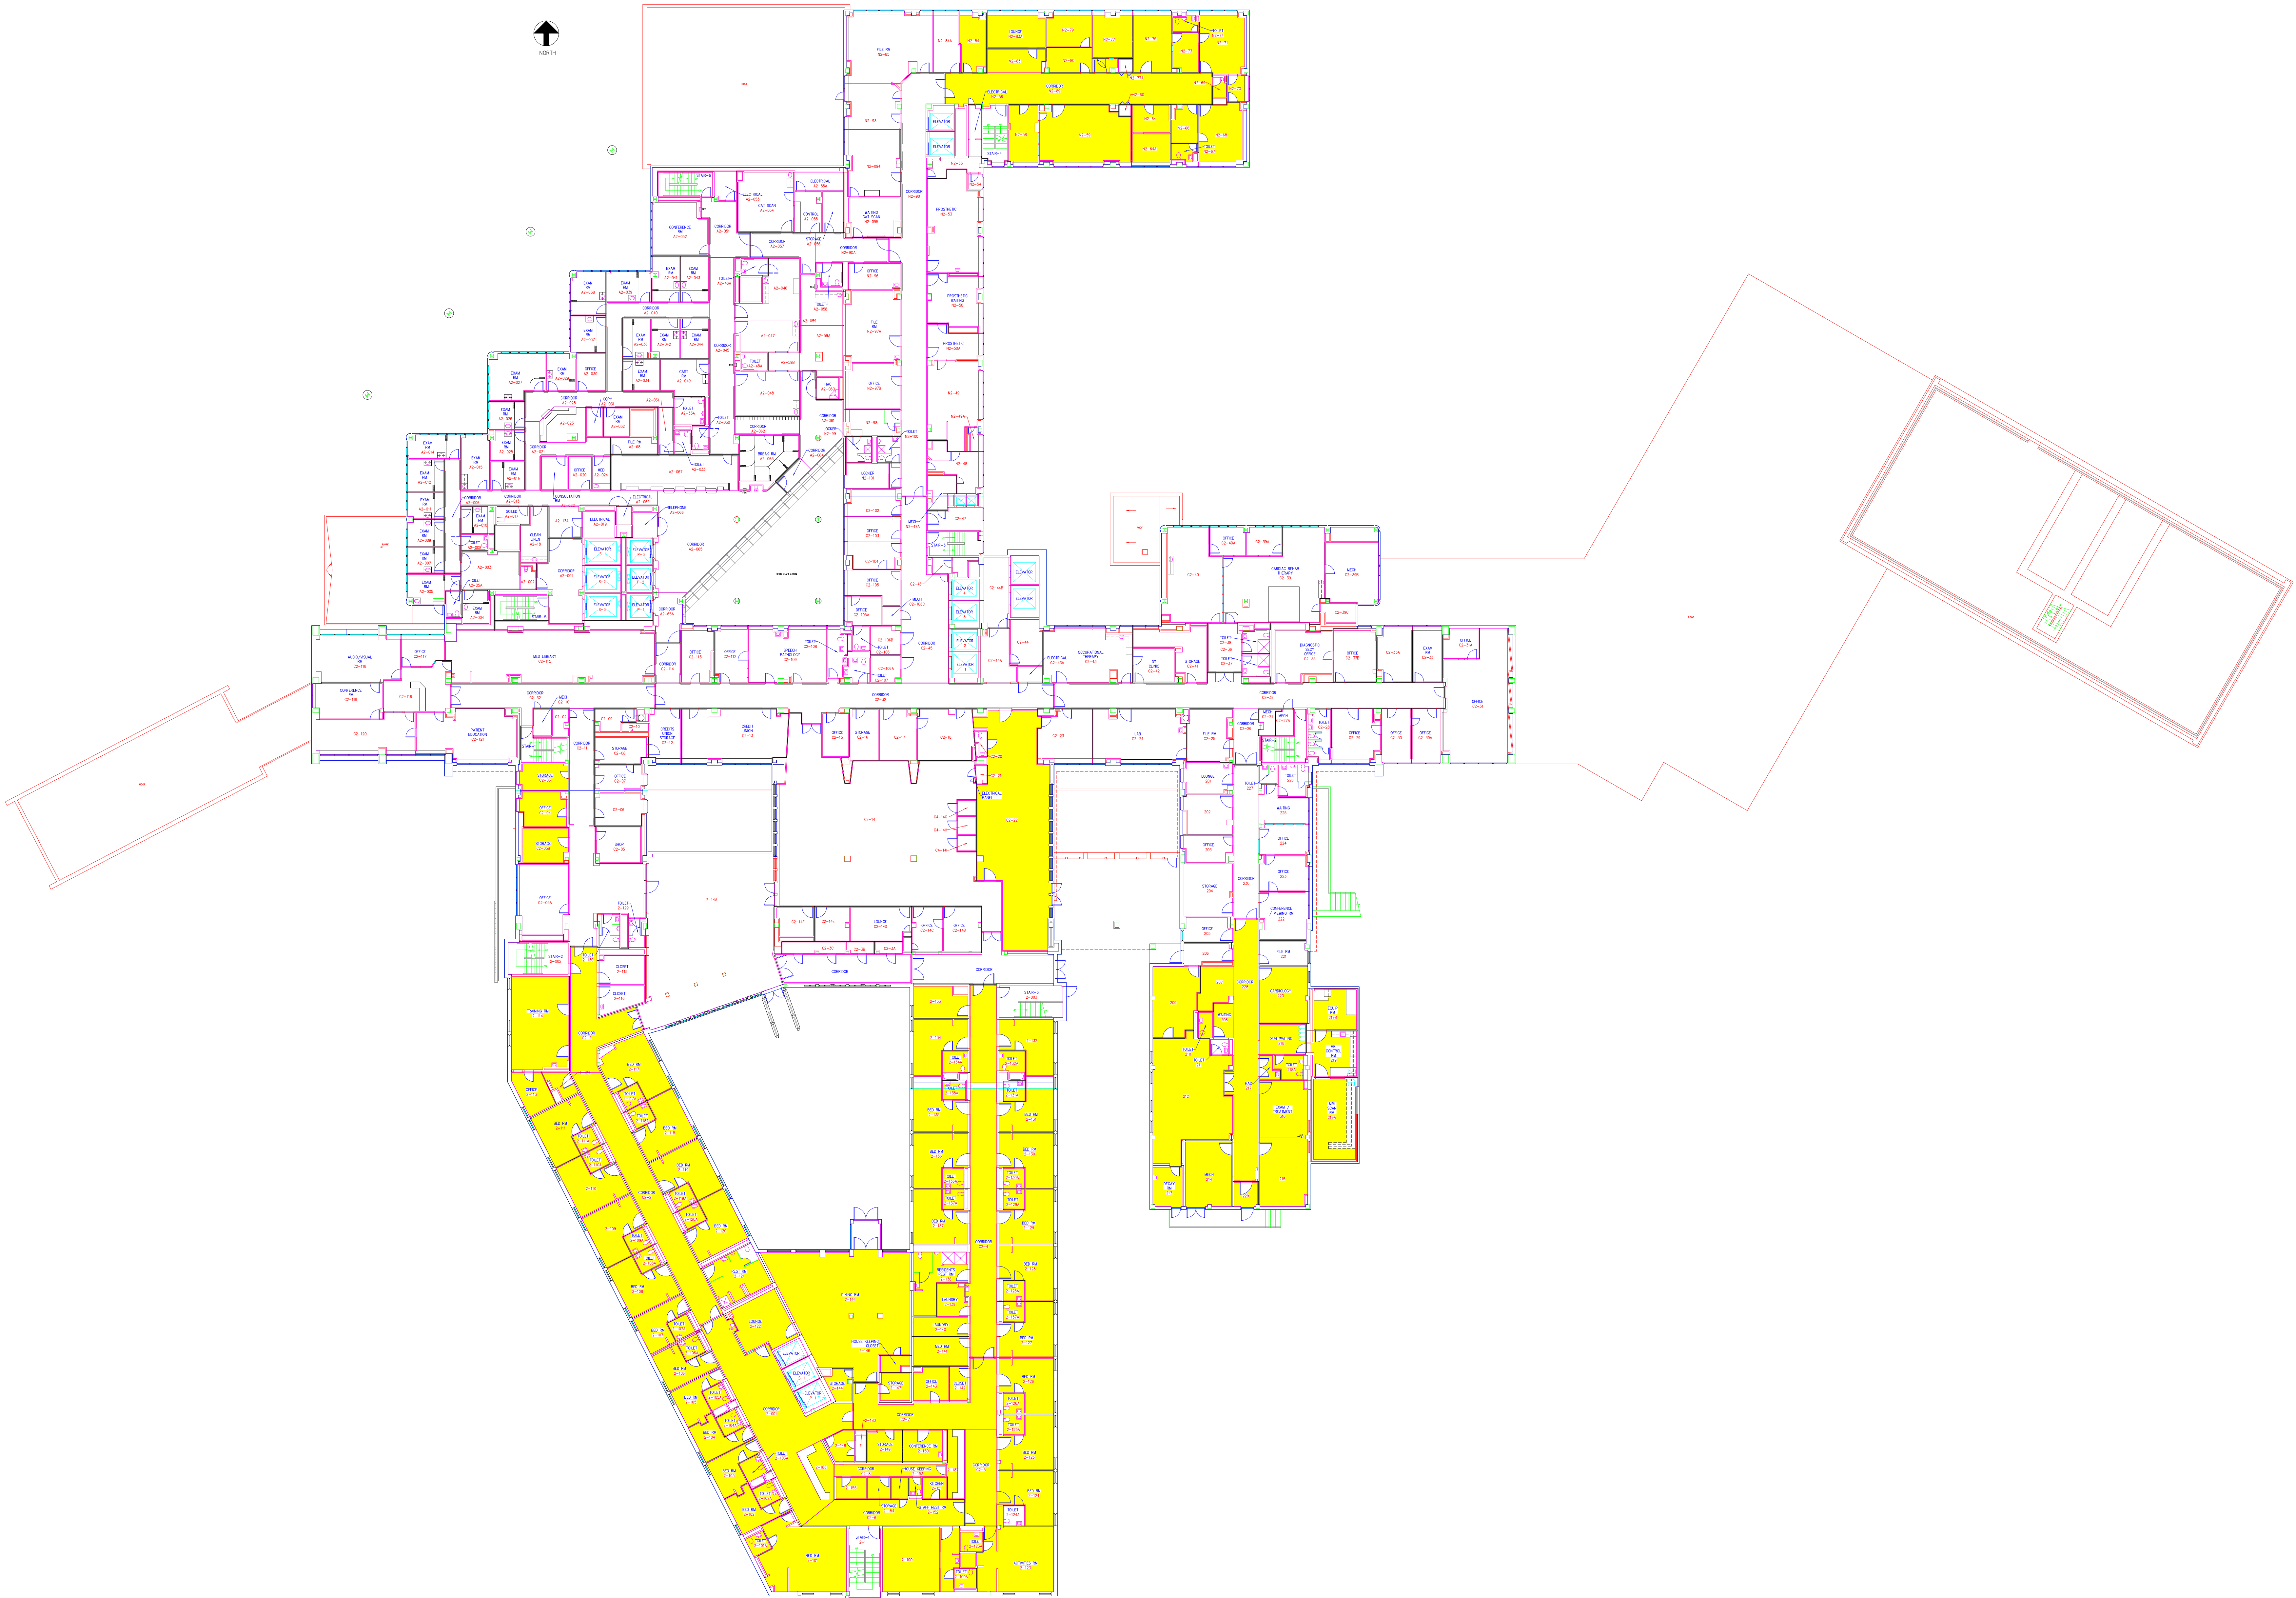
C

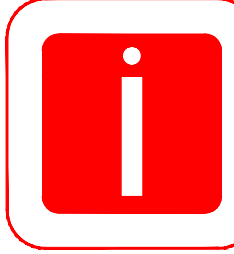
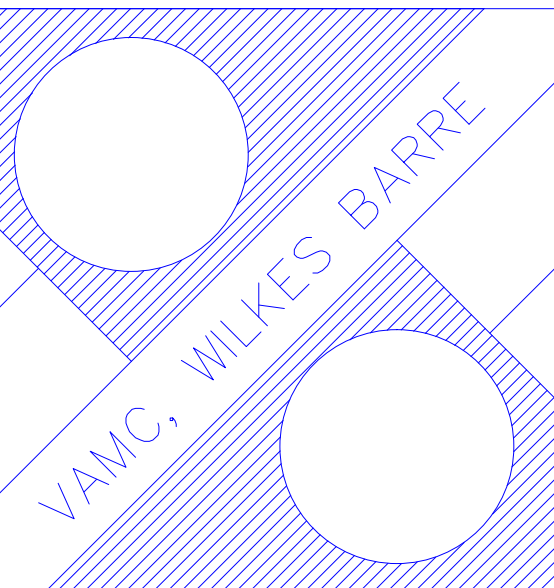
D

E

F

VA  
Department of  
Veterans Affairs



Revisions		Date		Professional Seal		<div><div><div>Indus Systems, Inc. 2352, Main Street, Concord MA 01742 Tel: 978-461-0555 www.indus-systems.com</div></div></div>		<div>Drawing Title SECOND FLOOR PLAN ARCHITECTURAL</div>		<div>Project Title AS-BUILT Drawings</div>		<div>Date 11-09-2010</div>		<div></div>	
Approved:		Approved:		<div>Building Number 01</div>		<div>Checked</div>		<div>Drawn</div>		<div>Drawing No.</div>					
Approved:		Approved:		<div>Location VAMC, WILKES BARRE PENNSYLVANIA</div>											