

A

B

C

D

E

F

1

2

3

4

5

6

7

8

9

A

B

C



D



E

F

1

one eighth inch = one foot
one quarter inch = one foot
three eighths inch = one foot
one half inch = one foot
three quarters inch = one foot
one inch = one foot
one and one half inches = one foot
three inches = one foot

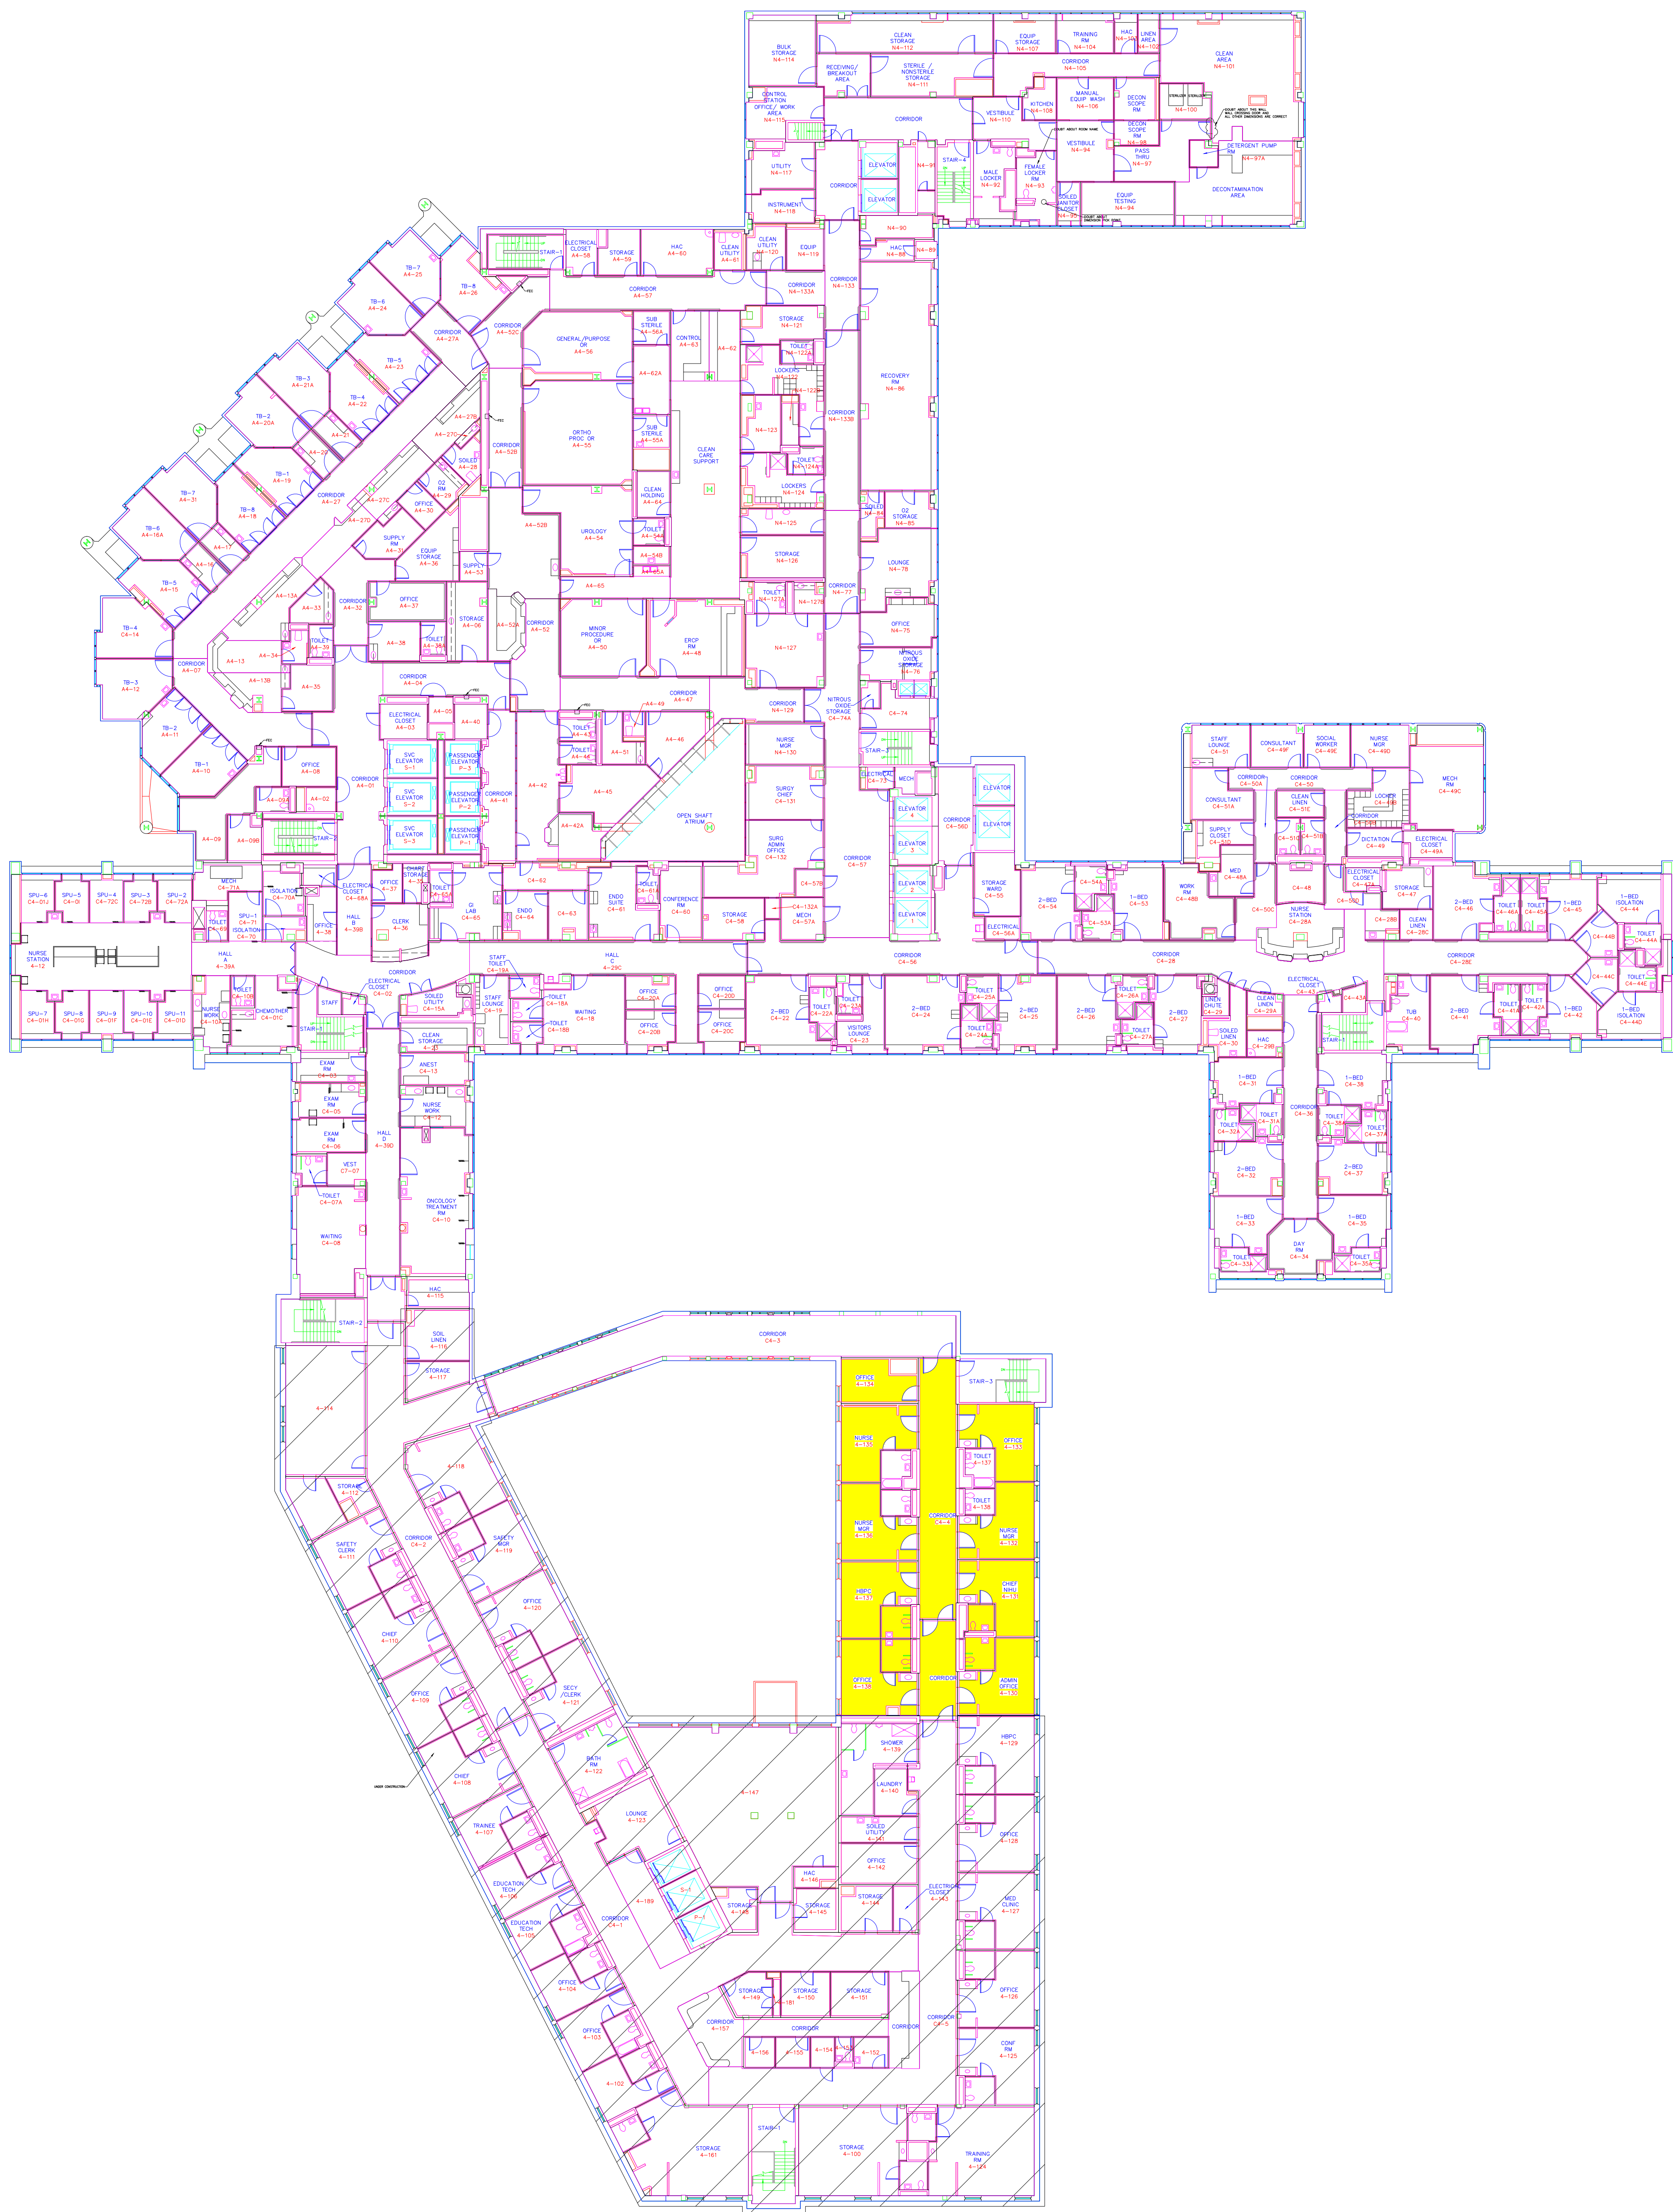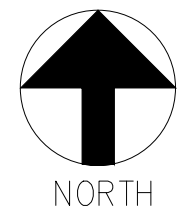

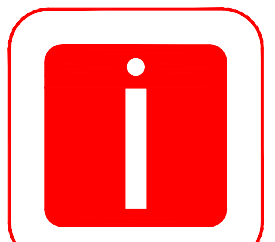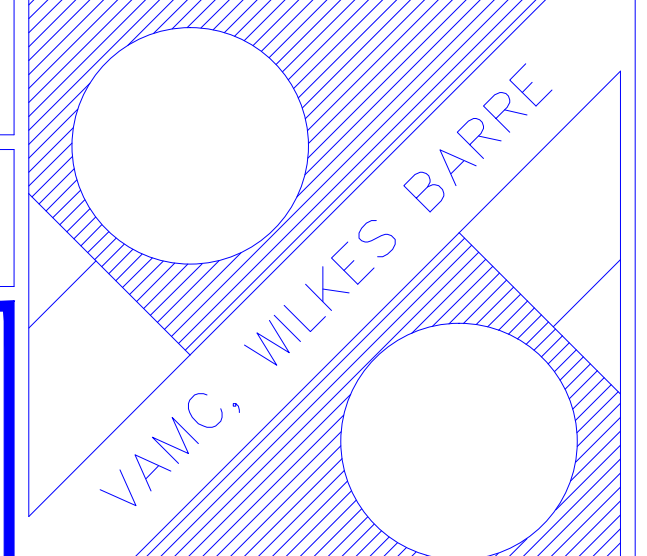Revisions		Date	Professional Seal		 Indus Systems, Inc. 2352, Main Street, Concord MA 01742 Tel: 978-461-0555 www.indus-systems.com		Drawing Title FOURTH FLOOR PLAN ARCHITECTURAL		Project Title AS-BUILT Drawings		Date 10-26-2010		 VAMC, WILKES BARRE		Department of Veterans Affairs		
						Approved:		Building Number 01		Checked	Drawn	Project No.					
						Approved:		Location VAMC WILKES BARRE PENNSYLVANIA				Drawing No.					