

A

B

C

D

E

F

A

B

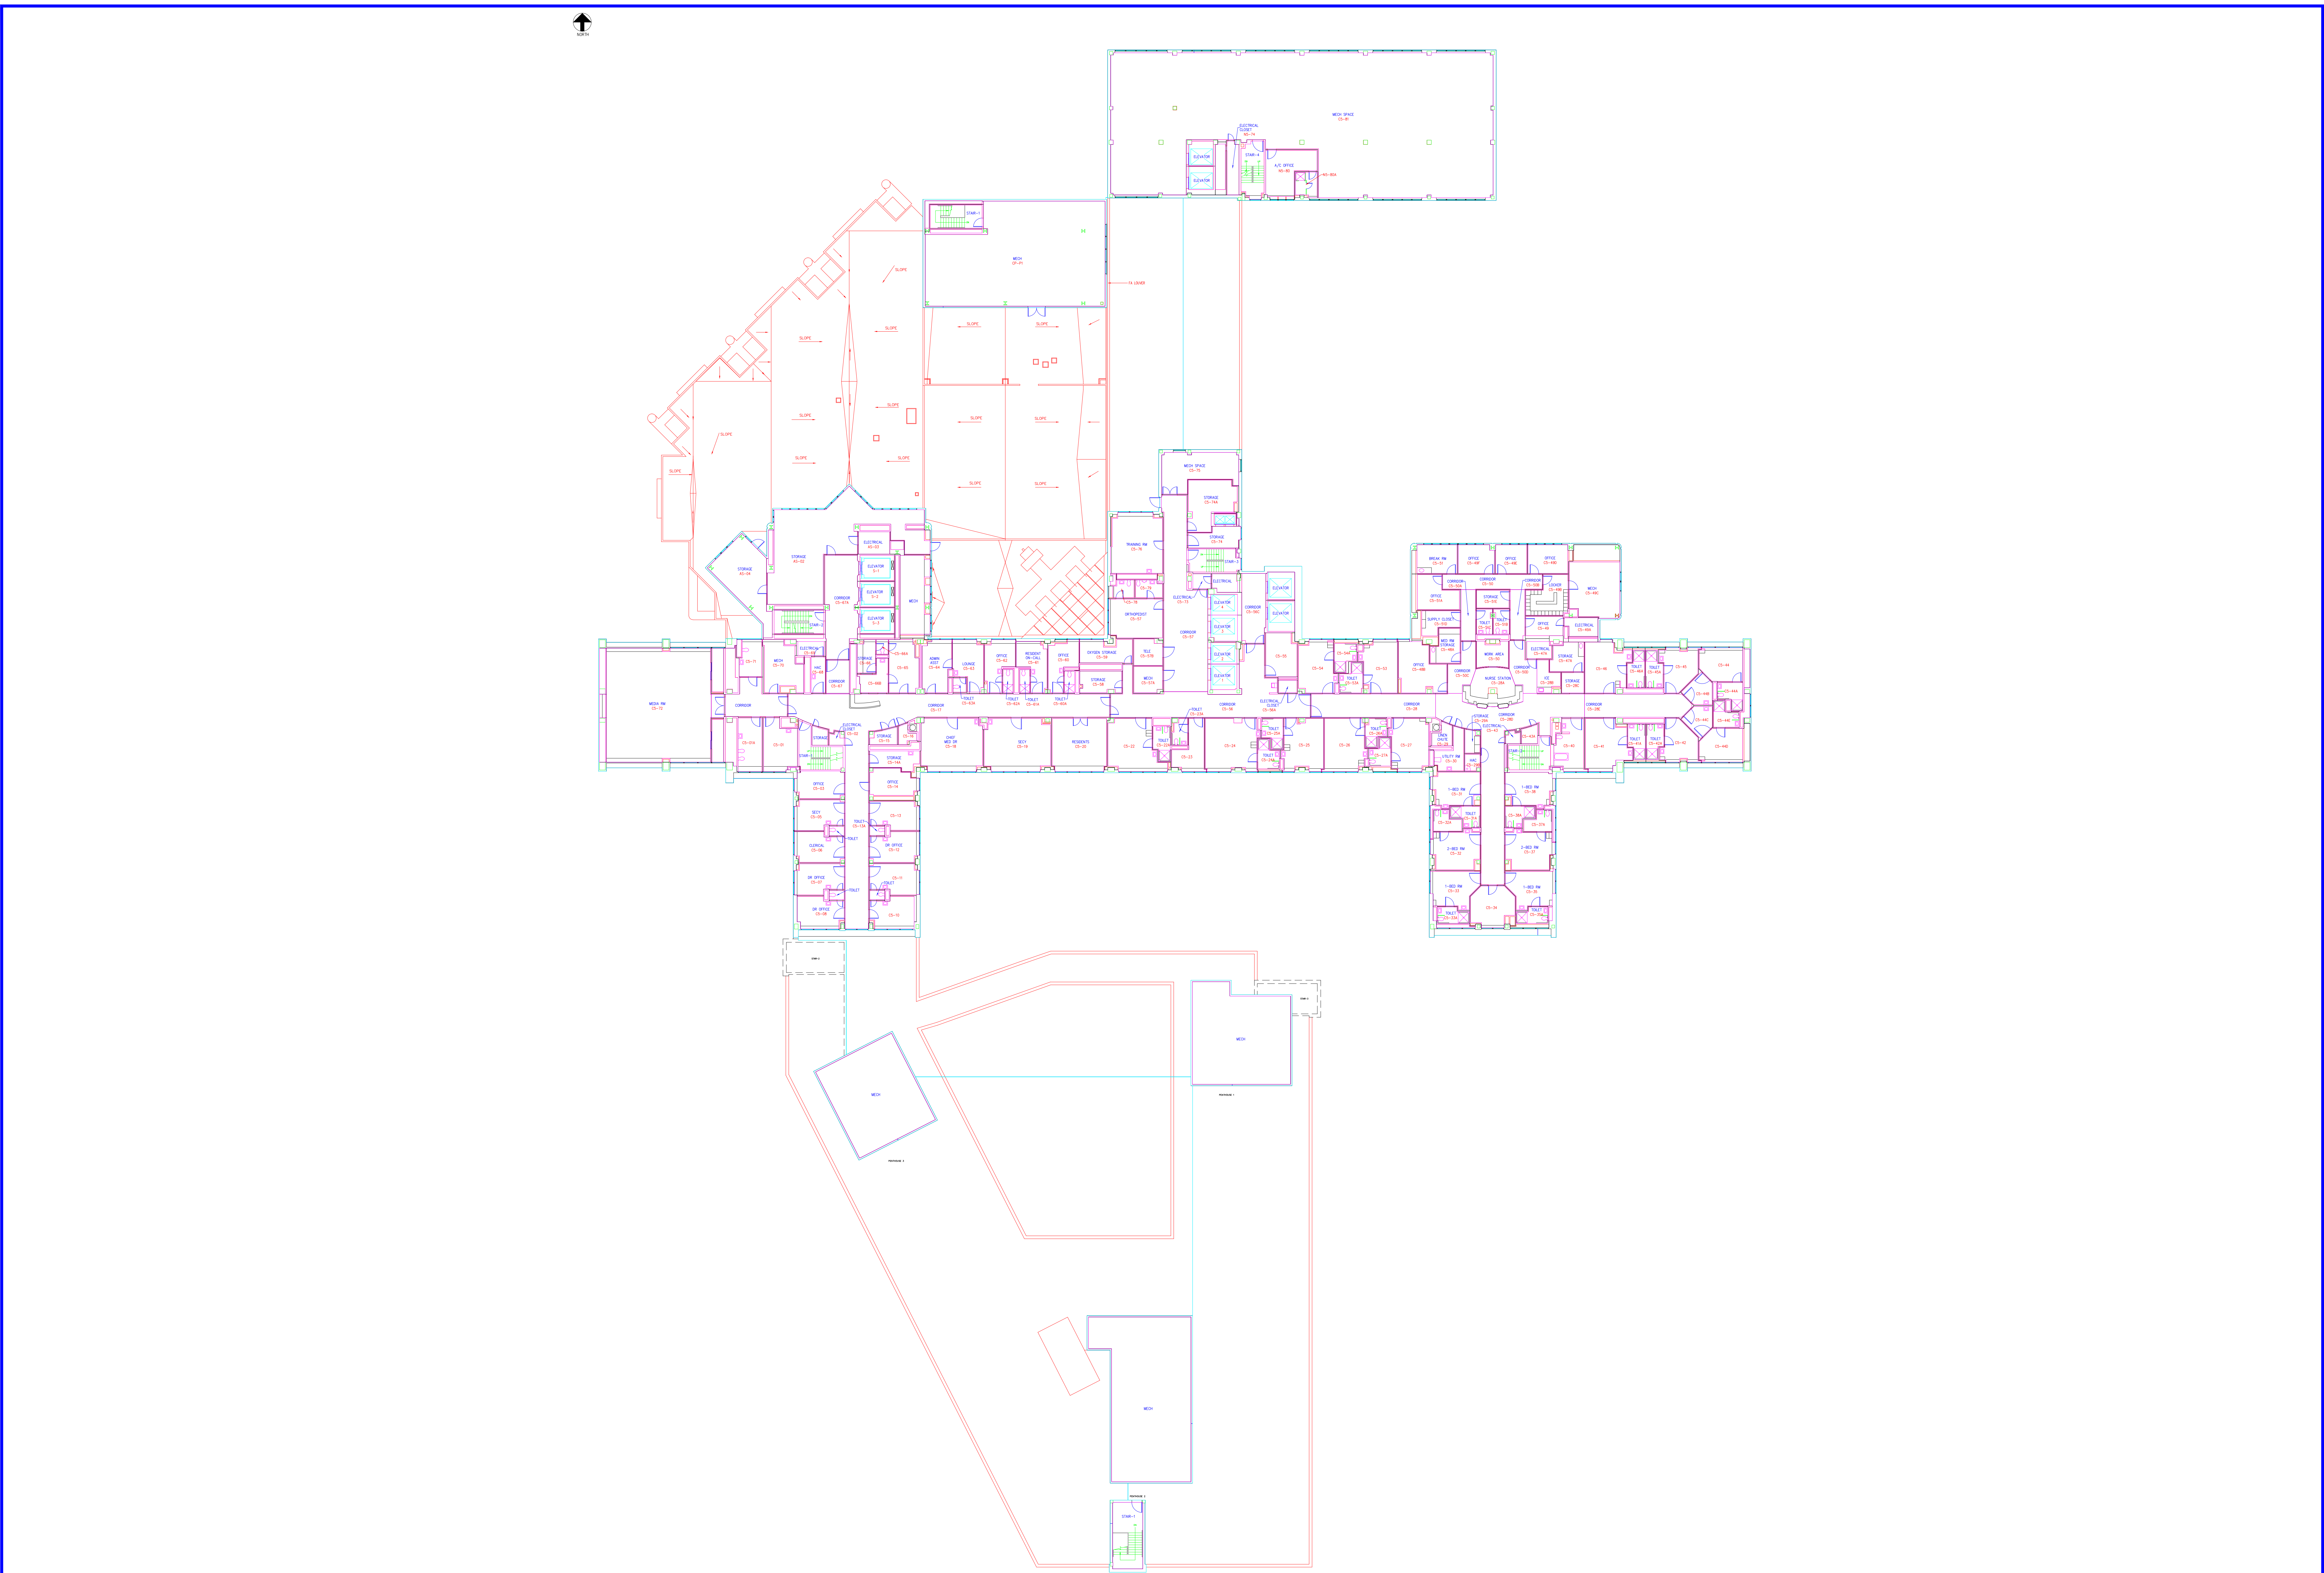
C

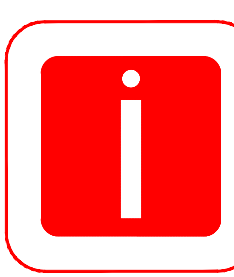
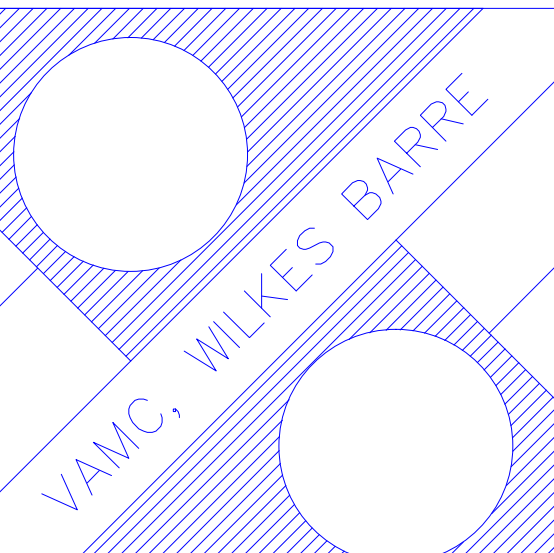
D

E

F

three eighths inch = one foot
one eighth inch = one foot
one quarter inch = one foot
three eighths inch = one foot
one half inch = one foot
one inch = one foot
one and one half inches = one foot
three inches = one foot



Revisions		Date	Professional Seal		 Indus Systems, Inc. 2352, Main Street, Concord MA 01742 Tel: 978-461-0555 www.indus-systems.com		Drawing Title FIFTH FLOOR PLAN ARCHITECTURAL		Project Title AS-BUILT Drawings		Date 10-27-2010				Project No.		VA Department of Veterans Affairs	
Approved:				Approved:		Building Number 01		Checked		Drawn		Drawing No.						
Approved:				Approved:		Location VAMC WILKES BARRE												