

A

B

C

D

E

F

1

A

B

C

D

E

F

1

three inches = one foot

one and one half inches = one foot

one inch = one foot

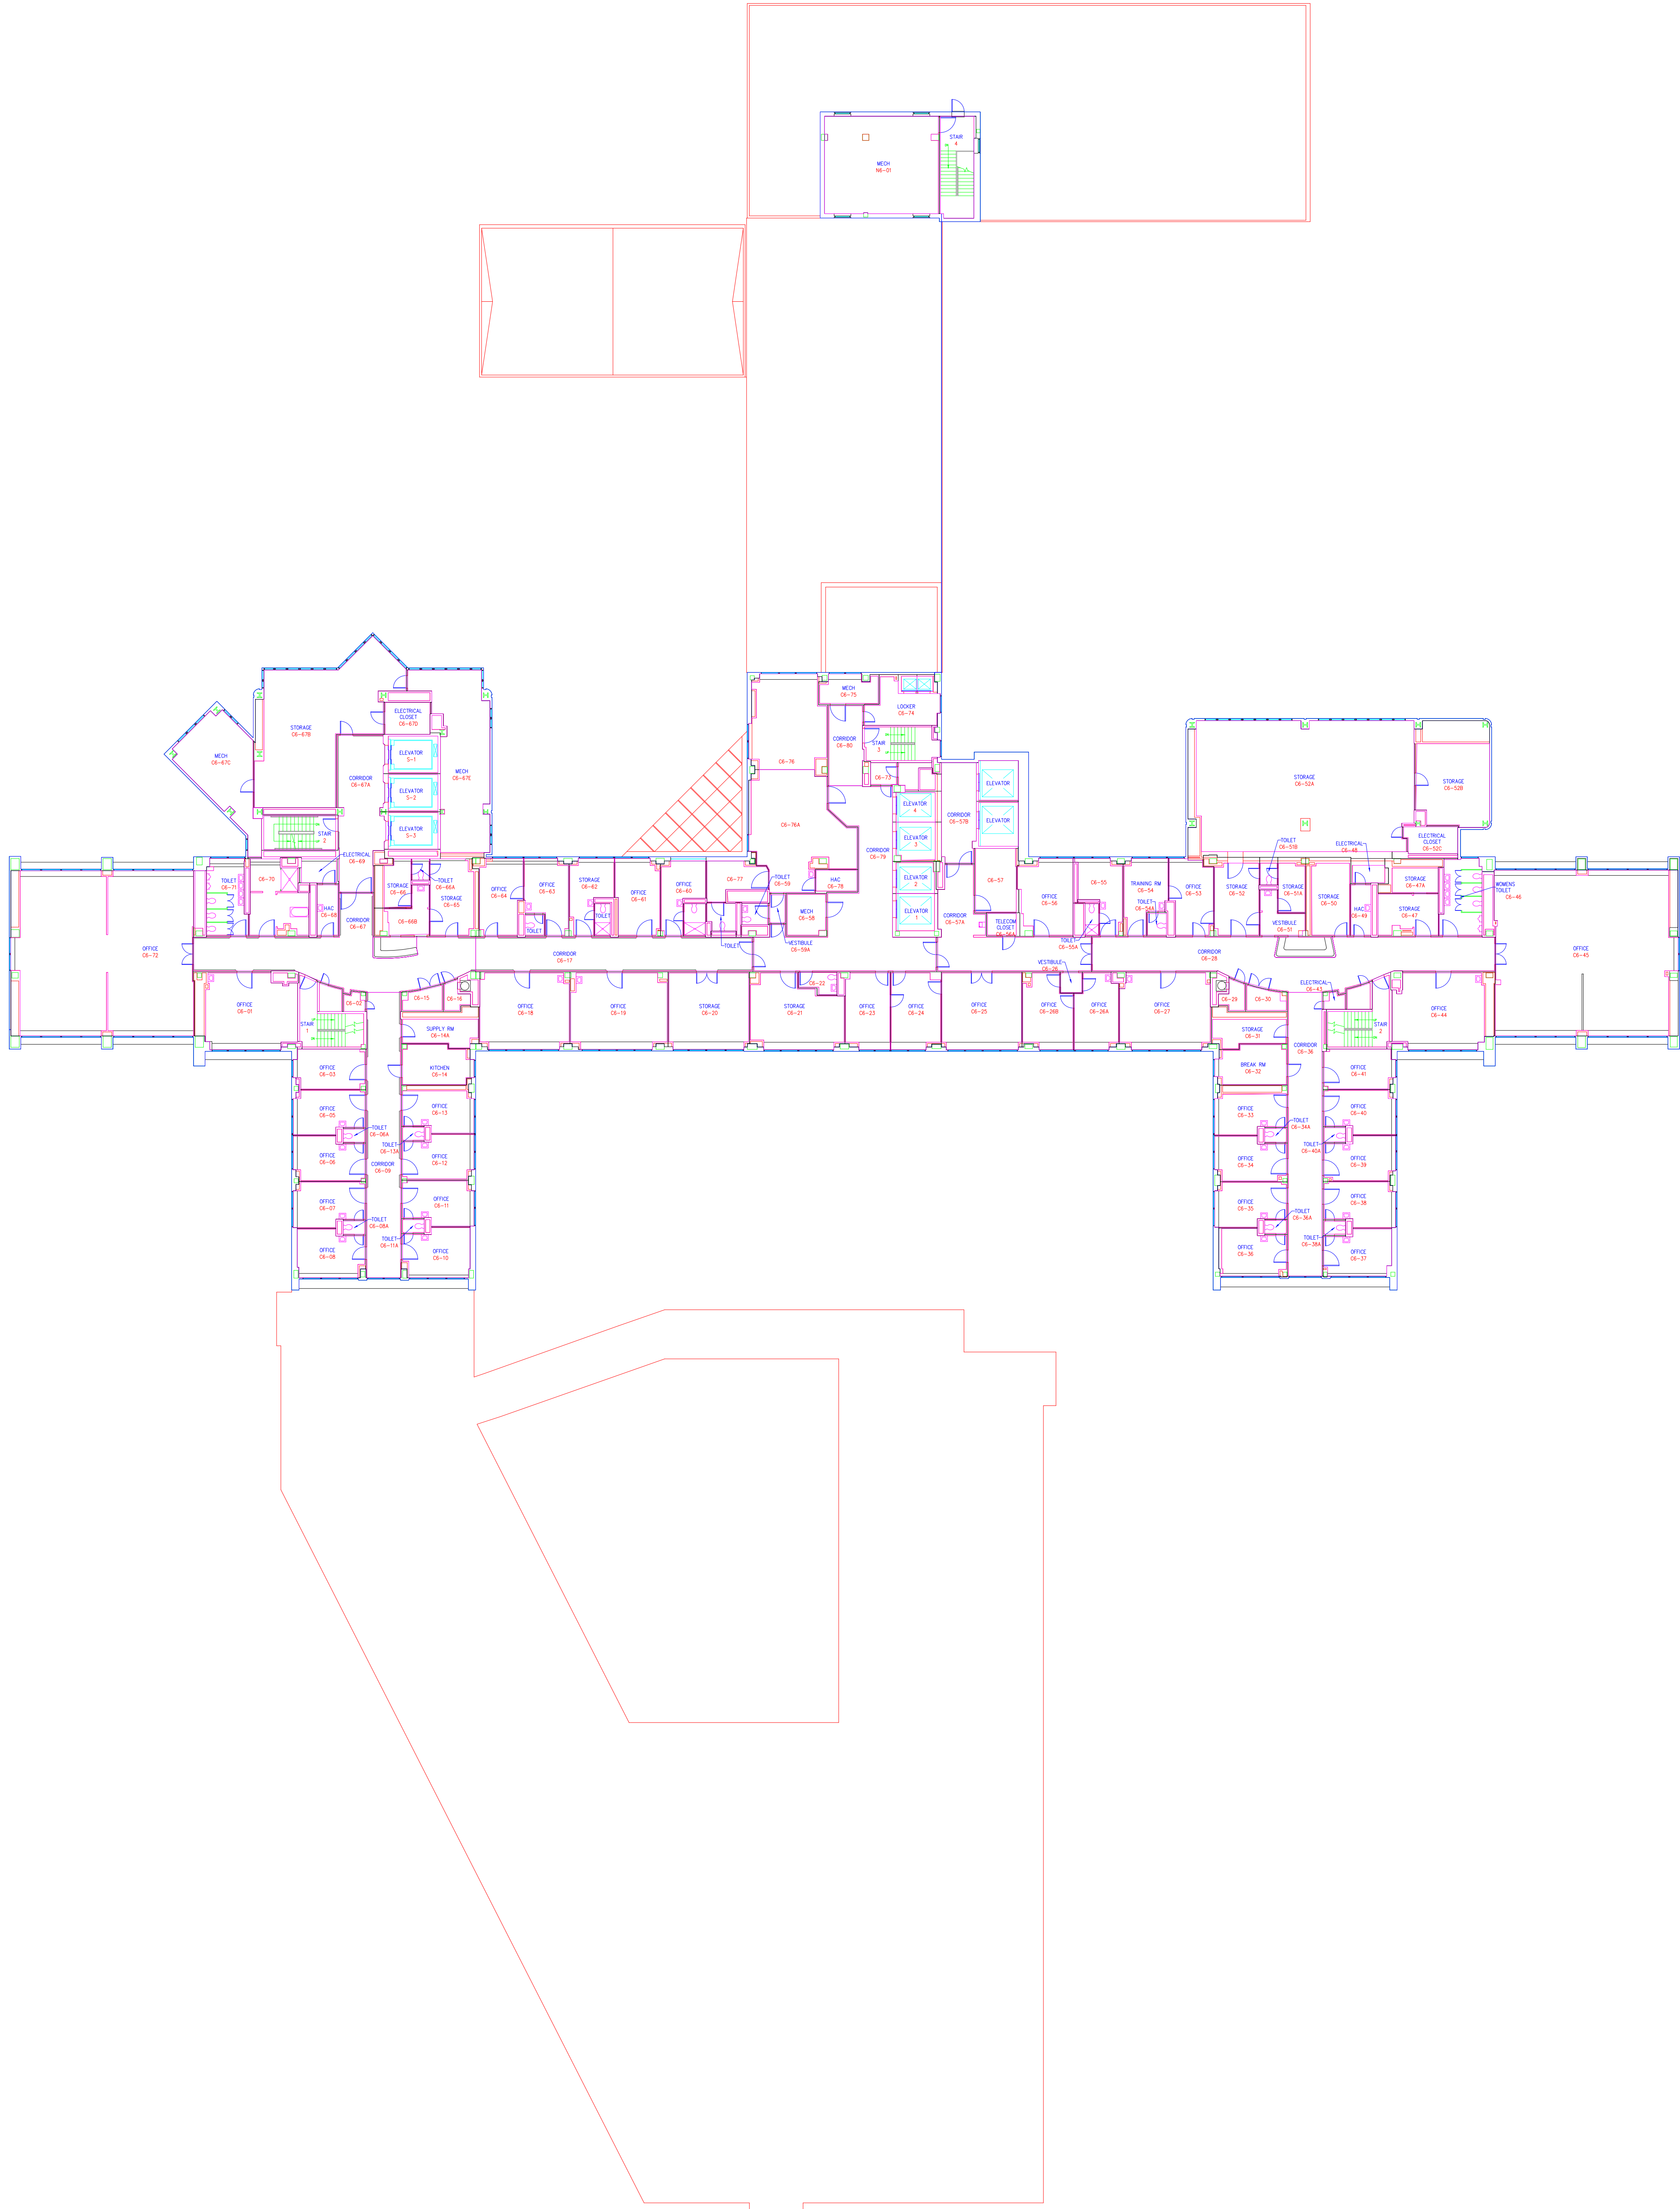
three quarters inch = one foot

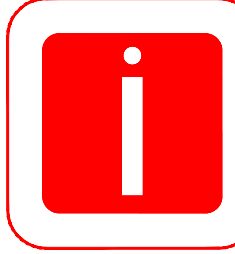
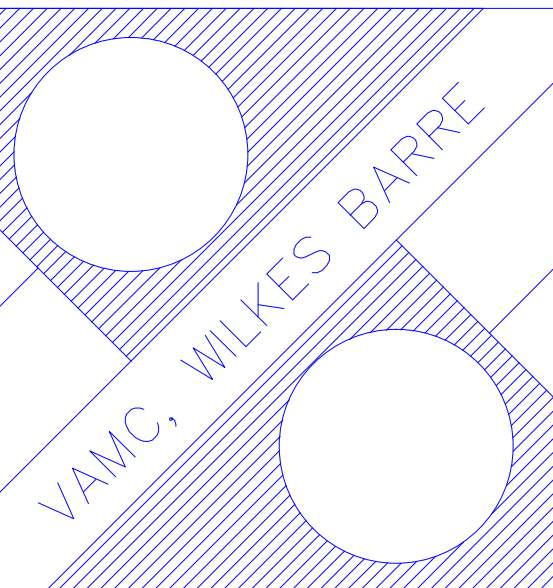
one half inch = one foot

three eighths inch = one foot

one quarter inch = one foot

one eighth inch = one foot



Revisions		Date	Professional Seal		 Indus Systems, Inc. 2352, Main Street, Concord MA 01742 Tel: 978-461-0555 www.indus-systems.com		Drawing Title SIXTH FLOOR PLAN ARCHITECTURAL		Project Title AS-BUILT Drawings		Date 10-27-2010				Project No.		Department of Veterans Affairs	
							Approved:		Building Number 01		Checked				Drawn		Drawing No.	
							Approved:		Location VAMC, WILKES BARRE PENNSYLVANIA									