

A

B

C

D

E

F

three inches = one foot
one and one half inches = one foot
one inch = one foot
three quarters inch = one foot
one half inch = one foot
three eighths inch = one foot
one quarter inch = one foot
one eighth inch = one foot



A

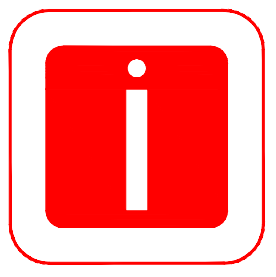
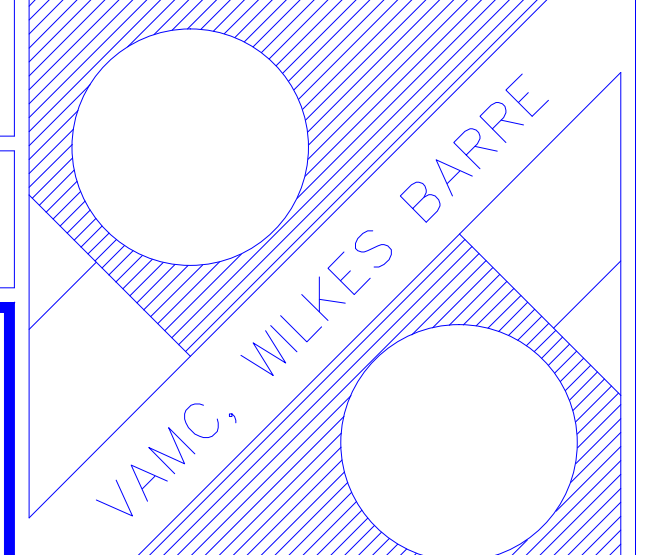
B

C

D

E

F

				 Indus Systems, Inc. 2352, Main Street, Concord MA 01742 Tel: 978-461-0555 www.indus-systems.com		Drawing Title EIGHTH FLOOR PLAN ARCHITECTURAL		Project Title AS-BUILT Drawings		Date 10-27-2010				VA Department of Veterans Affairs			
Approved:				Approved:		Building Number 01		Checked		Drawn						Project No.	
Approved:				Approved:		Location VAMC, WILKES BARRE PENNSYLVANIA				Drawing No.							
Revisions		Date		Professional Seal													